

# Appendix A

# **Background Information**

## HAGER-RAMBO FLOOD CONTROL WORKS OPERATIONS AND MAINTENANCE MANUAL

## CITY OF BURLINGTON HALTON REGION CONSERVATION AUTHORITY

December 1997

Philips Planning and Engineering Limited 3215 North Service Road Burlington, Ontario L7R 3Y2

> Telephone: (905) 335-2353 Fax: (905) 335-1414

## TABLE OF CONTENTS

| Sect   | <u>tion</u> | <u>Pa</u>   | age  |  |  |  |  |  |  |
|--|-------------|---|--|--|--|--|--|--|--|
| 1.   | INTI        | ODUCTION  | 1  |  |  |  |  |  |  |
| 2.   | EAS         | CRAMBO CREEK CHANNELIZATION (Queensway Drive to CNR-Oakville) | 3  |  |  |  |  |  |  |
|  | 2.1         | Project Description and Year of Construction                  |  |  |  |  |  |  |  |
|  | 2.2         | Project Location  |  |  |  |  |  |  |  |
|  | 2.3         | Design Objectives and Criteria                                |  |  |  |  |  |  |  |
|  | 2.4         | As-Built Construction Drawings                                |  |  |  |  |  |  |  |
|  | 2.5         | Photographic Reconnaissance                                   |  |  |  |  |  |  |  |
|  | 2.6         | Operations and Maintenance                                    |  |  |  |  |  |  |  |
|  |             | 2.6.1 Ownership Status  |  |  |  |  |  |  |  |
|  |             | 2.6.2 Project Ingress and Egress                              |  |  |  |  |  |  |  |
|  |             | 2.6.3 Project Element Maintenance                             |  |  |  |  |  |  |  |
| Section<br>1.<br>2.<br>3.<br>4.  | LOW         | ER EAST RAMBO CREEK CHANNELIZATION                            |  |  |  |  |  |  |  |
|  |             | (CNR-Oakville to Fairview St.)                                | .13  |  |  |  |  |  |  |
|  | 3.1         | Project Description and Year of Construction                  | .13  |  |  |  |  |  |  |
|  | 3.2         | Project Location  | .13  |  |  |  |  |  |  |
|  | 3.3         | Design Objectives and Criteria                                | .13  |  |  |  |  |  |  |
|  | 3.4         | As-Built Construction Drawing14                               |  |  |  |  |  |  |  |
|  | 3.5         | Photographic Reconnaissance                                   |  |  |  |  |  |  |  |
|  | 3.6         | Operations and Maintenance                                    | .16  |  |  |  |  |  |  |
|  |             | 3.6.1 Ownership Status  | .16  |  |  |  |  |  |  |
|  |             | 3.6.2 Project Ingress and Egress                              |  |  |  |  |  |  |  |
|  |             | 3.6.3 Project Element Maintenance                             | .17  |  |  |  |  |  |  |
| 4.   | EAS         | CHAGER CREEK CHANNELIZATION (Fairview Street to CNR -Halton)  |  |  |  |  |  |  |  |
|  | 4.1         | Project Description and Year of Construction                  |  |  |  |  |  |  |  |
| 4.   | 4.2         | Project Location  | .19  |  |  |  |  |  |  |
|  | 4.3         | Design Objectives and Criteria                                |  |  |  |  |  |  |  |
|  | 4.4         | As-Built Construction Drawings                                |  |  |  |  |  |  |  |
|  | 4.5         | Photographic Reconnaissance                                   | .22  |  |  |  |  |  |  |
|  | 4.6         | Operations and Maintenance                                    |  |  |  |  |  |  |  |
|  |             | 4.6.1 Ownership Status  |  |  |  |  |  |  |  |
|  |             | 4.6.2 Project Ingress and Egress                              |  |  |  |  |  |  |  |
|  |             | 4.6.3 Project Element Maintenance                             | .23  |  |  |  |  |  |  |
| 5.   |             | HAGER CREEK (CNR Halton Culvert Crossing)                     |  |  |  |  |  |  |  |
|  | 5.1         | Project Description and Year of Construction                  |  |  |  |  |  |  |  |
|  | 5.2         | Project Location  | 3<br>4<br>7<br>10<br>10<br>10<br>10<br>10<br>10<br>10<br>10<br>10<br>10<br>11<br>13<br>13<br>13<br>13<br>13<br>13<br>13<br>13<br>14<br>16<br>16<br>16<br>16<br>16<br>17<br>19<br>19<br>19<br>19<br>19<br>19<br>19<br>19<br>123<br>23<br>23<br>25<br>25<br>26<br>27 |  |  |  |  |  |  |
| 5.   | 5.3         | Design Objectives and Criteria                                |  |  |  |  |  |  |  |
|  | 5.4         | As-Built Construction Drawings                                |  |  |  |  |  |  |  |
| 1. $\mathbf{I}$<br>2. $\mathbf{E}$<br>2. $2$<br>2. $2$<br>2. $2$<br>3. $\mathbf{L}$<br>3. $\mathbf{L}$<br>4. $\mathbf{E}$<br>4. $\mathbf{E}$<br>5. $\mathbf{E}$<br>5. $\mathbf{E}$<br>5. $5$<br>5. $5$ | 5.5         | Photographic Reconnaissance                                   |  |  |  |  |  |  |  |
|  | 5.6         | Operations and Maintenance                                    | .28  |  |  |  |  |  |  |

|    |     | 5.6.1                            | Ownership Status                          |    |  |  |  |  |
|----|-----|----------------------------------|---|----|--|--|--|--|
|    |     | 5.6.2                            | Project Ingress and Egress                |    |  |  |  |  |
|    |     | 5.6.3                            | Project Element Maintenance               |    |  |  |  |  |
| 6. | EAS | T HAGE                           | R CREEK CHANNELIZATION                    |    |  |  |  |  |
|    | 6.1 | Project                          | t Description and Year of Construction    | 30 |  |  |  |  |
|    | 6.2 | Project                          | t Location                                | 30 |  |  |  |  |
|    | 6.3 | Design                           | n Objectives and Criteria                 | 30 |  |  |  |  |
|    | 6.4 | As-Bu                            | ilt Construction Drawings                 | 31 |  |  |  |  |
|    | 6.5 |                                  | graphic Reconnaissance                    |    |  |  |  |  |
|    | 6.6 | 1                                | tions and Maintenance                     |    |  |  |  |  |
|    |     | 6.6.1                            | Ownership Status                          | 37 |  |  |  |  |
|    |     | 6.6.2                            | Project Ingress and Egress                |    |  |  |  |  |
|    |     | 6.6.3                            | Project Element Maintenance               | 37 |  |  |  |  |
| 7. | FRE | EMAN D                           | DETENTION FACILITY AND                    |    |  |  |  |  |
|    | EAS | T HAGE                           | R CREEK CHANNELIZATION                    |    |  |  |  |  |
|    | 7.1 |                                  | t Description and Year of Construction    |    |  |  |  |  |
|    | 7.2 |                                  | t Location                                |    |  |  |  |  |
|    | 7.3 | 0                                | n Objectives and Criteria                 |    |  |  |  |  |
|    | 7.4 | As-Built Construction Drawings40 |   |    |  |  |  |  |
|    | 7.5 | Photographic Reconnaissance41    |   |    |  |  |  |  |
|    | 7.6 | -                                | tions and Maintenance                     |    |  |  |  |  |
|    |     | 7.6.1                            | 1   |    |  |  |  |  |
|    |     | 7.6.2                            | 5 0 0                                     |    |  |  |  |  |
|    |     | 7.6.3                            | Project Element Maintenance               | 45 |  |  |  |  |
| 8. |     |                                  | R CREEK REALIGNMENT AND POND SYSTEM       |    |  |  |  |  |
|    | 8.1 |                                  | t Description and Year of Construction    |    |  |  |  |  |
| 8. | 8.2 | 5                                | t Location                                |    |  |  |  |  |
|    | 8.3 |                                  | n Objectives and Criteria                 |    |  |  |  |  |
|    | 8.4 |                                  | ilt Construction Drawing                  |    |  |  |  |  |
|    | 8.5 |                                  | graphic Reconnaissance                    |    |  |  |  |  |
|    | 8.6 | 1                                | tions and Maintenance                     |    |  |  |  |  |
|    |     | 8.6.1                            | Ownership Status                          |    |  |  |  |  |
|    |     | 8.6.2                            | Project Ingress and Egress                |    |  |  |  |  |
|    |     | 8.6.3                            | Project Element Maintenance               | 51 |  |  |  |  |
| 9. | EAS | T HAGE                           | R CREEK RECONSTRUCTION                    |    |  |  |  |  |
|    | 0.1 | р і                              | (North Service Rd. to Future Highway 407) |    |  |  |  |  |
|    | 9.1 |                                  | t Description and Year of Construction    |    |  |  |  |  |
|    | 9.2 | 5                                | t Location                                |    |  |  |  |  |
|    | 9.3 | -                                | 1 Objectives and Criteria                 |    |  |  |  |  |
|    | 9.4 |                                  | ilt Construction Drawing                  |    |  |  |  |  |
|    | 9.5 | Photog                           | graphic Reconnaissance                    | 55 |  |  |  |  |

|     | 9.6  | Operations and Maintenance                   | 58 |  |  |  |  |
|-----|------|--|----|--|--|--|--|
|     |      | 9.6.1 Ownership Status                       | 58 |  |  |  |  |
|     |      | 9.6.2 Project Ingress and Egress             |    |  |  |  |  |
|     |      | 9.6.3 Project Element Maintenance            |    |  |  |  |  |
| 10. | WEST | HAGER DETENTION FACILITY                     | 60 |  |  |  |  |
|     | 10.1 | Project Description and Year of Construction |    |  |  |  |  |
|     | 10.2 | Project Location                             | 60 |  |  |  |  |
|     | 10.3 | Design Objectives and Criteria               | 60 |  |  |  |  |
|     | 10.4 | As-Built Construction Drawing                |    |  |  |  |  |
|     | 10.5 | Photographic Reconnaissance.                 |    |  |  |  |  |
|     | 10.6 | Operations and Maintenance                   |    |  |  |  |  |
|     |      | 10.6.1 Ownership Status                      |    |  |  |  |  |
|     |      | 10.6.2 Project Ingress and Egress            |    |  |  |  |  |
|     |      | 10.6.3 Project Element Maintenance           |    |  |  |  |  |

## **APPENDICES**

| Appendix 'A' | Property Plans            |
|--------------|---------------------------|
| Appendix 'B' | Standard Inspection Form  |
| Appendix 'C' | 1997 Field Reconnaissance |
| Appendix 'D' | 1998 Aerial Photographs   |

## HAGER-RAMBO FLOOD CONTROL WORKS

## Operations and Maintenance Manual City of Burlington Halton Region Conservation Authority

#### 1. <u>Introduction</u>

The Hager-Rambo flood control system has been constructed as part of a multi-proponent initiative involving the City of Burlington, Halton Region Conservation Authority and Ministry of Transportation. The first works towards this system, the East Rambo Creek channelization were constructed in 1986/87. Two key components, as of the time of writing, have not yet been constructed, namely the East Rambo Flood Control facility and the Highway 407 diversion system. All other components are in-place and described in detail in this document.

The intent of this manual is to provide City staff, who now have the responsibility of operations and maintenance of the flood control system, with a reference tool for the work's design principles and features. The manual describes the operation and maintenance considerations associated with each flood control element.


The works include:

- 1) East Rambo Creek Channelization (Queensway Drive to CNR Oakville)
- 2) Lower East Rambo Creek Channelization (CNR Oakville to Fairview Street)
- 3) East Hager Creek Channelization (CNR to Fairview Street)
- 4) East Hager Creek (CNR Crossing)
- 5) East Hager Creek Channelization (CNR to Freeman Pond)
- 6) Freeman Detention Facility
- 7) East Hager Creek Realignment and Pond System (Q.E.W. to North Service Road)
- 8) East Hager Creek Reconstruction (North Service Road to Future 407 (West))
- 9) West Hager Detention Facility

Figure 1 depicts the location of the respective works within the Hager-Rambo system in the City of Burlington.

Aerial photographs were taken in 1998, to supplement the ground level photographs taken in 1997 (ref. Appendix D)

Appendix B provides a standard inspection form along with Operation and Maintenance Schedule. As has been generally recommended in this manual, the works should be inspected either once or twice a year. This inspection can take the form of a quick "walk through", examining the works for "obvious" problems. Every five years a more detailed inspection should be undertaken whereby each component element of the works is inspected to ensure its safe and continued operation. A detailed photographic log should be taken at 5 year intervals and added to this manual.

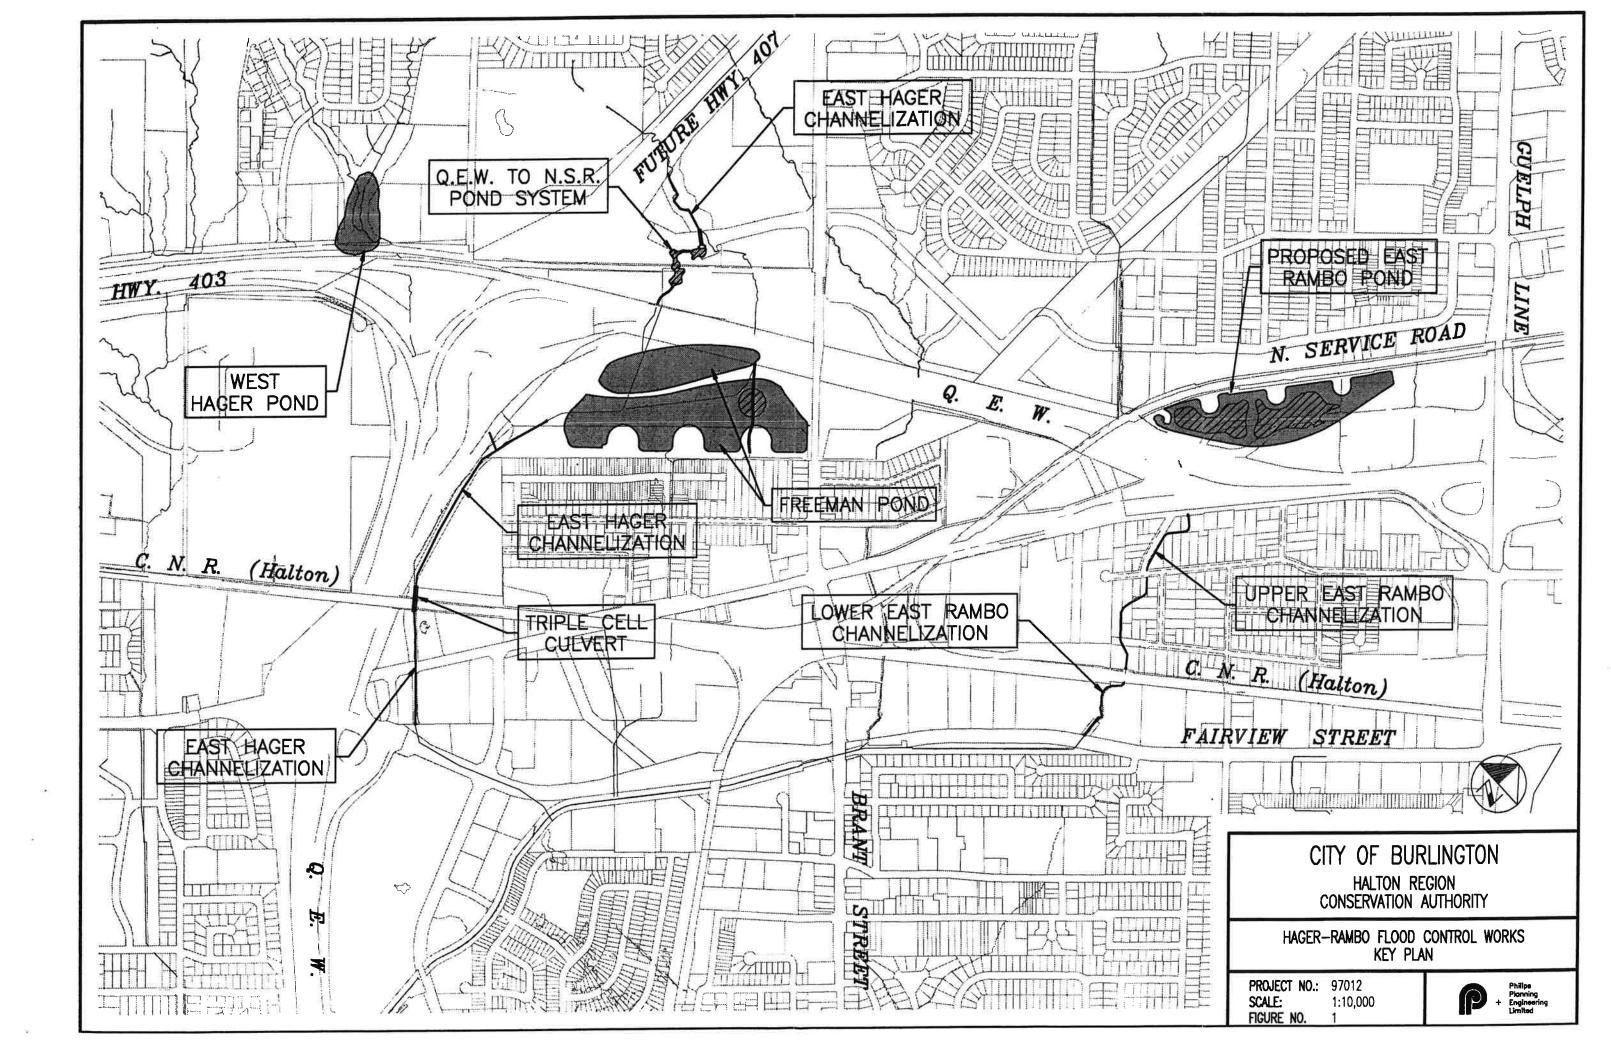

## 2. East Rambo Creek Channelization (Queensway Drive to CNR-Oakville)

## 2.1 Project Description and Year of Construction

East Rambo Creek Channelization

Queensway Drive to CNR - Oakville

Constructed from September 1986 to June 1987.

This project involved the realignment and lining of the East Rambo Creek. A 650 metre long concrete lined invert with two courses of gabion baskets approximately 3.2 m +/- top width, a precast culvert replacement at Glenwood School Drive, and the lowering and re-lining of the CNR-Oakville culvert crossing, were all components of this project undertaking.

## 2.2 **Project Location**

The project site is located halfway between Guelph Line and Brant Street, with the upstream limits beginning at Queensway Drive extending through the residential community of Queensway to downstream of the CNR – Oakville crossing, approximately 120 m north of Fairview Street.





## 2.3 Design Objectives and Criteria

The channel works were designed to the "controlled" 100 year future land use peak flow to be regulated by the proposed East Rambo Detention facility to 15.0  $m^3/s$  +/- at Queensway Drive. Design levels during a 100 year event average 1.3 metres, with a 0.3 metre freeboard.

**Note:** While considered at the time of design, protection to the Regulatory standard (Hurricane Hazel) was not attainable due to insufficient land and storage, within the East Rambo Creek watershed.


3

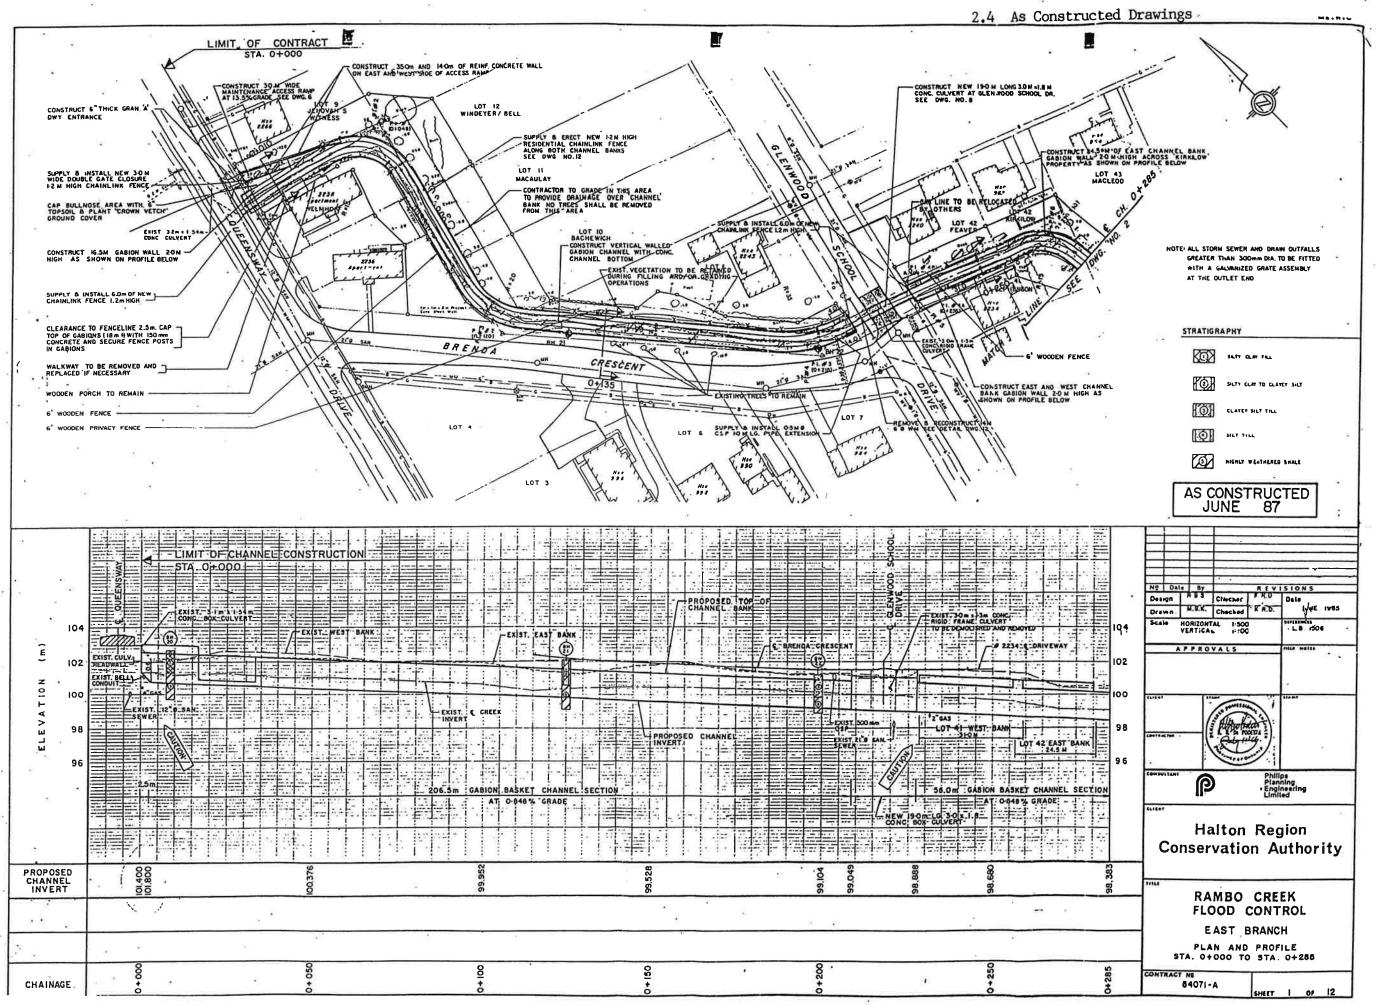

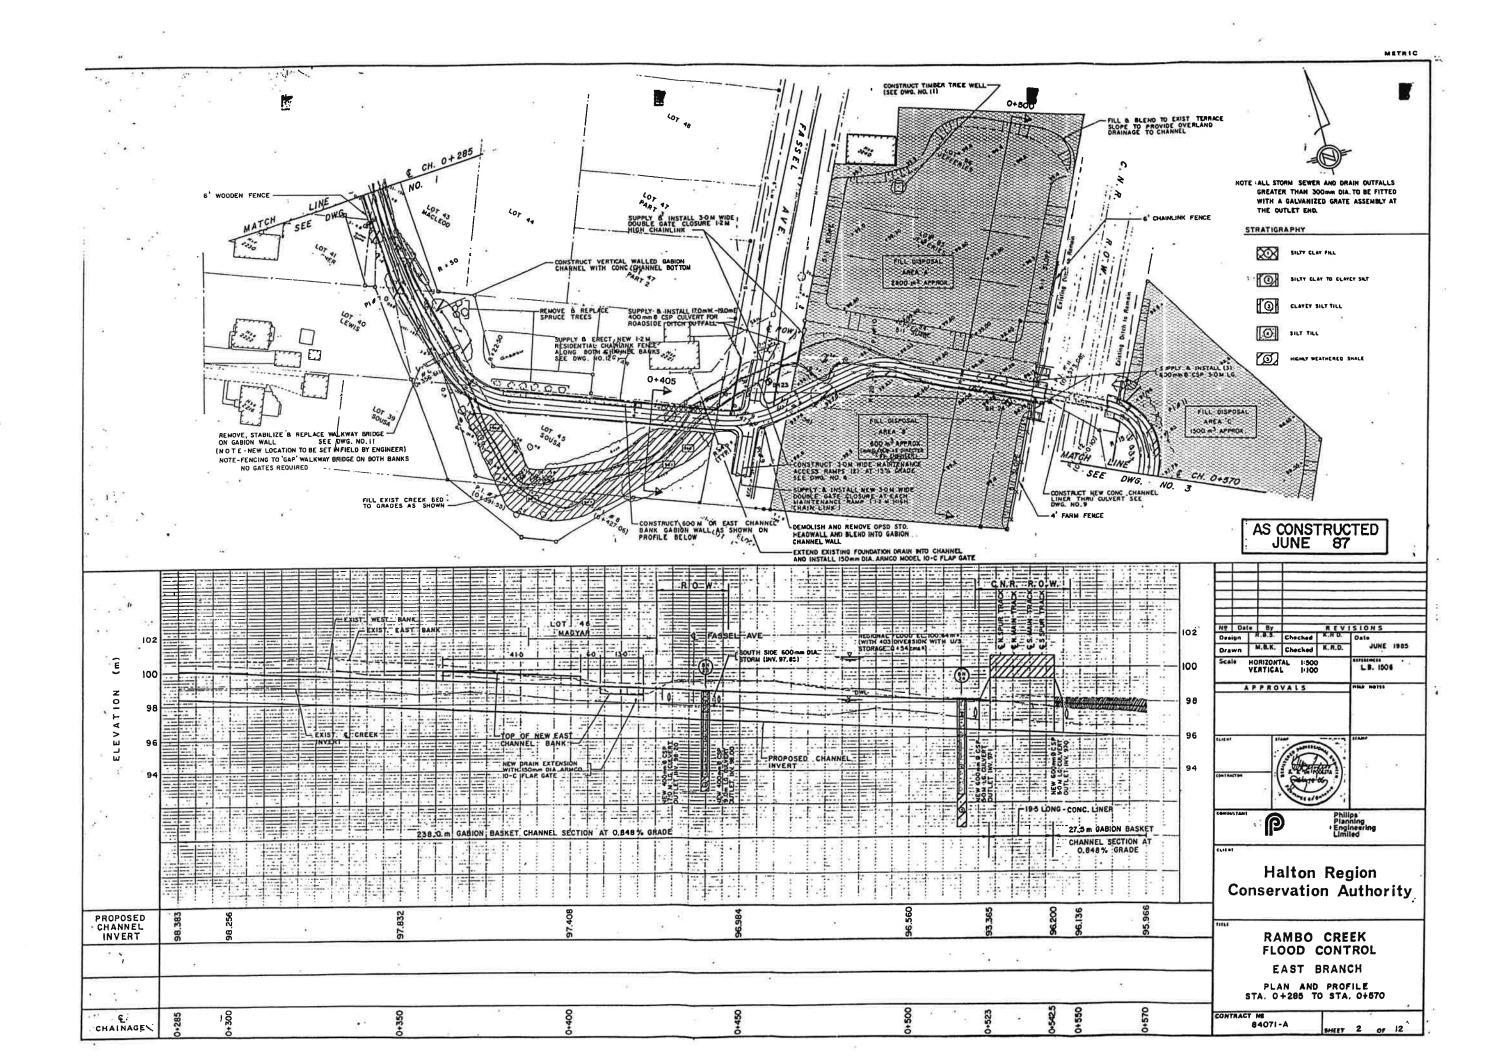

| •                             | FILL DISPOSAL<br>AREA 'C'<br>600 m3 APPROX. | 510 PREM   | AT & LEGGATT<br>DE LEGGATT<br>NO 10 LEGGANEW 12M<br>DENIAL CHAINTINK FENCE<br>NO AOTH DANKS SEE DWO. NO. 12<br>  |                       | M WIDE TEMPORARY<br>SEMENT FOR CONSTRUCTION<br>CESS | FAIRVIEW        |              |        | Q |    |
|-------------------------------|---|--|--|-----------------------|---|-----------------|--------------|--------|---|----|
| MATCH<br>ALL-                 |   | A CONTRACT OF CONTRACT | SUPPLY & PLACE RIPARA<br>ON SLOPES IN GUTLET<br>TRANSITION<br>TRANSITION<br>TRANSITION<br>TRANSITION<br>TRANSITION<br>TRANSITION<br>TRANSITION<br>TRANSITION<br>TRANSITION<br>TRANSITION<br>TRANSITION<br>TRANSITION<br>TRANSITION<br>TRANSITION<br>TRANSITION<br>TRANSITION<br>TRANSITION<br>TRANSITION<br>TRANSITION<br>TRANSITION<br>TRANSITION<br>TRANSITION<br>TRANSITION<br>TRANSITION<br>TRANSITION<br>TRANSITION<br>TRANSITION<br>TRANSITION<br>TRANSITION<br>TRANSITION<br>TRANSITION<br>TRANSITION<br>TRANSITION<br>TRANSITION<br>TRANSITION<br>TRANSITION<br>TRANSITION<br>TRANSITION<br>TRANSITION<br>TRANSITION<br>TRANSITION<br>TRANSITION<br>TRANSITION<br>TRANSITION<br>TRANSITION<br>TRANSITION<br>TRANSITION<br>TRANSITION<br>TRANSITION<br>TRANSITION<br>TRANSITION<br>TRANSITION<br>TRANSITION<br>TRANSITION<br>TRANSITION<br>TRANSITION<br>TRANSITION<br>TRANSITION<br>TRANSITION<br>TRANSITION<br>TRANSITION<br>TRANSITION<br>TR | ION BASKET BED LINING |   | TREET           |              |        |   | •  |
| 141<br>141<br>141<br>245      | R.<br>O.<br>W.                              | LIMIT OF<br>STA. 0+6   | CONTRACT A   | 9                     |   | 1               |              | 3      |   | 12 |
|                               | ·····                                       | <u>ا</u> ر .<br>المراجع المراجع  | - Inder Market   | F_J i p_i.            | <u></u>   | <u>Et El co</u> | 144431111    |        |   |    |
| 2                             |   | IMIT OF CHANNE   |  |                       |   |                 |              |        |   |    |
|                               |   |  |  |                       |   |                 |              |        |   |    |
|                               | EAST BANK FILL                              |  | NEL BANK   |                       | 1 1 1 1 1 1 1 1 1 1 1 1 1 1 1 1 1 1 1               | NEST: BANK      |              |        |   |    |
| N. <u>98</u>                  |   |  | EXIST.   | EAST BANK             |   |                 |              |        |   |    |
| ×96                           |   |  |  |                       |   |                 |              |        |   | •  |
| ц<br>ш 94                     |   | HANNEL INVER   | 이 아이들은 것 같아. 아이들이 가지 않는 것 같아. 아이들이 아이들이 가지 않는 것이 아이들이 있다. 아이들이 아이들에 가지 않는 것이 아이들에 가지 않는 것이 아이들에 가지 않는 것이 아이들에 가 나 나는 것이 아이들에 가 있는 것이 아이들에 가 나는 것이 아이들에게 하는 것이 아이들 것이 아이들에게 하는 것이 하는 것이 아이들에게 하는 것이 아이들에 이들에게 하는 것이 아이들에게 하는 것이   |                       | EXIST. C CREEK                                      |                 | EXIST. DOUBL |        |   |    |
|                               |   |  |  |                       |   |                 |              |        |   |    |
| a 160                         | 62.<br>SI                                   | OM GABION BASKET CH  |  | ID TO MEET            |   |                 |              | 1 () h |   |    |
| 2181                          |   |  | EXIST. GRAD  |                       |   |                 |              |        |   |    |
| PROPOSED<br>CHANNEL<br>INVERT | 95,966                                      | 95,712   | 95.441   |                       |   | 2               |              |        |   |    |
| INVERT                        | ŏ   | <u></u> ,  |  | ۲                     | а.<br>19  |                 | 2            | 8      |   |    |
|                               |   |  |  |                       |   |                 |              |        |   |    |
| CHAINAGE                      | 0+570                                       | 0+600  | 0+650  |                       |   |                 |              |        |   |    |
|                               | 5   |  |  |                       |   |                 |              |        |   |    |

2.5

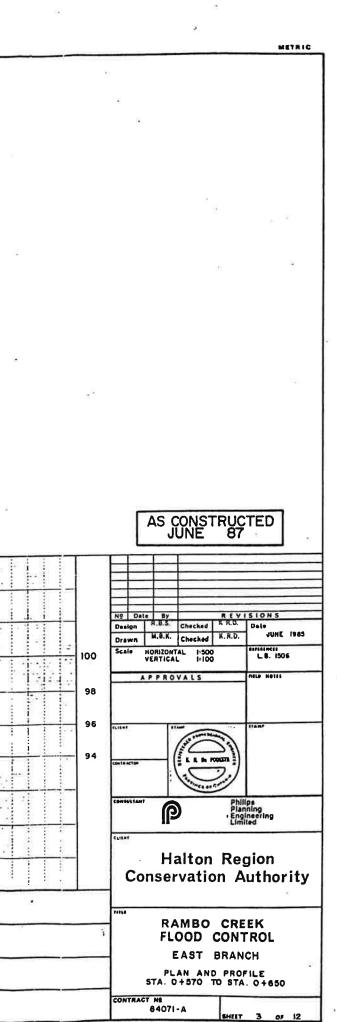



## 2.5 Photographic Reconnaissance

**Photo 2.1** - Downstream view of the Queensway Drive culvert, at the upstream limits of the study area. Note the heavy vegetation blocking the access ramp on the right, and growth through the cracks in the channel.



Photo 2.2 – Looking upstream at East Rambo Creek from Brenda Crescent at approximately Station 0+100





Photo 2.3 Looking downstream towards Glenwood School Drive from station 0+100 adjacent to Brenda Crescent.

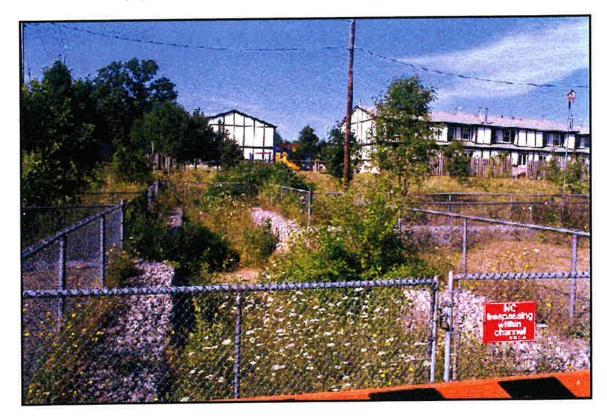


Photo 2.4 - Looking upstream towards the Glenview School Drive culvert.



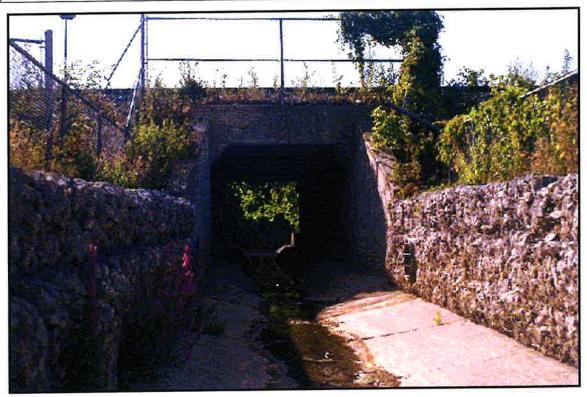


Photo 2.5 - Looking upstream from station 0+420, just north of the Fassel Avenue access gates.



**Photo 2.6** – View of the maintenance access gates and ramps from Fassel Avenue. The vegetation within this area should be kept clear at all times to provide unconstrained access.





**Photo 2.7** - Looking downstream at the CNR crossing from station 0+510. Note the damage to the chainlink fencing, and the vegetation growth through the channel base and gabions

## 2.6 **Operations and Maintenance**

## 2.6.1 Ownership Status

The rights to an 8.0 m wide strip of land, centered about the channel centreline, was secured through permanent easement at the time of construction, by the Halton Region Conservation Authority (Reference Appendix A).

## 2.6.2 Project Ingress and Egress

The channel invert is accessible between Queensway Drive and Glenwood School Drive, from a ramp located off Queensway Drive. Downstream of Queensway Drive, the channel up to the CNR is accessible through a bidirectional ramp located at Fassel Avenue. Downstream of the CNR, access is facilitated by a ramp structure off Fairview Street in the GO parking lot constructed as part of a separate contract (ref. Section 3). Key No. 18 facilitates gated access to each of the foregoing, available through the Halton Region Conservation Authority (905-336-1158).

## 2.6.3 Project Element Maintenance

Reference Appendix B for a summary table of project elements and deficiencies, along with the frequency of inspection and the methods of remedial works.

## Site Reconnaissance

In order to ensure the normal operation of the channel under the range of expected flow conditions, a "walk through" of the works should be carried out at least once a year. A detailed inspection of the works recording the location and types of any deficiencies, along with photographs should be carried out every five years. Information thusly collected should be catalogued and added to this manual.

### Gabion Baskets

The channelization of the East Rambo at this location is unique from the other sites of the Hager-Rambo Flood Control Works, since the entire channel is lined with a two-stage gabion basket retaining wall system. This element should be inspected for any settlement or displacement of the baskets, the degradation of the wire or stone, and large vegetation (tree roots) that may cause damage to the walls. Typically, the most damaging impact is from vandalism, particularly in residential areas.

## **Concrete Channel Invert and Structures**

The concrete invert of the channel and the culvert structures should be inspected annually. The concrete should be checked for any cracking or spalling, which may be repaired by sealing or grouting. Any major areas of cracking (> 3mm), displacement, or heaving (> 5 mm), along with the separation of slab or wall joints (expansion / control), requires a thorough investigation by a qualified Structural Engineer, to determine the cause and recommend remedial works. The underdrain system should also be inspected for any blockage of sediment or vegetation by monitoring the system's effectiveness and by probing the pipe. Throughout these works the site is covered with graffiti which may be removed by sandblasting or painted over for aesthetic reasons.

#### General/Ingress/Egress

Vegetation that may be obstructing the culverts, drainage or outlet pipes, or growing through the channel should be removed. The low flow channel should be monitored for sediment accumulation, and cleaned every five years (HRCA recommendation from Halton Channel Study). However, with the present state of the Hager-Rambo system this component does not seem to be a factor with the operation or function of the channels. Therefore, due to the channel design features and minimal sediment being transported into the system, this procedure is not recommended unless a serious blockage of the channel or culvert structures is imminent. Locations for access to the channel should remain clear of any obstructions (tall/thick vegetation). The locks and gates should be checked twice a year to ensure easy access under normal or emergency conditions.

## 3. Lower East Rambo Creek Channelization (CNR – Oakville to Fairview Street)

## 3.1 Project Description and Year of Construction

Lower East Rambo Creek Channelization

. Fairview Street to downstream of CNR Oakville


Construction completed in July 1996.

This project involved the construction of 120 metres of concrete lined invert with varying multiple courses of armour stone ranging from 3.2 metres wide to 3.9 metres to match into the existing double cell culvert at Fairview Street. A maintenance ramp was built to provide access to the channel invert between the CNR and Fairview Street.


## 3.2 **Project Location**

The project site is located between Brant Street and Guelph Line, extending from downstream of the CNR Oakville Subdivision crossing to Fairview Street. Adjacent to the site is the Burlington GO Station to the west, and Leggat GM Auto Dealership to the east.

## 3.3 Design Objectives and Criteria

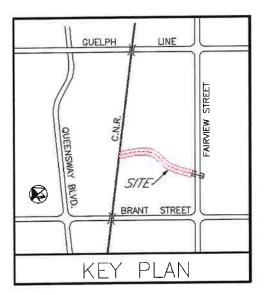

The channelization of East Rambo Creek was designed to accommodate the regulated 100 year flow of 15.0  $m^3/s$ , having a headwater elevation of 96.4 metres at the Fairview Street culvert, with a 0.3 metre freeboard. The main purpose of the works was to provide flood and erosion protection to the last remaining unlined creek component in this area.

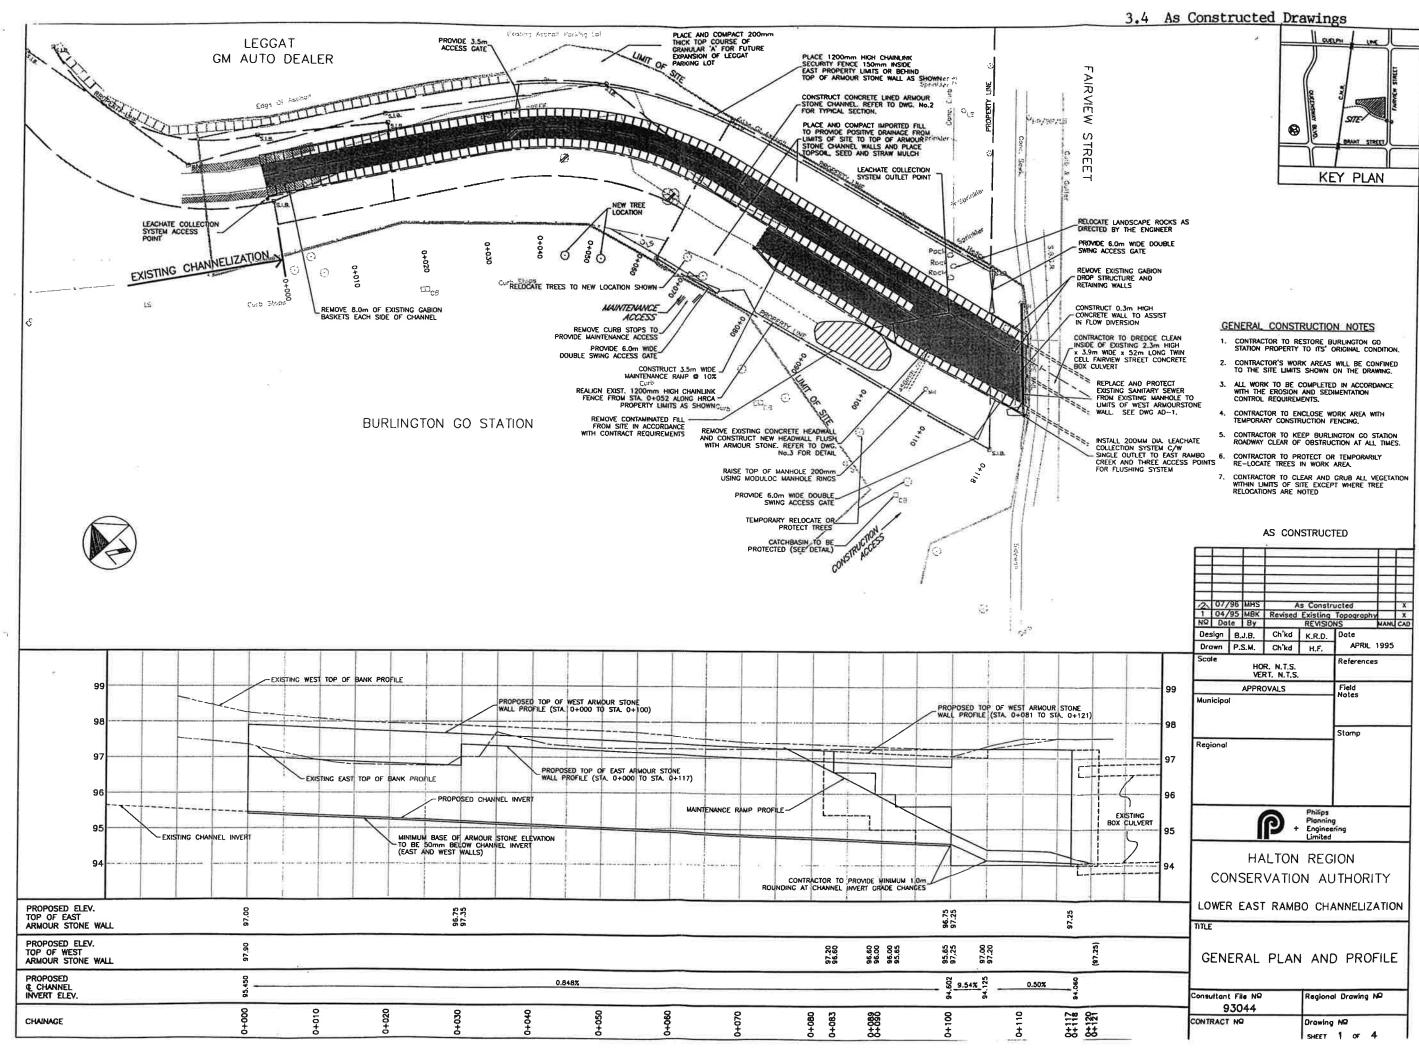

|               |          |                | 796 MHS           |                         | s Constr                                 | ucted        |       | x |  |
|---------------|----------|----------------|-------------------|-------------------------|--|--------------|-------|---|--|
|               |          | 1 04/<br>Nº Do | 195 MBK           | Revised                 | REVISIO                                  | Topography   | MANU  | X |  |
|               |          | Design         | B.J.B.            | Ch'kd                   | K.R.D.                                   | Date         |       |   |  |
|               |          | Drawn          | P.S.M.            | Ch'kd                   | H.F.                                     | APRIL        | 1995  |   |  |
|               |          | Scale          |                   | R. N.T.S.<br>RT. N.T.S. |  | References   | •     |   |  |
|               | 99       |                | APPR              | OVALS                   |  | Field        |       |   |  |
| ONE<br>0+121) |          | Municipa       | Municipal         |                         |  |              | Notes |   |  |
|               | 98       |                |                   |                         |  | Stomp        |       | - |  |
| T             | 97       | Regional       |                   |                         |  |              |       |   |  |
| [             | 97       |                |                   |                         |  |              |       |   |  |
|               | 96       |                |                   |                         |  |              |       |   |  |
|               | 95       |                |                   | ۰ <b>م</b>              | Philips<br>Plannin<br>Enginee<br>Limited | g<br>Irring  |       |   |  |
|               | 94       |                | HA                | LTON                    | REG                                      | ION          |       |   |  |
| L             |          | CO             | NSER              | VATIO                   | N AL                                     | JTHORI       | ΤY    |   |  |
|               |          | LOWE           | R EAST            | RAMB                    | ю сн                                     | ANNELIZA     |       | N |  |
| 6             |          | TITLE          |                   |                         |  |              |       |   |  |
| (97.25)       | GEN      | ERAL           | PLAN              |                         | ) PROF                                   | TILE         |       |   |  |
| 090.<br>• e   |          |                |                   |                         |  |              |       |   |  |
|               |          | Consultan<br>S | t file Nº<br>3044 |                         | Regione                                  | ol Drawing N | ρ     |   |  |
| ++ ++<br>575  | CONTRACT | NQ             |                   | Drowing                 | owing NO                                 |              |       |   |  |

## 3.5 Photographic Reconnaissance



**Photo 3.1** Looking upstream at the transition from the vertical gabion walled channel to the armour stone lined channel from station 0+020.



**Photo 3.2** View of the Fairview Street culvert looking downstream from station 0+070 along the alignment of the access ramps.



Photo 3.3 Looking upstream from atop the Fairview Street culvert.

## 3.6 Operations and Maintenance

## 3.6.1 Ownership Status

This section of the Lower East Rambo Creek is owned by the Halton Region Conservation Authority (Parts 1 & 2, Plan 20R-11811), averaging approximately 12 metres in width. (Reference Appendix A)

## 3.6.2 Project Ingress and Egress

The channel invert is accessible by one of three 6 m double swing access gates, located on either side of the channel off Fairview Street, and from the Burlington GO Station parking lot. Gated access to each of the foregoing is facilitated by Key No. 18, available through the Halton Region Conservation Authority (905-336-1158).

## 3.6.3 Project Element Maintenance

Reference Appendix B for a summary table of standard component elements of the project, along with the frequency of inspection and the methods of remediation.

## Site Reconnaissance

In order to ensure the normal operation of the channel under the range of expected flow conditions, a "walk through" of the works should be carried out at least once a year. A detailed inspection of the works recording the location and types of any deficiencies, along with photographs should be carried out every five years. Information thusly collected should be catalogued and added to this manual.

## Armour Stone

During the annual inspection, the stone should be checked for any degradation or displacement. Specific items to check for include intrusive vegetation and washout of backfill material. If distress is occurring, a thorough investigation is required by a qualified Engineer to determine the cause and recommend remedial works.

## **Concrete Channel Invert**

The concrete invert of the channel and the culvert structures should be inspected annually. The concrete should be checked for any cracking or spalling, which may be repaired by sealing or grouting. Any major areas of cracking (> 3mm), displacement, or heaving (> 5 mm), along with the separation of slab or wall joints (expansion / control), requires a thorough investigation by a qualified Structural Engineer, to determine the cause and recommend remedial works. The underdrain system should also be inspected for any blockage of sediment or vegetation by monitoring the system's effectiveness and by probing the pipe.

## General/Ingress/Egress

Vegetation that may be obstructing the culverts, drainage or outlet pipes, or growing through the channel should be removed. The low flow channel should be monitored for sediment accumulation, and cleaned every five years (HRCA recommendation from Halton Channel Study). However, with the present state of the Hager-Rambo system, this component does not seem to be a factor with the operation or function of the channels. Therefore, due to the channel design features and minimal sediment being transported into the system, this procedure is not recommended unless a serious blockage of the channel or culvert structures is imminent. Locations for access to the channel should remain clear of any obstructions (tall/thick vegetation). The locks and gates should be checked twice a year to ensure easy access under normal or emergency conditions.

1

## 4. East Hager Creek Channelization (Fairview Street to CNR – Halton)

## 4.1 **Project Description and Year of Construction**

East Hager Creek Channelization


Fairview Street to CNR Halton

Construction completed in October 1991

From Fairview Street to the CNR Halton crossing, 268 metres of concrete lined trapezoidal invert with a low flow channel was constructed, connecting to the existing structures at the upstream and downstream limits of this site. The concrete channel walls extend vertically to a maximum height of 4.2 metres above the centerline invert of the channel, having an approximate top width of 6.4 metres. This project also included the replacement of the Plains Road structure with a 2.6 x 2.6 x 27.0 metre, twin concrete box culvert.


## 4.2 **Project Location**


This section of the East Hager Creek reconstruction is located between Fairview Street and the CNR Halton crossing, just east of the QEW.

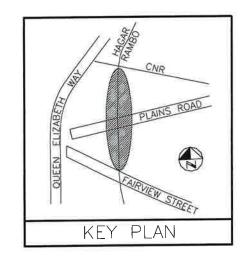

## 4.3 Design Objectives and Criteria

The channelization works were designed to the Regional event (Hurricane Hazel), future land use peak flow of 48 m<sup>3</sup>/s, regulated by the existing Freeman Detention Facility (Reference Section 7.3) based on the capacity of the existing Fairview Street culvert.

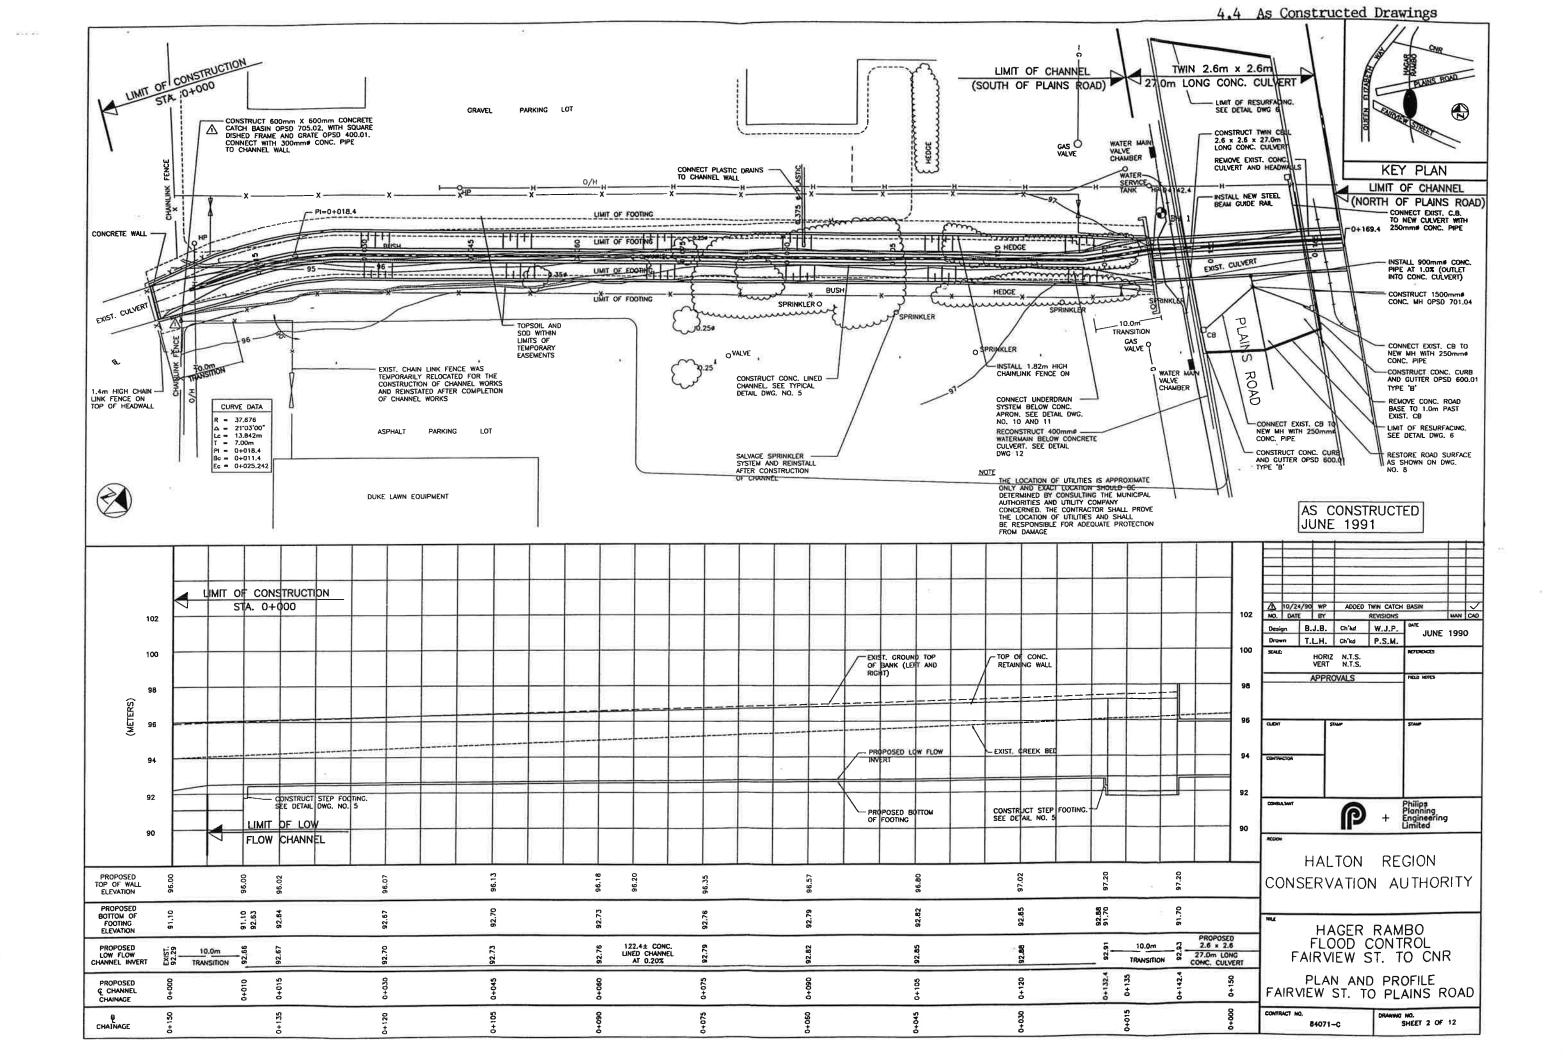

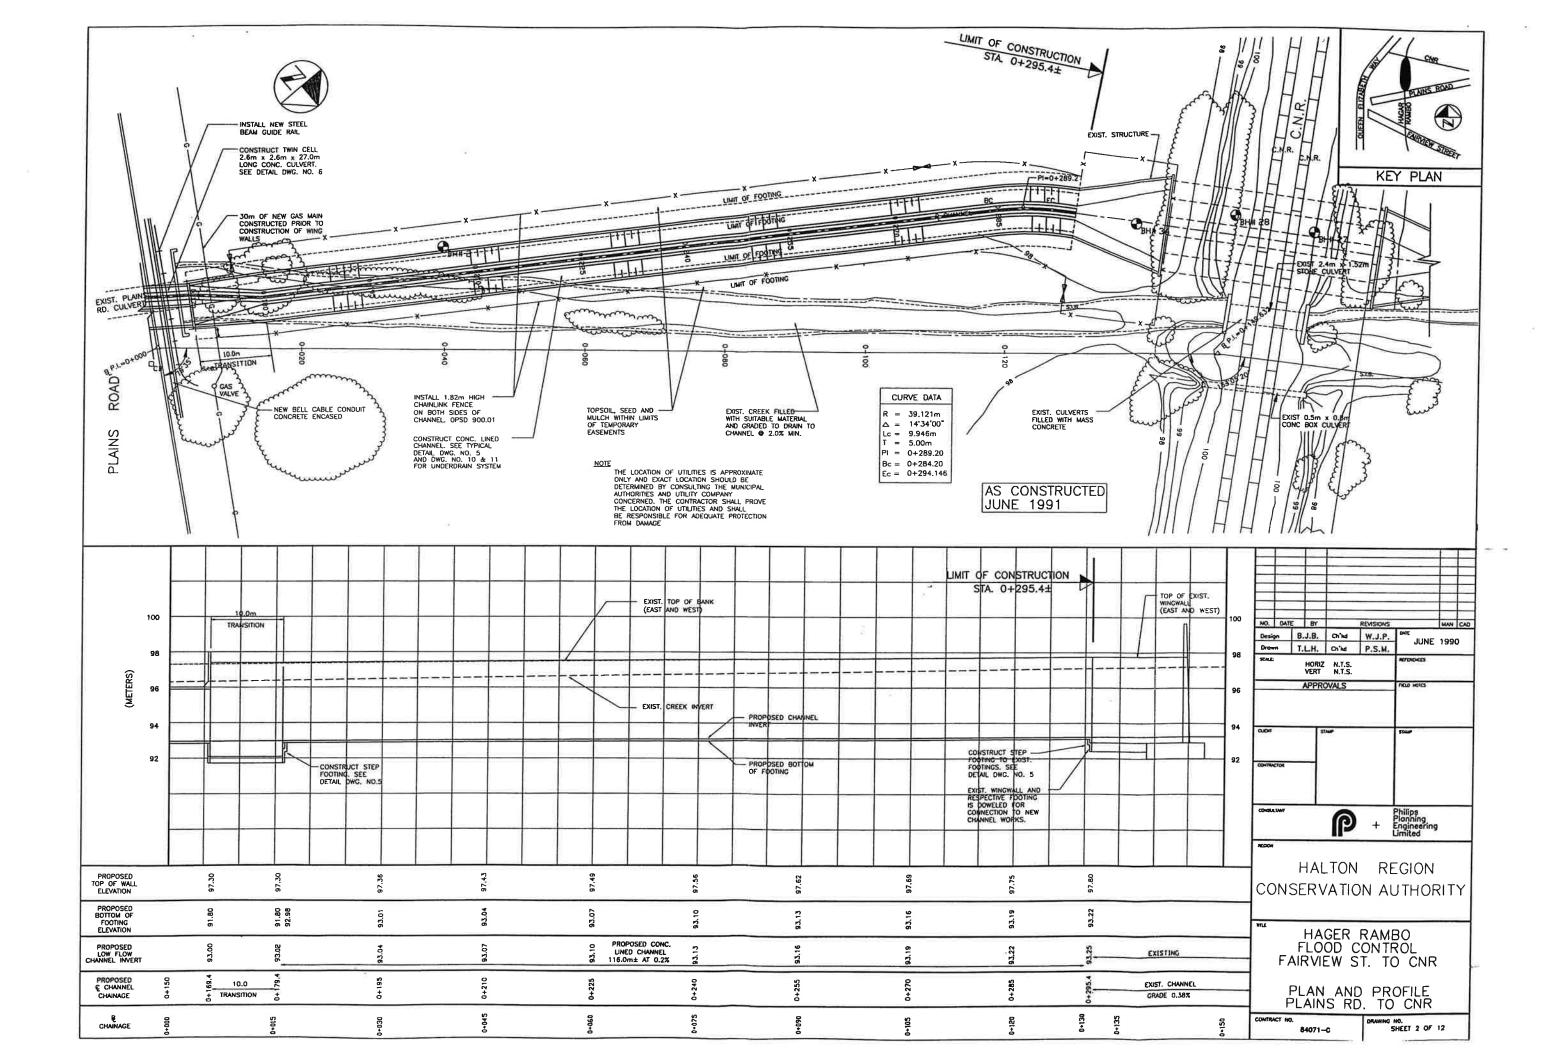

## 4.5 Photographic Reconnaissance

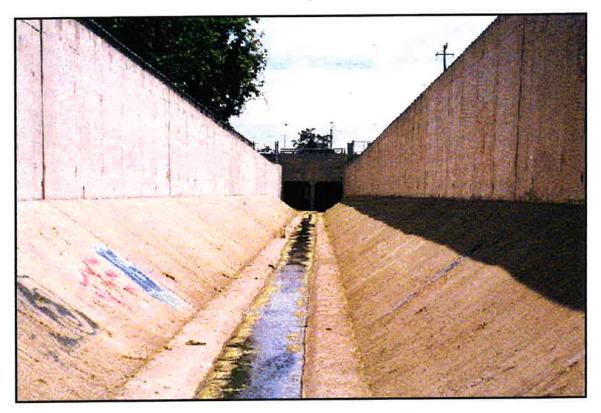


Photo 4.1 - View of the channelization works from station 0+270 looking downstream towards the Plains Road culvert.

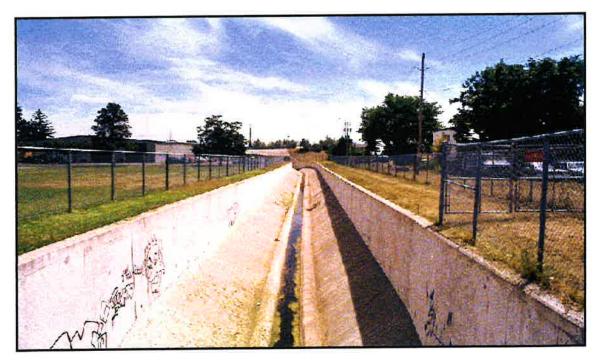


Photo 4.2 - Looking downstream from atop the Plains Road culvert towards Fairview Street.

## 4.6 **Operations and Maintenance**

## 4.6.1 Ownership Status

The Halton Region Conservation Authority has ownership title to a 13 metre wide strip of land between Fairview Street and Plains Road, as referenced to the centreline of the channel (Parts 2, 3, and 4, Plan 20R-9601). The Conservation Authority also has ownership title to a 13 metre wide strip of land between Plains Road and the CNR Crossing (Part 2, Plan 20R-9602), and a 7 metre wide permanent easement for maintenance along the east side of the channel (Part 1, Plan 20R-9602). (Reference Appendix A)

## 4.6.2 Project Ingress and Egress

The channel between Fairview Street and Plains Road is accessible by gated access on the west side of the channel at the Fairview Street culvert and the south side of Plains Road. The channel section between Plains Road and the CNR is accessible by gated access on both the east and west sides of the Plains Road culvert on the north side. In both cases the access is along the top of the west side of the channel and direct access to the channel invert is not possible.

Key No. 18 facilitates gated access to each of the foregoing, available through the Halton Region Conservation Authority (905-336-1158).

### 4.6.3 Project Element Maintenance

Reference Appendix B for a summary table of standard component elements of the project, along with the frequency of inspection and the methods of remediation.

## Site Reconnaissance

In order to ensure the normal operation of the channel under the range of expected flow conditions, a "walk through" of the works should be carried out at least once a year. A detailed inspection of the works recording the location and types of any deficiencies, along with photographs should be carried out every five years. Information thusly collected should be catalogued and added to this manual.

#### **Concrete Retaining Walls and Channel Invert**

The concrete invert, walls, and culvert structures should be inspected annually. The concrete should be checked for any cracking or spalling, which may be repaired by sealing or grouting. Any major areas of cracking (> 3mm), displacement, or heaving (> 5 mm), along with the separation of slab or wall joints (expansion / control), requires a thorough investigation by a qualified Structural Engineer, to determine the cause and recommend remedial works. The underdrain system should also be inspected for any blockage of sediment or vegetation by monitoring the system's effectiveness and by probing the pipe. Throughout these works the walls are covered with graffiti and which may be removed by sandblasting or painted over for aesthetic reasons.

### General/Ingress/Egress

Vegetation or debris that may be obstructing the Fairview Street or Plains Road culvert, drainage or outlet pipes, or growing through the channel invert should be removed. Locations for access to the channel from Plains Road and Fairview Street should remain clear of any obstructions (tall/thick vegetation). The locks and gates should be checked twice a year to ensure easy access under normal or emergency conditions.

## 5. East Hager Creek (CNR Halton Culvert Crossing)

#### 5.1 Project Description and Year of Construction

East Hager Creek


CNR Halton Culvert Crossing

Construction completed in 1990.

This project involved the pipe-jacking of three 2100 mm diameter reinforced concrete pipes, each 26 metres in length, through the CNR crossing. In addition, both upstream and downstream headwalls, wing-walls, and retaining walls were constructed.


### 5.2 Project Location


The CNR Halton crossing is located approximately 120 metres north of Plains Road, east of the QEW.

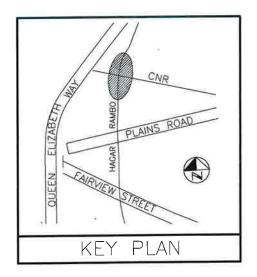

### 5.3 Design Objectives and Criteria

Culvert crossing works were designed to the controlled Regional event (Hurricane Hazel) future land use peak flow of 48 m<sup>3</sup>/s, regulated by the Freeman Detention Facility and the capacity of the Fairview Street culvert. This design flow promotes an upstream water surface elevation of 97.5 m at the culvert, allowing for a 0.3 m freeboard to the top of headwall elevation of 97.8 m.

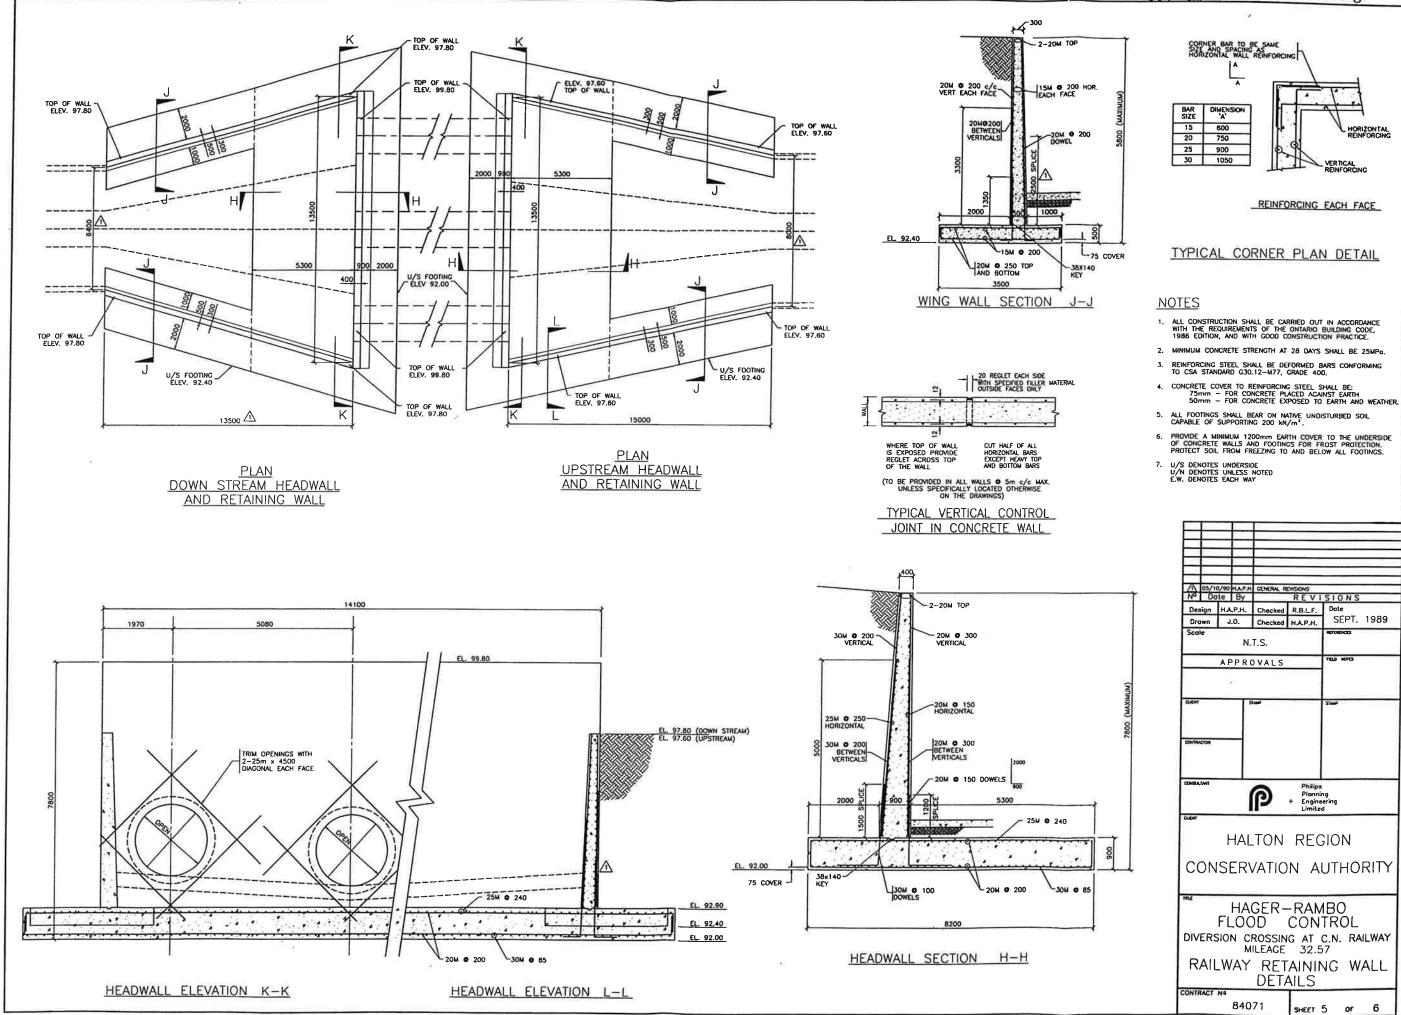

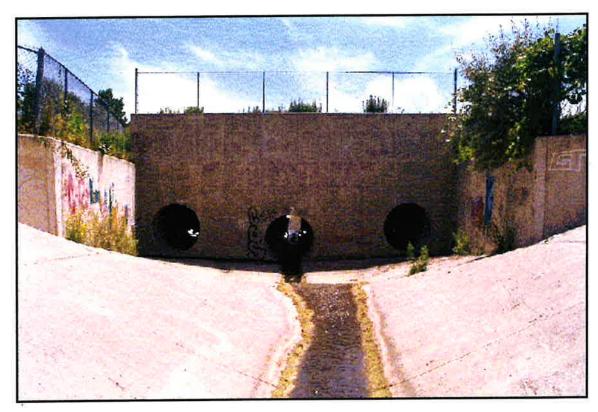

## 5.5 Photographic Reconnaissance

Photo 5.1 - View of the upstream side of the CNR crossing with the triple 2100 mm concrete pipe culverts. Note the vegetation growth out of the concrete.

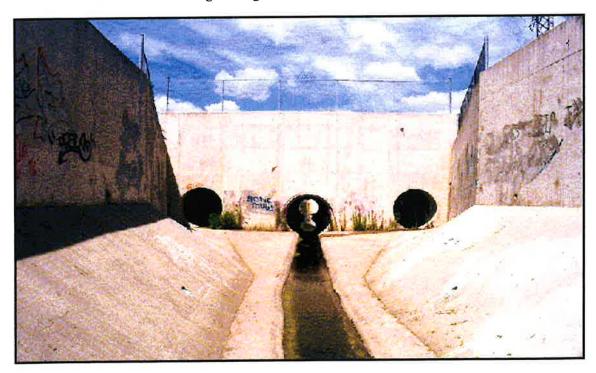


Photo 5.2 - Looking upstream towards the CNR crossing with low flow levels confined to the centre pipe.

## 5.6 **Operations and Maintenance**

## 5.6.1 Ownership Status

The works are located on a 27.5 metre strip of land owned by the Canadian National Railway, with a maintenance easement granted to the Halton Region Conservation Authority. (Reference Appendix A)

## 5.6.2 Project Ingress and Egress

The site is accessible from the top only (i.e. no invert access) from the north side of Plains Road, from the end of Coric Avenue through Leighland Park, or through the Freeman Pond entrance off of Brant Street. Gated access to the Plains Road and Brant Street location is facilitated by Key No. 18, for access to the CNR location, available through the Halton Region Conservation Authority (905-336-1158).

## 5.6.3 Project Element Maintenance

Reference Appendix B for a summary table of standard component elements of the project, along with the frequency of inspection and the methods of remediation.

## Site Reconnaissance

In order to ensure the normal operation of the culverts under the range of expected flow conditions, a "walk through" of the works should be carried out at least once a year. A detailed inspection of the works recording the location and types of any deficiencies, along with photographs should be carried out every five years. Information thusly collected should be catalogued and added to this manual.

## Concrete Pipe and Walls

The concrete culverts, headwalls, and wingwalls should be inspected annually. The concrete should be checked for any cracking or spalling, which may be repaired by sealing or grouting. Any major areas of cracking (> 3mm), displacement, or heaving (> 5 mm), along with the separation of slab or wall joints (expansion / control) and movement of backfill material, requires a thorough investigation by a qualified Structural Engineer, to determine the cause and recommend remedial works. The culverts should also be checked for sediment accumulation and cleaned as necessary (Reference Section 2.6.4). Throughout these works the walls are covered with graffiti and which may be removed by sandblasting or painted over for aesthetic reasons.

## General/Ingress/Egress

Vegetation or debris that may be obstructing the triple cell culvert at the CNR Halton crossing should be removed manually. Locations for access to the channel should remain clear of any obstructions (tall/thick vegetation).

## 6. East Hager Creek Channelization

### 6.1 **Project Description and Year of Construction**

East Hager Creek Channelization


CNR Halton to Freeman Detention Facility

Construction completed in October 1995

Approximately 480 metres of channel was constructed between the CNR Halton crossing and the Freeman Detention Facility outlet. This predominately interlocking concrete block (Terrafix <sup>TM</sup>) lined channel has a top width of 14 m with a depth of 2.7 metres.


## 6.2 **Project Location**


The site is situated between the QEW Toronto-bound lanes and Leighland Park, extending north from the CNR Halton crossing to the Freeman Detention Facility outlet.

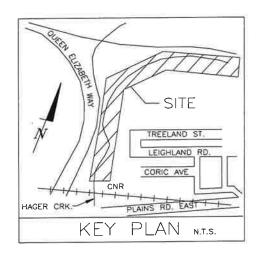



## 6.3 Design Objectives and Criteria


Channel works were designed to the controlled Regional event, future land use peak flow of 48  $m^3/s$ , regulated by the existing Freeman Detention Facility (reference Section 7) based on the capacity of the existing Fairview Street culvert.

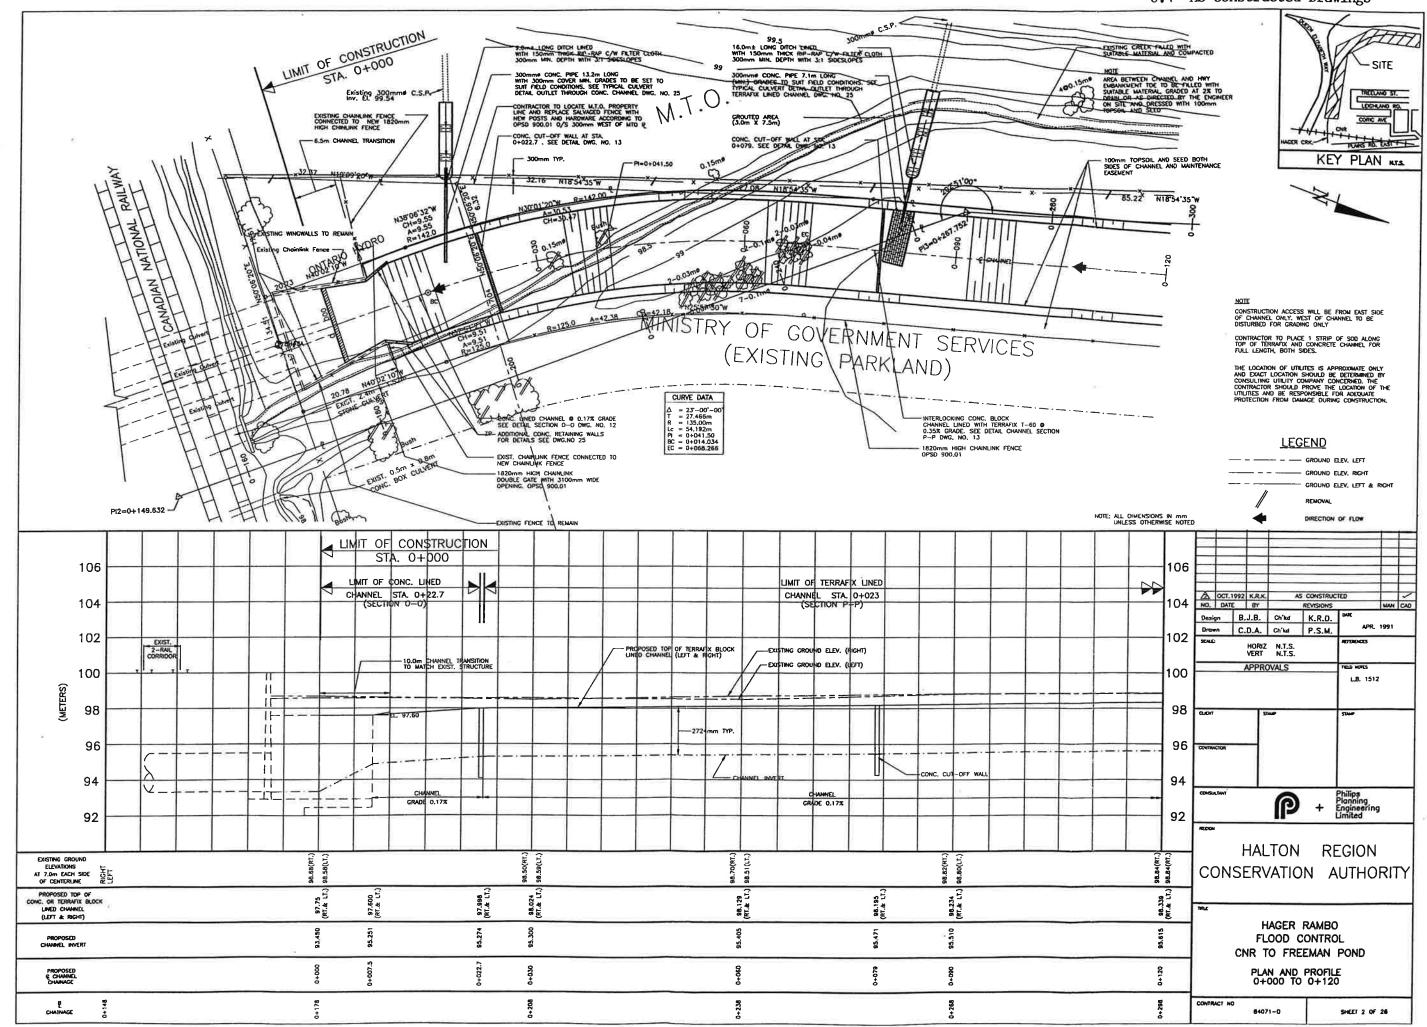

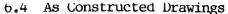

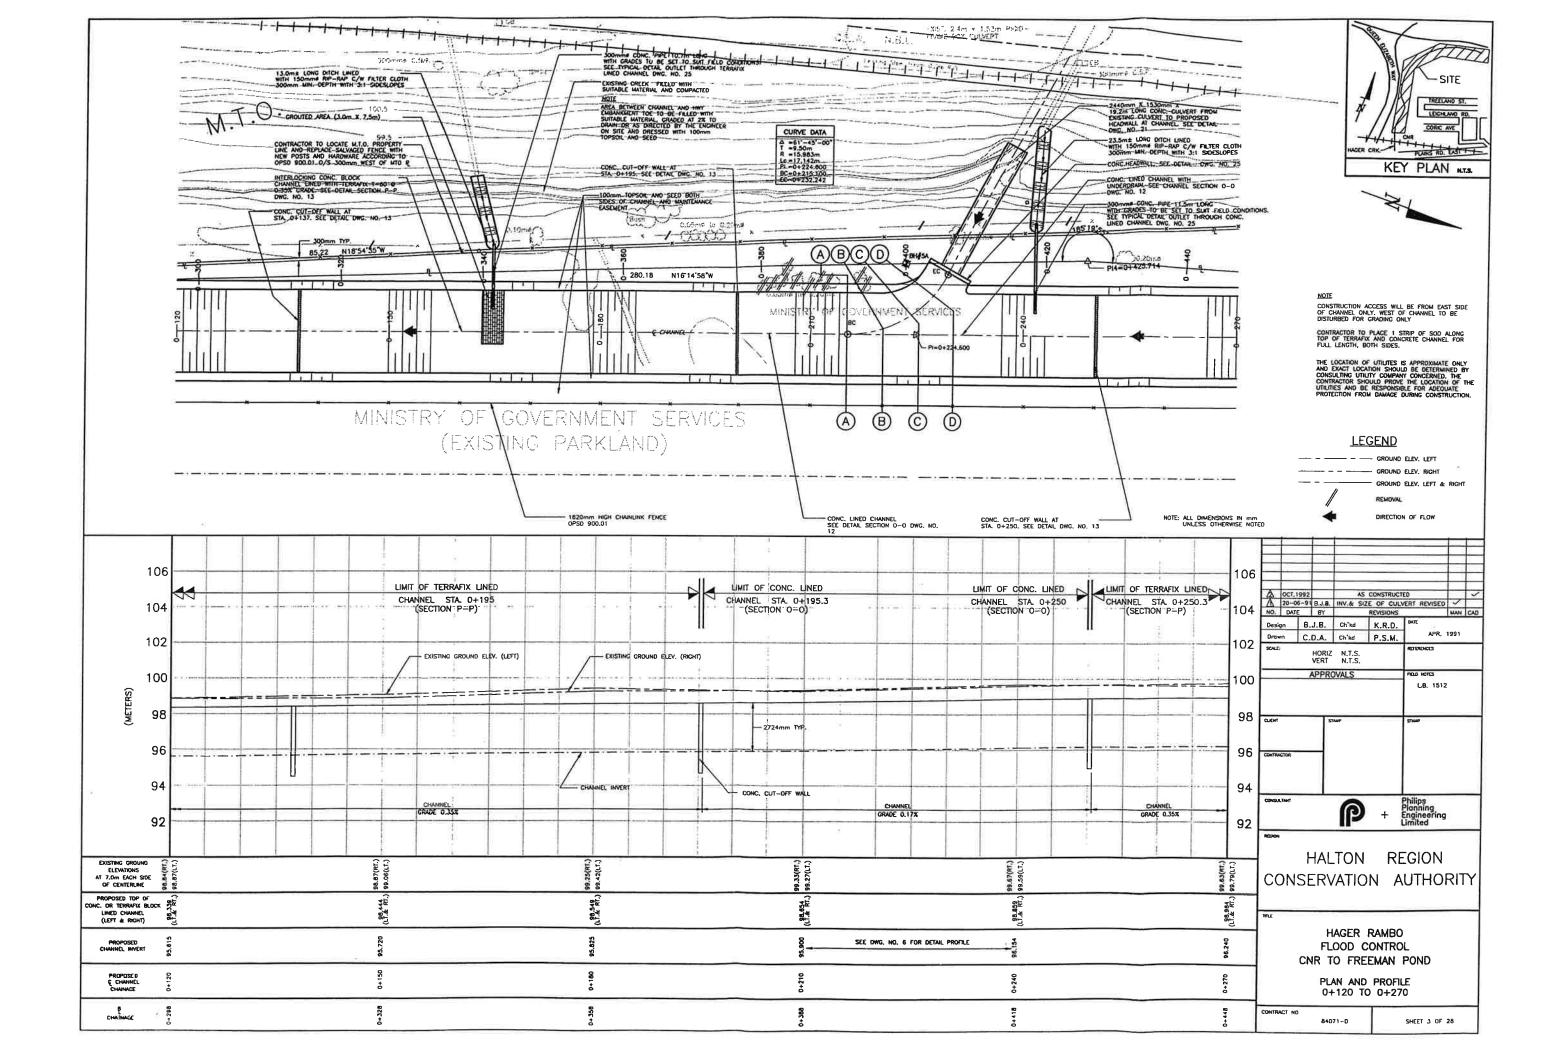

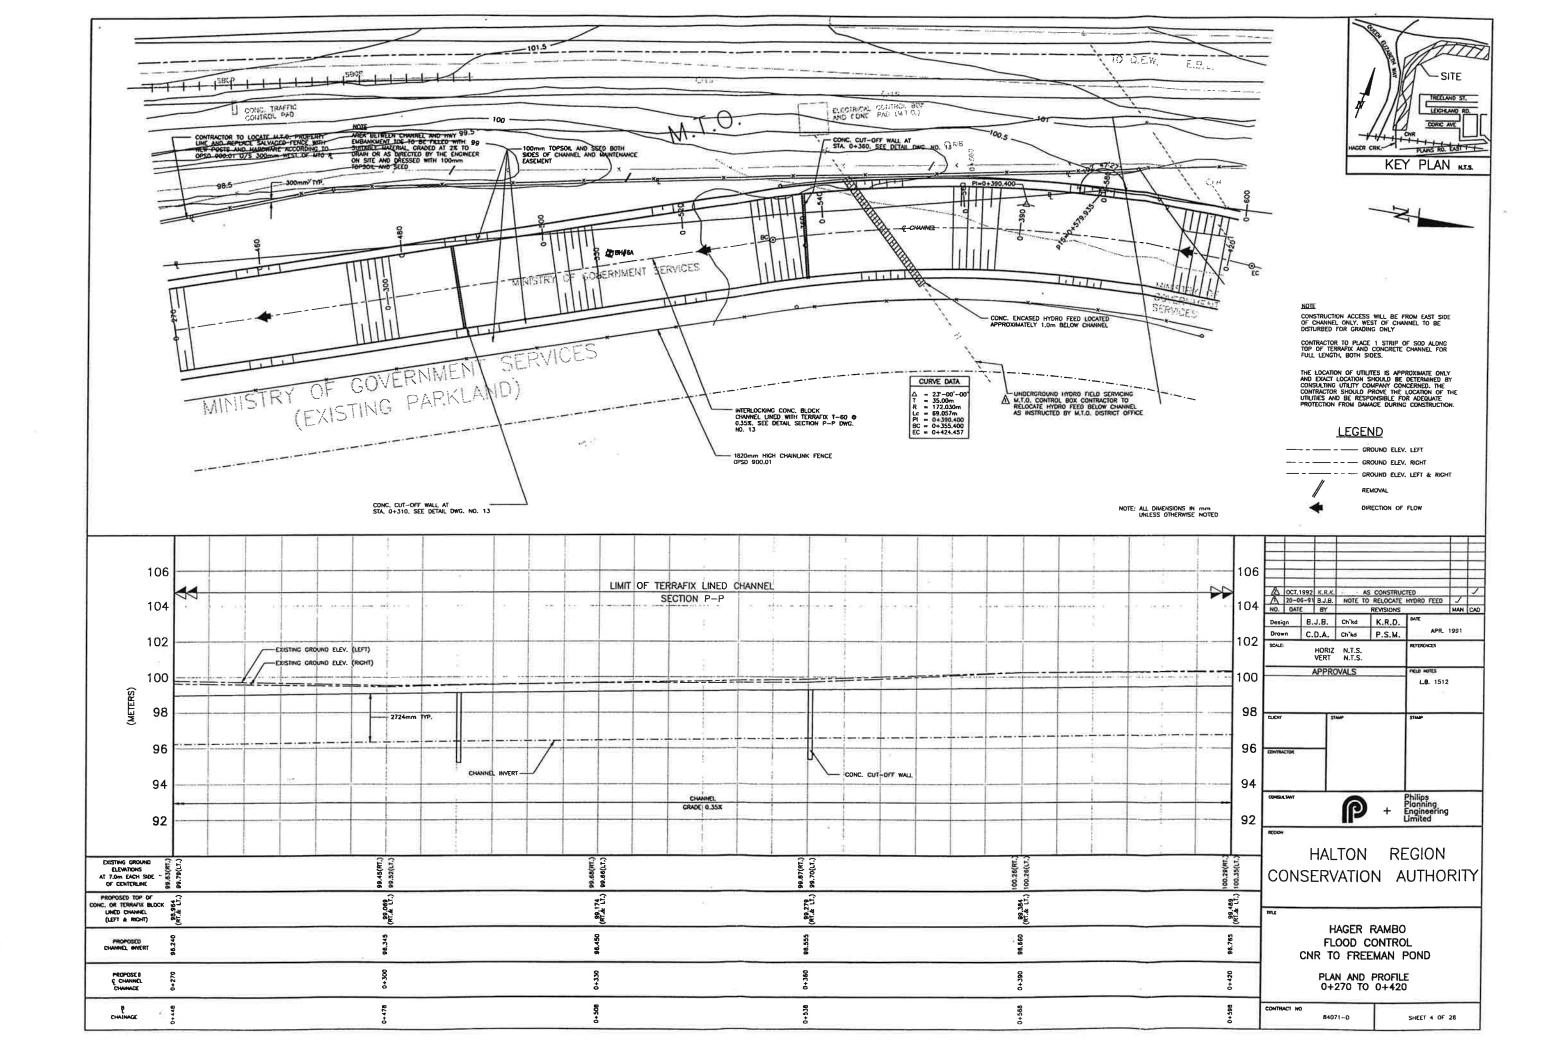


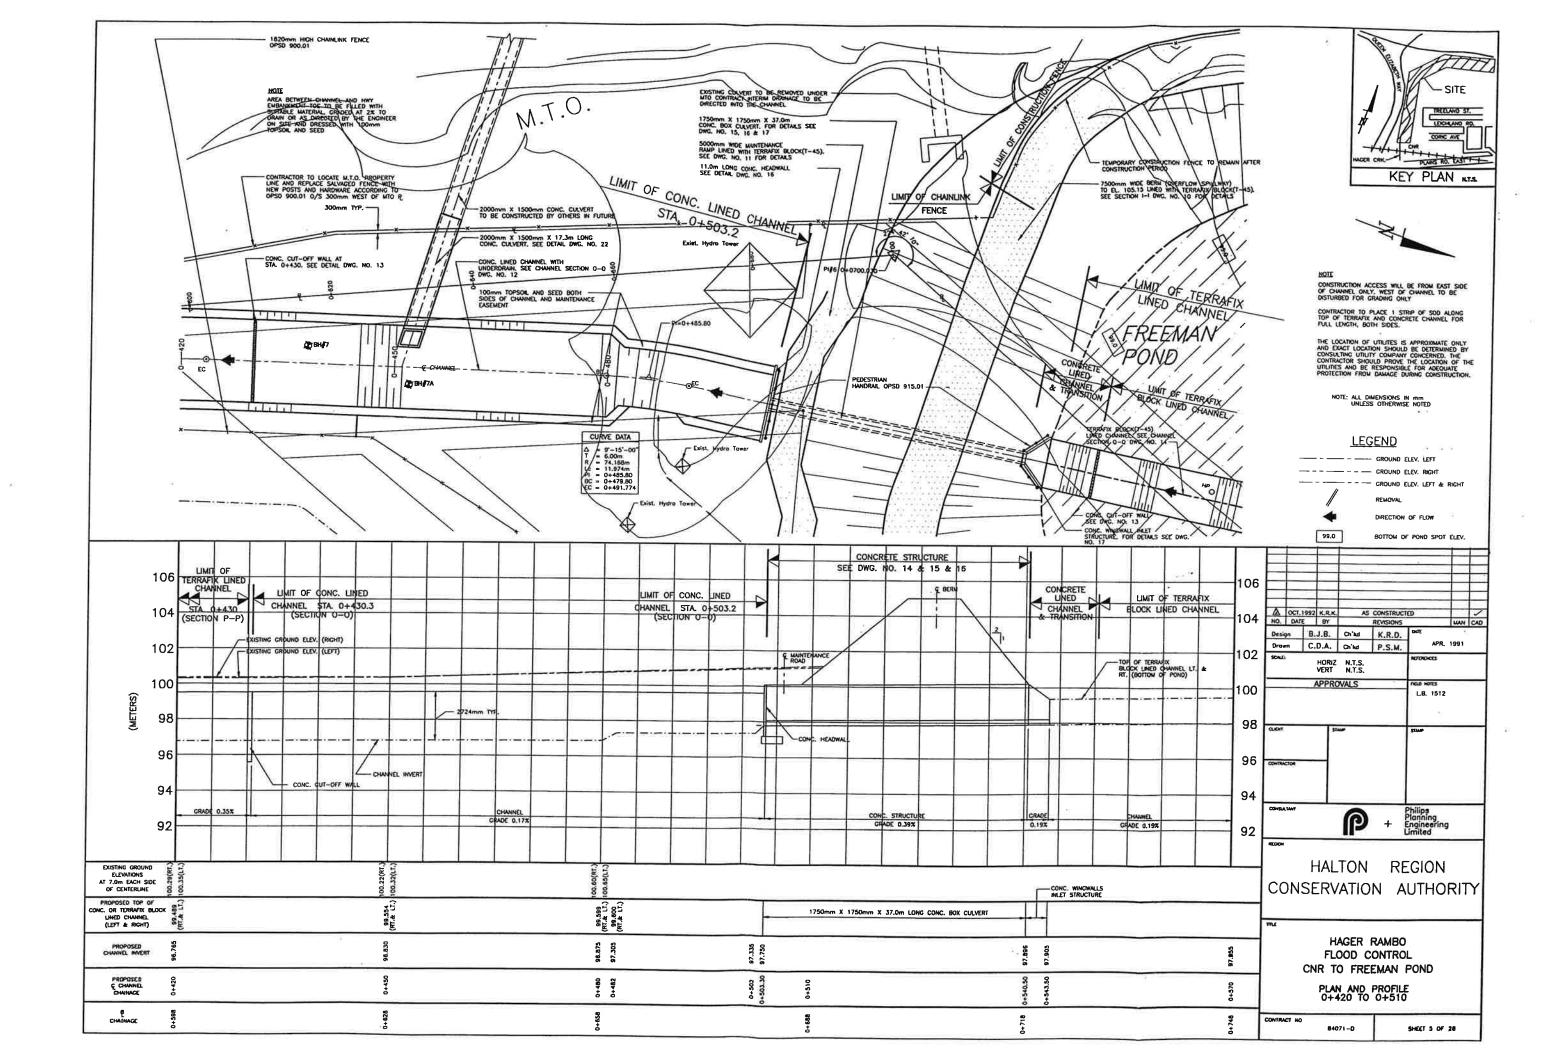



6.5 Photographic Reconnaissance

Photo 6.1 - Looking downstream from station 0+300 towards the CNR Halton crossing.

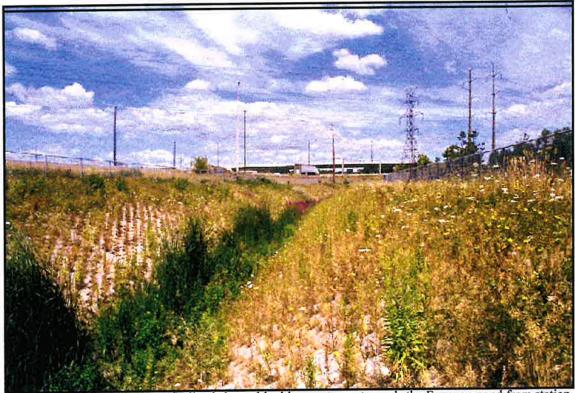

**Photo 6.2** - View of the terrafix lined channel looking upstream towards the Freeman pond from station 0+300. This vegetation growth through the terrafix block is typical throughout.

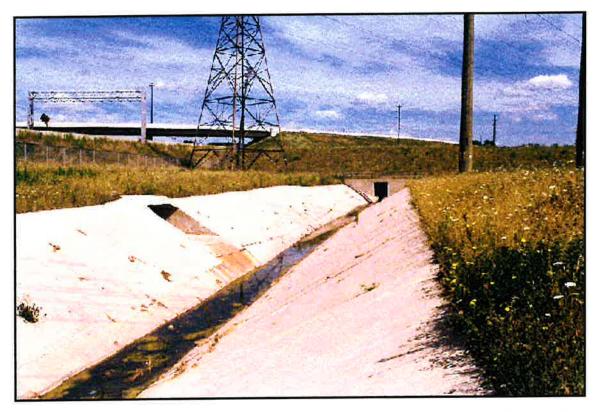


Photo 6.3 - Looking upstream at the concrete channel section and outlet culvert. Note the vegetation growing out of the drainage pipes.



Photo 6.4 - Looking downstream at the concrete to terrafix block channel transition from the top of berm above the outlet culvert.



#### 6.6.1 Ownership Status

The Halton Region Conservation Authority has title to the portion of the channel from the CNR crossing to the northerly limit of Leighland Park. This land is approximately 20 metres wide from the centreline of the channel and 480 metres in length. (Reference Appendix A)

### 6.6.2 Project Ingress and Egress

The site is accessible through the double gated entrance to the Freeman Pond, located on the west side of Brant Street just south of the QEW. An access road through the Ontario Hydro right-of-way on the south side of the berm leading to the outlet culvert, with a 3 metre wide access road running along the east side of the channel to the CNR Halton crossing. (There is no direct access ramp to the invert, but it is possible to reach from the access road) The site is enclosed by a 1.8 metre chainlink fence with gated access facilitated by Key No. 18, available through the Halton Region Conservation Authority (905-336-1158).

### 6.6.3 Project Element Maintenance

Reference Appendix B for a summary table of standard component elements of the project, along with the frequency of inspection and the methods of remediation.

#### Site Reconnaissance

In order to ensure the normal operation of the channel under the range of expected flow conditions, a "walk through" of the works should be carried out at least once a year. A detailed inspection of the works recording the location and types of any deficiencies, along with photographs should be carried out every five years. Information thusly collected should be catalogued and added to this manual.

### Interlocking Concrete Block Channel

During the annual inspection, the interlocking concrete block (Terrafix <sup>TM</sup>) should be checked for any displacement, bulging, or heaving. The blocks should be checked to ensure that they are embedded or covered with native material (soil) and that vegetation is growing through the spaces to allow for additional stability. Any sections that may be damaged or missing blocks, should be replaced and the channel should be kept clear of any debris that may inhibit the function of the channel. The underdrain system should also be inspected for any blockage of sediment or vegetation by continually monitoring the systems effectiveness and by probing the pipe.

### General/Ingress/Egress

Vegetation or debris that may be obstructing the concrete channel invert, drainage or outlet pipes, or growing through the channel invert should be removed. Invasive species such as Purple Loosestrife that are present in the channel should be removed prior to pollination by manually digging or pulling the plants and roots, or by biological or chemical control. Locations for access to the channel should remain clear of any obstructions (tall/thick vegetation). The locks and gates should be checked twice a year to ensure easy access under normal or emergency conditions.

# 7. Freeman Detention Facility and East Hager Creek Channelization

# 7.1 Project Title and Year of Construction

East Hager Creek Channelization


Freeman Detention Facility

Construction completed in October 1995

The pond construction involved earth excavation of a 45,000 m<sup>3</sup> and earth borrow of 105,000 m<sup>3</sup> to build the berm and highway embankments. This project also required the placement of a culvert for the Freeman Facility outlet, and accompanying concrete transition sections. Through the Freeman Detention Facility, a 244 metre long interlocking concrete block (Terrafix <sup>TM</sup>) lined low flow channel, and a 32 metre long concrete low flow transition channel, both 7 metres wide were constructed. A 5.05 x 5.05 metre culvert and channel through from the Upper Freeman Pond (volume storage of 5.06 ha-m) were constructed to convey flows from the North Service Road Pond System.


# 7.2 Project Location


The Freeman Detention Facility is located west of Brant Street, enclosed by the QEW/403 Interchange embankment to the north and west, and the Treeland-Leighland community to the south.

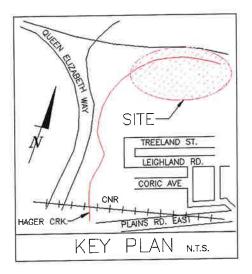

# 7.3 Design Objectives and Criteria

The Freeman Storage Facility was designed as a "dry facility" with a low flow channel to provide flood storage of 27 ha-m for the Regional event to an elevation of 105.4 metres, allowing a 0.3 metre freeboard to the top of the berm. This design has been implemented to control the downstream channel flow to  $48.0 \text{ m}^3$ /s based on the capacity of the Fairview Street culvert.

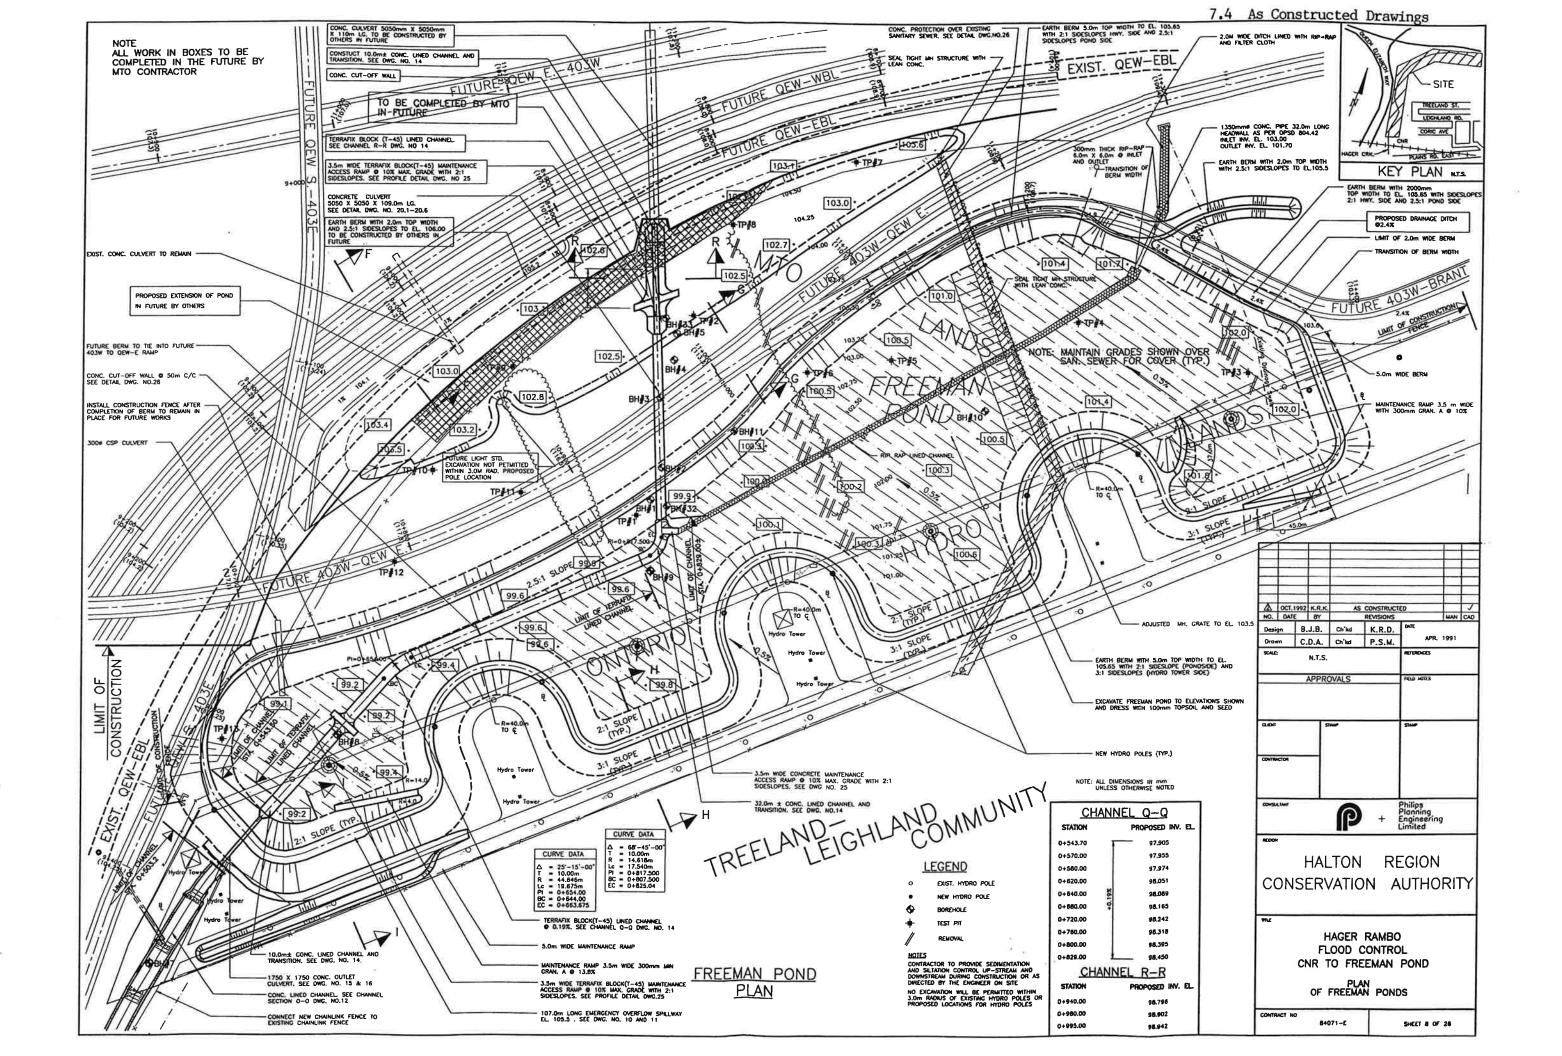

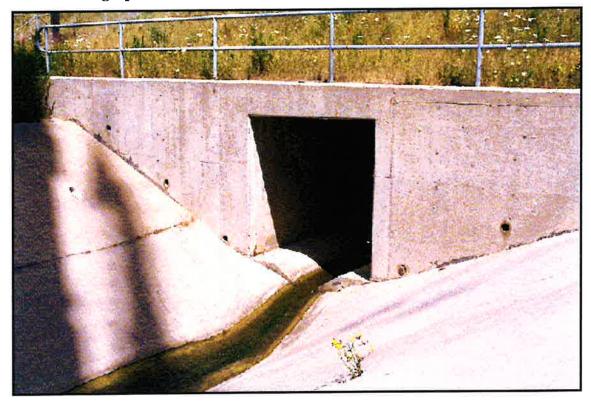

# 7.5 Photographic Reconnaissance

Photo 7.1 - View of the downstream face and transition of the Freeman Pond outlet culvert.

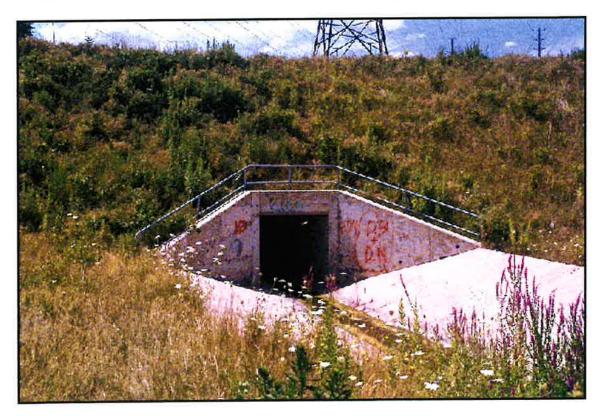


Photo 7.2 - View of the upstream side of the outlet culvert and concrete transition.



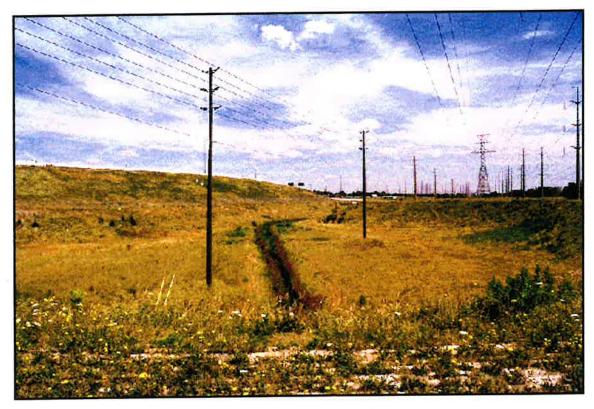


Photo 7.3 - Looking upstream at the Freeman Pond System from the berm at the outlet.

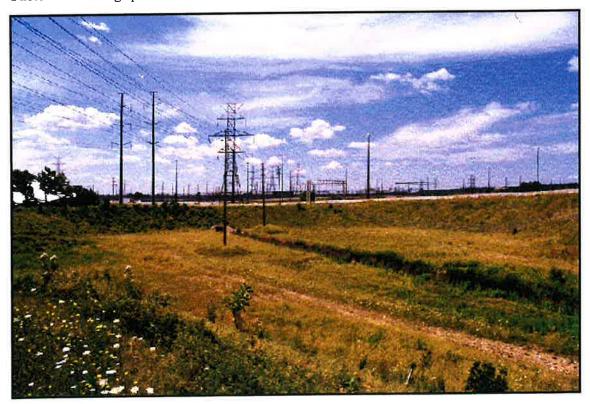



Photo 7.4 - Looking downstream from the berm on the south side of the Freeman Pond.





Photo 7.5 - Looking upstream at the pond from from the previous location atop the berm, with the 5.05 x 5.05 metre culvert on the left and the 1350 mm culvert in the centre.



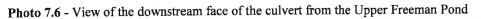





**Photo 7.7 -** Downstream face of the 1350 mm concrete pipe extending for 32 metres under the 403 west to Brant Street north/south ramp, at the northeast corner of the site.



**Photo 7.8 -** Looking downstream at the Freeman Pond from the headwall of the culvert. Note how the Purple Loostrife clearly defines the channel



### 7.6.1 Ownership Status

The Freeman Pond Site is owned by the Ministry of Transportation Ontario, with exception of a 70 metre wide strip of land along the south limit of the site, which is owned by Ontario Hydro, with an easement granted to Burlington Hydro. The Halton Region Conservation Authority also has been granted a License of Occupation for maintenance purposes. (Reference Appendix A)

# 7.6.2 Project Ingress and Egress

The Freeman Pond System is accessible through a double gated entrance located on the west side of Brant Street just south of the QEW. Access roads along the top and south side of the berm through the Hydro right-of-way and through the pond can be used to reach the channel and culverts. A 1.8 metre chainlink security fence encloses the site with gated access facilitated by Key No. 18, available through the Halton Region Conservation Authority (905-336-1158).

# 7.6.3 Project Element Maintenance

Reference Appendix B for a summary table of standard component elements of the project, along with the frequency of inspection and the methods of remediation.

# Site Reconnaissance

In order to ensure the normal operation of the "dry" storm water management pond under the range of expected flow conditions, a "walk through" inspection of the works should be carried out at least once a year. A detailed inspection of the works recording the location and types of any deficiencies, along with photographs should be carried out every five years. Information thusly collected should be catalogued and added to this manual.

# Interlocking Concrete Block Channel

During the annual inspection, the interlocking concrete block should be checked for any displacement, bulging, or heaving. The blocks should be checked to ensure that they are embedded or covered with native material (soil) and that vegetation is growing through the spaces to allow for additional stability. Any sections that may be damaged or missing blocks should be replaced and the channel should be kept clear of any debris that may inhibit that function of the channel. The underdrain system should also be inspected for any blockage of sediment or vegetation by continually monitoring the systems effectiveness and by probing the pipe.

### **Concrete Structures**

The concrete inlet and outlet structures within the site should be inspected annually and checked for any minor cracking that may be repaired by sealing or grouting. Any major areas of cracking (> 3mm), displacement, or heaving (> 5 mm), along with the separation of slabs at the expansion, control, or walls joints, requires a thorough investigation by a qualified Structural Engineer, to determine the cause and recommend remedial works.

### General/Ingress/Egress

As a storm water management facility, the condition of the berms is an integral part of the system to function properly. The slopes should be checked for stability and any signs of failure. In addition, the outlet control structure should be clear of vegetation and debris. As in the downstream channel, Purple Loosestrife is the dominant species within the should be removed. (Reference Section 6.6.4 channel and General/Ingress/Egress). Vegetation or debris that may be obstructing the culverts, channel invert, drainage or outlet pipes, should be removed. Locations for access to the channel should remain clear of any The locks and gates should be obstructions (tall/thick vegetation). checked twice a year to ensure easy access under normal or emergency conditions.

# 8. East Hager Creek Realignment and Pond System

### 8.1 **Project Description and Year of Construction**


East Hager Creek Realignment and Pond System
- QEW to North Service Road

Construction completed in 1994

The East Hager Creek was realigned through a series of three storm water detention ponds from the North Service Road to the QEW/403 outlet culvert, having a centerline chainage of 225 m. This design allowed for the channel to be lowered by 11 metres over a relatively short distance of 110 metres, while enhancing the efficiency of the system to control downstream flows entering the Freeman Detention Facility.


### 8.2 **Project Location**


The project site is located between the North Service Road and the QEW Niagara lanes, east of the QEW northbound ramp to the 403 westbound lanes, approximately 300 metres west of Brant Street.

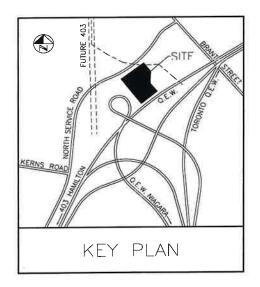


### 8.3 Design Objectives and Criteria

The channel and pond system was designed to accommodate the 100 year future land use event of 72 m<sup>3</sup>/s. The invert elevation of the North Service Road culvert is 111.2 metres, and is lowered to 100.3 metres at the QEW/403 outlet culvert of the system. While allowing for hydraulic conveyance, the ponds also provide a sediment removal and water quality enhancement function.

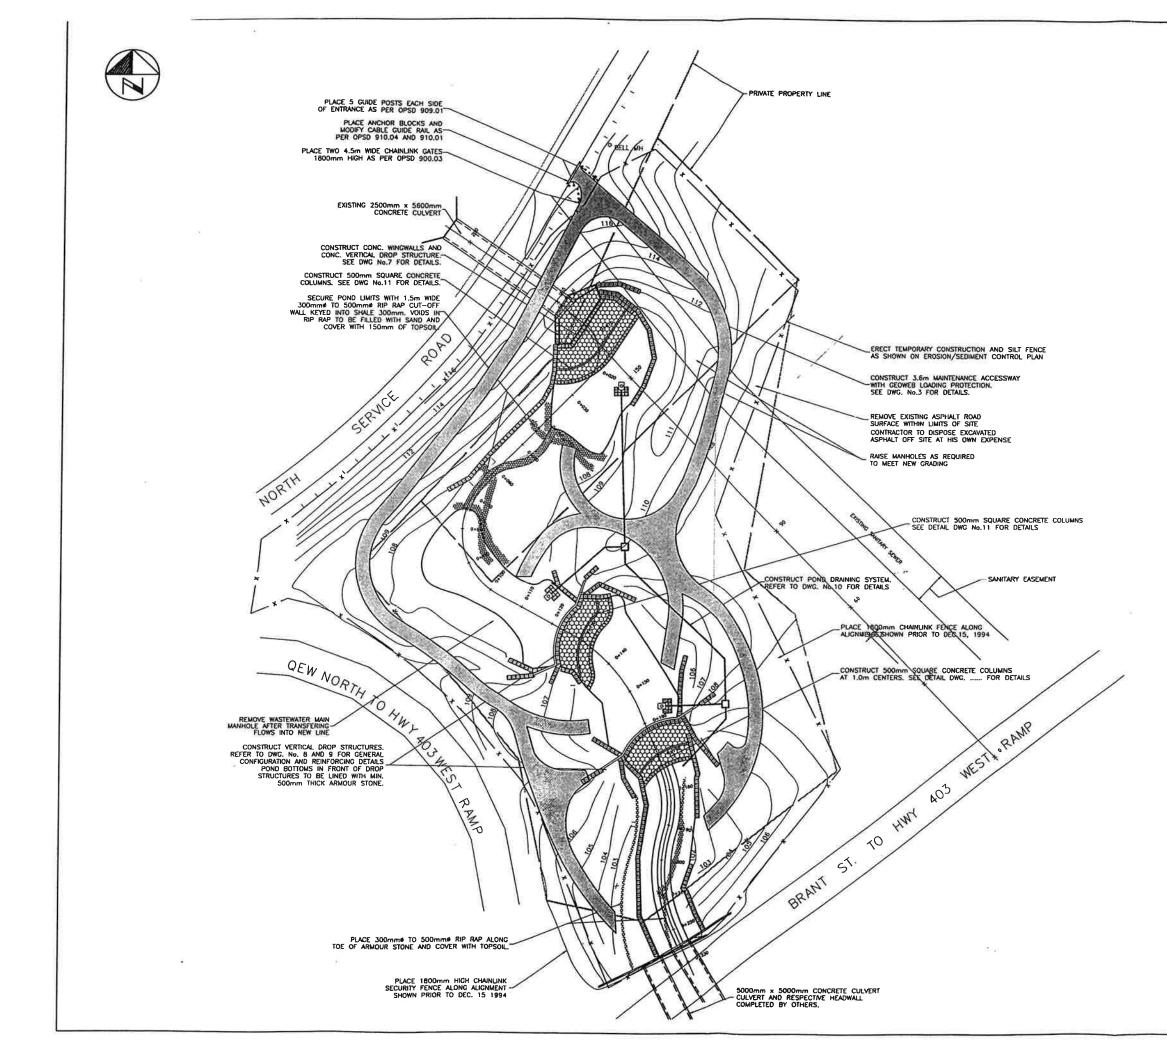

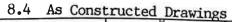

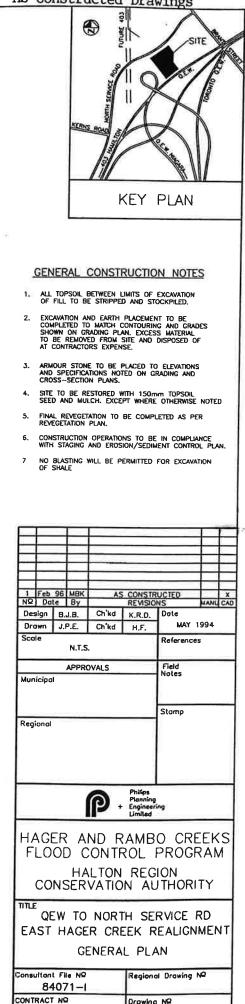

Drawing NQ SHEET 1 OF 15

# 8.5 Photographic Reconnaissance

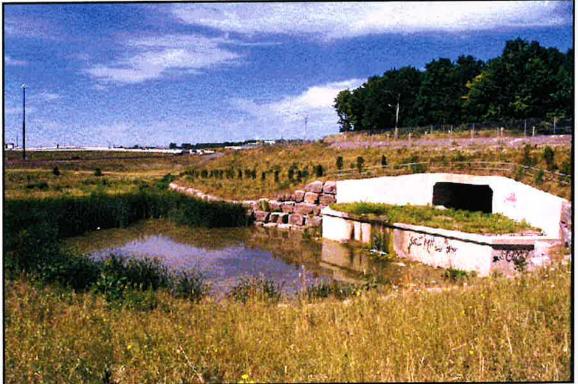


Photo 8.1 - View of the first pond (upstream limit) in the QEW-NSR system.



Photo 8.2 - Looking downstream from the North Service Road at the second and third ponds with the QEW in the background.

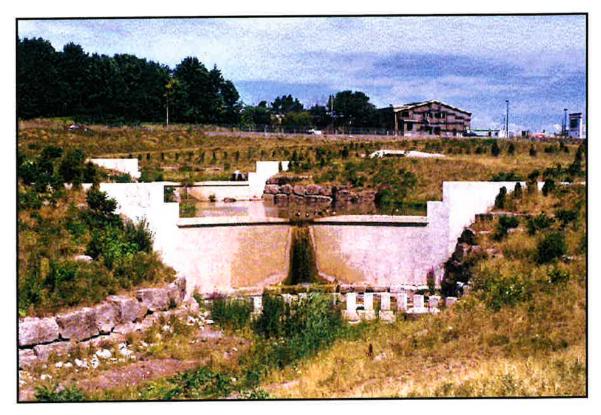


Photo 8.3 - Looking upstream at the ponds and drop structures from the Brant Street ramp to 403 west

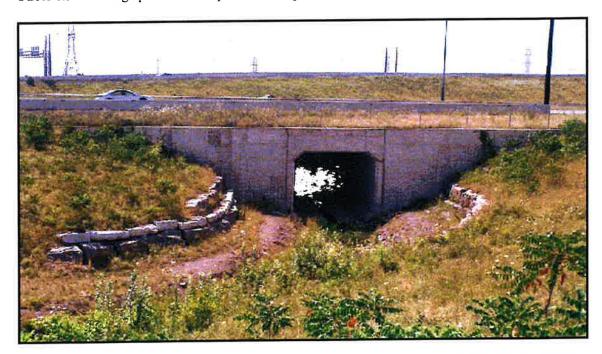


Photo 8.4 – Looking downstream at the outlet culvert of the system that conveys flows under the QEW to the Upper Freeman Pond

### 8.6.1 Ownership Status

The Ministry of Transportation owns the area of the site below the abandoned North Service Road ROW, however; the Ministry has granted an Encroachment Permit to the Halton Region Conservation Authority for this area and a License of Occupation for the lands north of the abandoned North Service Road. This does not include the North Service Road culvert, which is owned by the City of Burlington. (Reference Appendix A)

### 8.6.2 Project Ingress and Egress

The site is accessible from the North Service Road approximately 300 m west of Brant Street across from the Burlington Power Center. The site is enclosed by a 1.8 metre chainlink fence with gated access facilitated by Key No. 18, available through the Halton Region Conservation Authority (905-336-1158).

### 8.6.3 Project Element Maintenance

Reference Appendix B for a summary table of standard component elements of the project, along with the frequency of inspection and the methods of remediation.

### Site Reconnaissance

In order to ensure the normal operation of the channel under the range of expected flow conditions, a "walk through" of the works should be carried out at least once a year. A detailed inspection of the works recording the location and types of any deficiencies, along with photographs should be carried out every five years. Information thusly collected should be catalogued and added to this manual.

### Stormwater Energy Dissipation Ponds

The ponds should be inspected with regard to sediment build up and should be dredged every 10 years as necessary. These ponds contain overflow valves that are operated by sluice gates, and should be turned opened and closed at least twice a year to ensure proper operation.

### **Concrete Structures**

The concrete drop structures and dams should be inspected annually and checked for any minor cracking that may be repaired by sealing or grouting. Any major areas of cracking (> 3mm), displacement, or heaving (> 5 mm), along with the separation of slabs at the expansion, control, or walls joints, requires a thorough investigation by a qualified Structural Engineer, to determine the cause and recommend remedial works. In each pond a row of 500mm x 500mm dissipation blocks were constructed and should be checked for any deficiencies when the ponds are empty.

### Armour Stone

During the annual inspection, the stone should be checked for any degradation or displacement. Specific items to check for include intrusive vegetation and washout of backfill material. If distress is occurring, a thorough investigation is required by a qualified Engineer to determine the cause and recommend remedial works.

### General/Ingress/Egress

Vegetation or debris that may be obstructing the drop structures, overflow valves, and the outlet channel invert, should be inspected at least twice a year. Locations for access to the channel should remain clear of any obstructions. The locks and gates should be checked twice a year to ensure easy access under normal or emergency conditions.

# 9. East Hager Creek Reconstruction (North Service Road to Future Highway 407)

# 9.1 **Project Description and Year of Construction**

East Hager Creek Reconstruction


North Service Road to Future Highway 407

Construction completed in 1992

This project involved 200 m of channelization to provide a "naturally" lined, meandering watercourse, with bank stabilization to protect against erosion potential for flood flows having a frequency up to five years. A concrete cut off wall and adjoining culvert were constructed at the upstream limit to stabilize the existing creek and lower it to the future invert grade. In addition, a concrete headwall and wingwalls were added to the existing North Service Road culvert.


# 9.2 Project Location

The channel works are located between the North Service Road and the Future Highway 403 right-of-way, appoximately 300 metres west of Brant Street, adjacent to the Burlington Power Center.

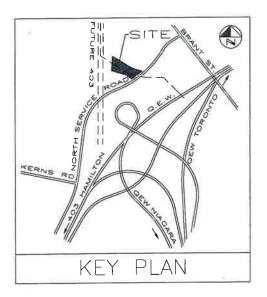


# 9.3 Design Objectives and Criteria

This channel was designed to convey the 100 year future land use flow of 72  $m^3/s$  from Highway 403 through the existing North Service Road culvert to the downstream systems having an overbank elevation of 117.0 metres at the North Service Road.

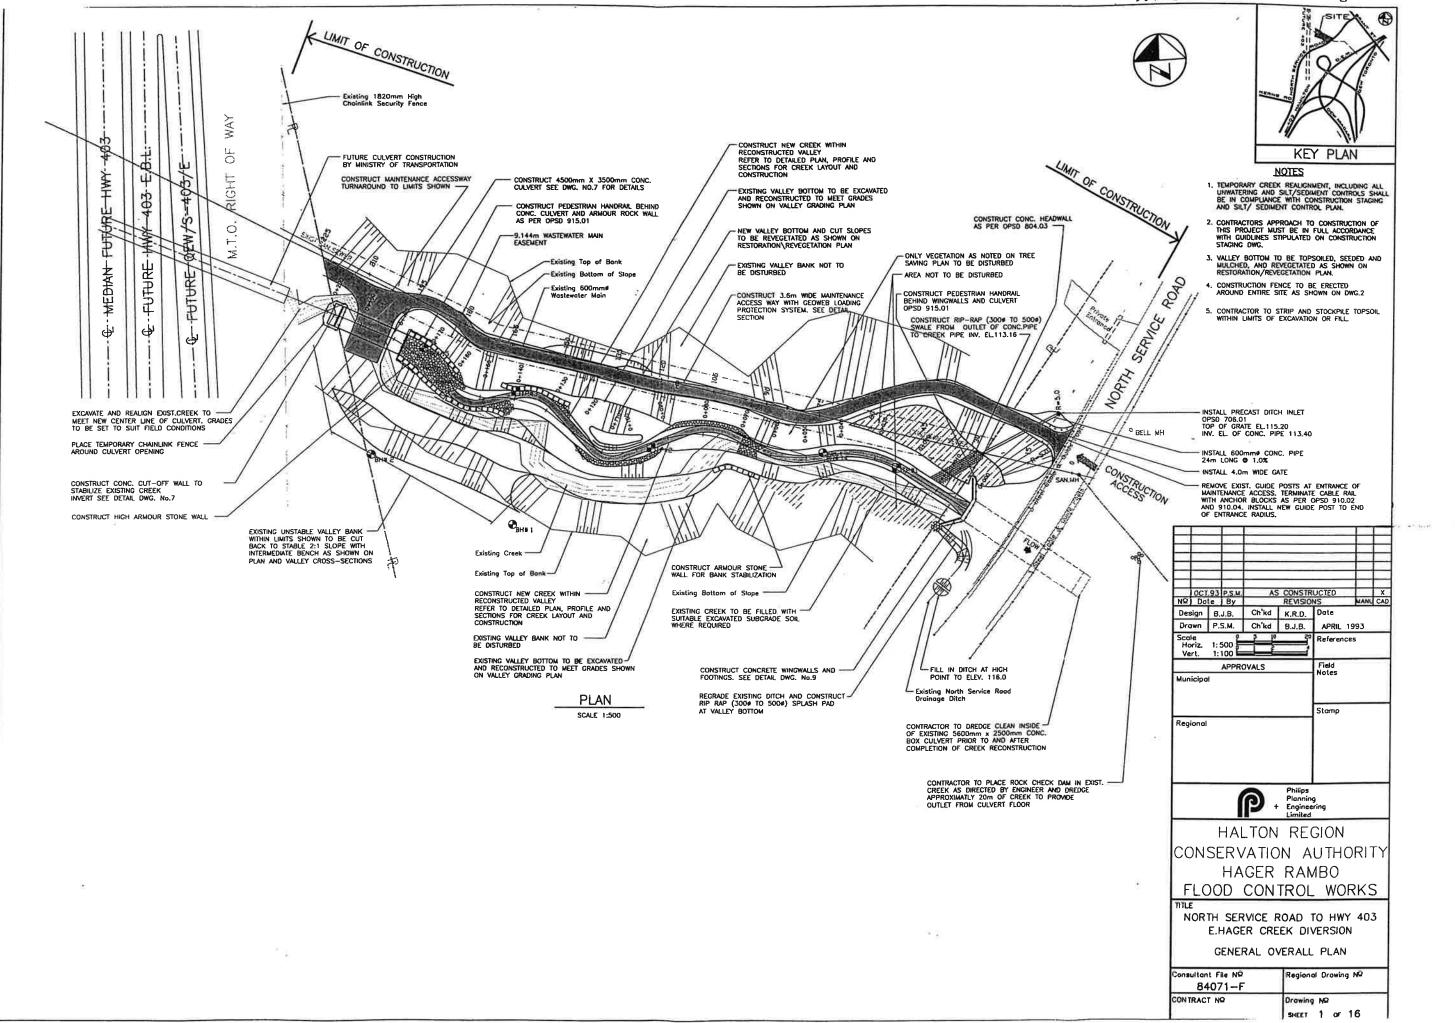

ж 8 ю.

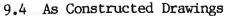

# 9.5 Photographic Reconnaissance



Photo 9.1 - Looking upstream at the channel from the North Service Road.



Photo 9.2 - Looking downstream at the North Service Road culvert.

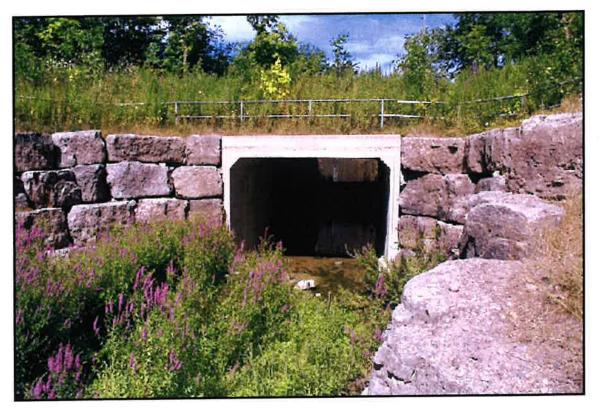


Photo 9.3 - Looking upstream towards the culvert and cut-off wall structure



Photo 9.4 - Looking downstream from atop the culvert 4.5 x 3.5 metre culvert. Note the broken handrail and high concentration of Purple Loosestrife.





Photo 9.5 - Looking down into the cut-off wall structure at the upstream limit of the works



Photo 9.6 - Looking downstream from the future Highway 403 right-of-way.

### 9.6.1 Ownership Status

The site of the East Hager Creek Channel Reconstruction is owned by the Halton Region Conservation Authority (Parts 1-4, Plan 20R-11144, (Reference Appendix A). In addition, a 9.1 metre wide wastewater main easement (Part 2) extending the length of the site to the north of the channel, has been assumed by the Regional Municipality of Halton.

# 9.6.2 Project Ingress and Egress

The site is accessible from the North Service Road on the north side of the creek, through a single 4 metre wide gate. The maintenance accessway extends along the north side of the channel, to the limit of construction with a turnaround area over the culvert. A chainlink security fence does not enclose the site, although the gate off of the North Service Road is facilitated by Key No. 18, available through the Halton Region Conservation Authority (905-336-1158).

# 9.6.3 Project Element Maintenance

Reference Appendix B for a summary table of standard component elements of the project, along with the frequency of inspection and the methods of remediation.

# Site Reconnaissance

In order to ensure the normal operation of the channel under the range of expected flow conditions, a "walk through" of the works should be carried out at least once a year. A detailed inspection of the works recording the location and types of any deficiencies, along with photographs should be carried out every five years. Information thusly collected should be catalogued and added to this manual.

# **Concrete Structures**

The concrete vertical drop structure should be inspected annually and checked for any minor cracking or spalling that may be repaired by sealing or grouting. Any major areas of cracking (> 3mm) or displacement along expansion, control, or walls joints, requires a thorough investigation by a qualified Structural Engineer, to determine the cause and recommend remedial works.

### Armour Stone

During the annual inspection, the stone should be checked for any degradation or displacement. Specific items to check for include intrusive vegetation and washout of backfill material. If distress is occurring, a thorough investigation is required by a qualified Engineer to determine the cause and recommend remedial works.

# General/Ingress/Egress

The channelization of East Hager Creek at this location utilizes the function of a "natural" channel system. As in the downstream sites, Purple Loosestrife is the dominant invasive species within the channel and should be removed in order to ensure maximum efficiency of the ecosystem. Larger debris (fallen trees, etc.) that may be obstructing the culverts or channel should be removed.

Rip-rap has been used for erosion protection on the outside banks. This component should be checked for any signs of degradation, displacement, erosion of backfill material, or the exposure of the geotextile material. Locations for access to the channel should remain clear of any obstructions. The gate and lock should be checked twice a year to ensure easy access under normal or emergency conditions.

# 10. West Hager Detention Facility

# 10.1 Project Description and Year of Construction


West Hager Creek Realignment and Detention Facility

Construction completed in 1993

The project required the excavation of  $9,500 \text{ m}^3$  of earth from the existing valley floor and the construction of a structural earth berm. In addition, approximately 347 metres of the existing creek was realigned to provide a 2.3 metre wide low flow rip-rap lined channel. The outlet works included the installation of a 1.44 x 1.44 x 42 m concrete box culvert and erosion control to the channel leading from the outlet to the existing North Service Road culvert


# 10.2 Project Location


The site is located on the north side of the North Service Road, west of Kerns Road, adjacent to the Crossroads Ministry lands.

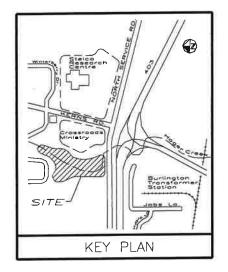

# 10.3 Design Objectives and Criteria

This system was designed to store the Regional event to an elevation of 116.2 m allowing a 0.3 m freeboard, and regulates the outlet flow from the system to 15.6  $m^3$ /s to control downstream flows to the Fairview Street culvert capacity.

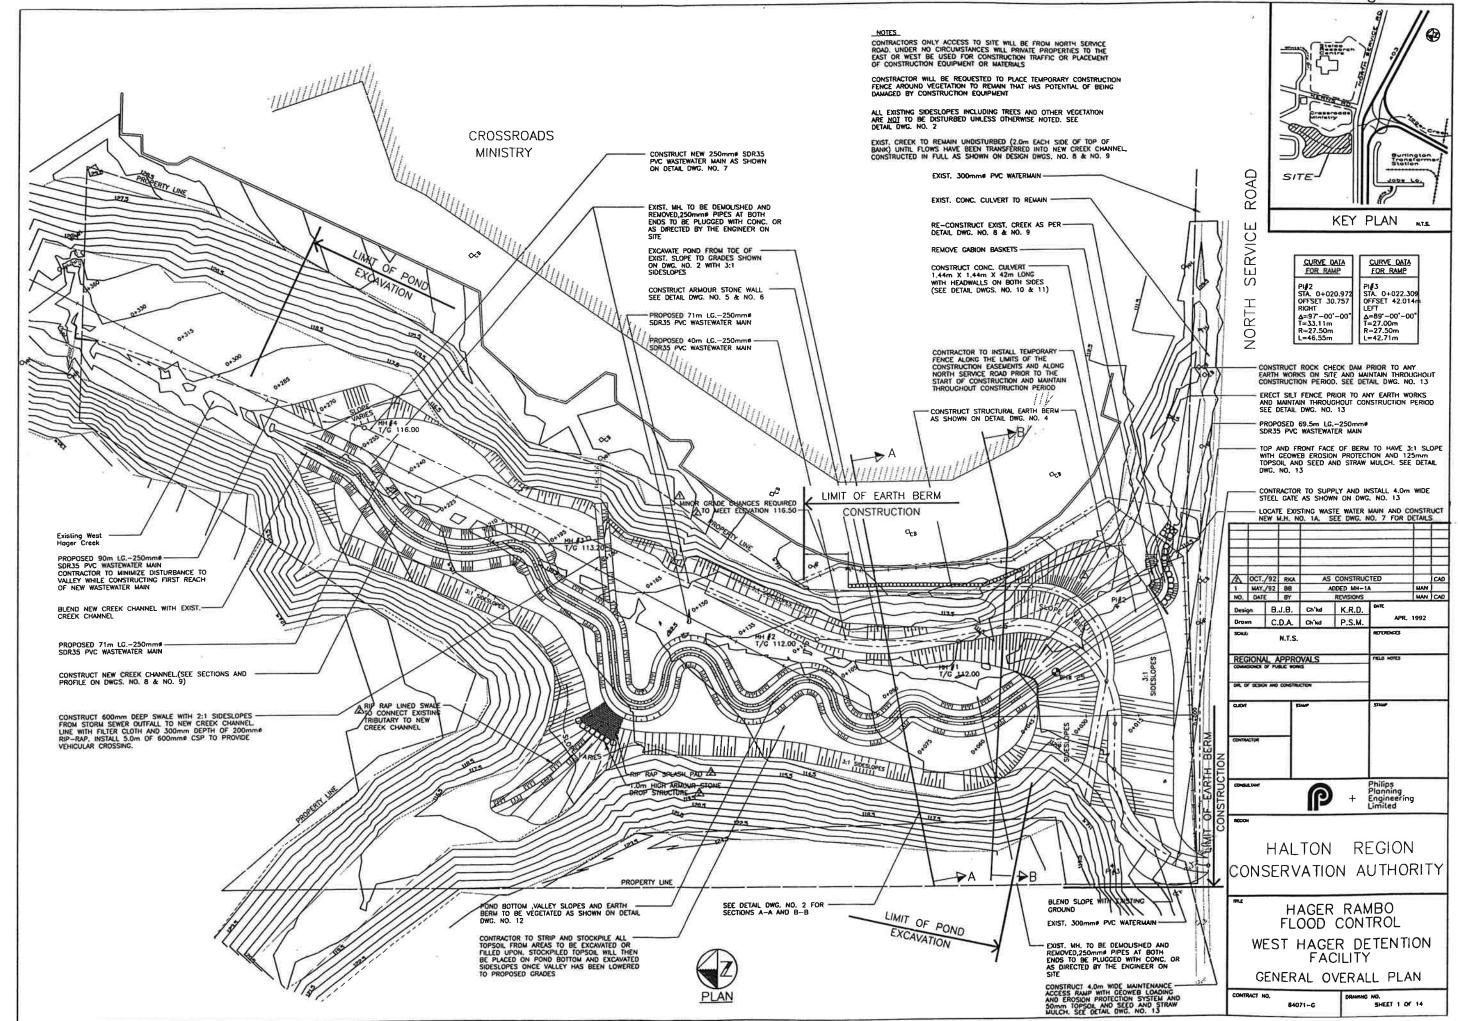

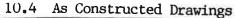

### 10.5 Photographic Reconnaissance



Photo 10.1 - View of the upstream side of the culvert crossing under the North Service Road. Note the debris blocking the culvert opening.



Photo 10.2 - View of the detention facilities outlet culvert from the downstream side, taken from the North Service Road.





Photo 10.3 - Upstream view of the facility from atop the berm.



**Photo 10.4** - Looking upstream towards the limit of the site from the maintenance accessway at station 0+180.

### 10.6.1 Ownership Status

The West Hager Creek Detention Facility is owned by The City of Burlington, with the Halton Region Conservation Authority having an easement agreement with the city for maintenance purposes. (Reference Appendix A).

### 10.6.2 Project Ingress and Egress

The site is accessible from the North Service Road approximately 300 metres west of Kerns Road next to the Crossroads Ministry property. An access road was constructed across the top of the berm and running parallel to the creek along the east side. Safety fencing does not enclose the facility, therefore keys for gated access are not required.

### 10.6.3 Project Element Maintenance

Reference Appendix B for a summary table of standard component elements of the project, along with the frequency of inspection and the methods of remediation.

### Site Reconnaissance

In order to ensure the normal operation of the stormwater management facility under the range of expected flow conditions, a "walk through" of the works should be carried out at least once a year. A detailed inspection of the works recording the location and types of any deficiencies, along with photographs should be carried out every five years. Information thusly collected should be catalogued and added to this manual.

### **Concrete Structures**

The North Service Road and outlet culvert should be inspected annually and checked for any minor cracking or spalling that may be repaired by sealing or grouting. Any major areas of cracking (> 3mm) or displacement along expansion, control, or walls joints, requires a thorough investigation by a qualified Structural Engineer, to determine the cause and recommend remedial works.

### Armour Stone and Rip-Rap

During the annual inspection, the armour stone should be checked for any degradation or displacement. Specific items to check for include intrusive vegetation and washout of backfill material. Rip-rap has been used for the channel lining and should be checked for any signs of degradation, displacement, erosion of backfill material, or the exposure of the geotextile materials.


# General/Ingress/Egress


As a storm water management facility, the condition of the berm and valley walls is an important feature of the system to function effectively. The slopes should be checked for stability and any signs of failure. The channelization of West Hager Creek at this location utilizes the function of a "natural" channel system as well.

As in the downstream sites, Purple Loosestrife is the dominant species within the channel and should be removed in order to ensure the efficiency Of the natural ecosystem. (Reference Section 6.6.4). Larger debris (fallen trees, etc.) that may be obstructing the culverts or channel should be removed.


# **APPENDIX 'A'**

# **PROPERTY PLANS**

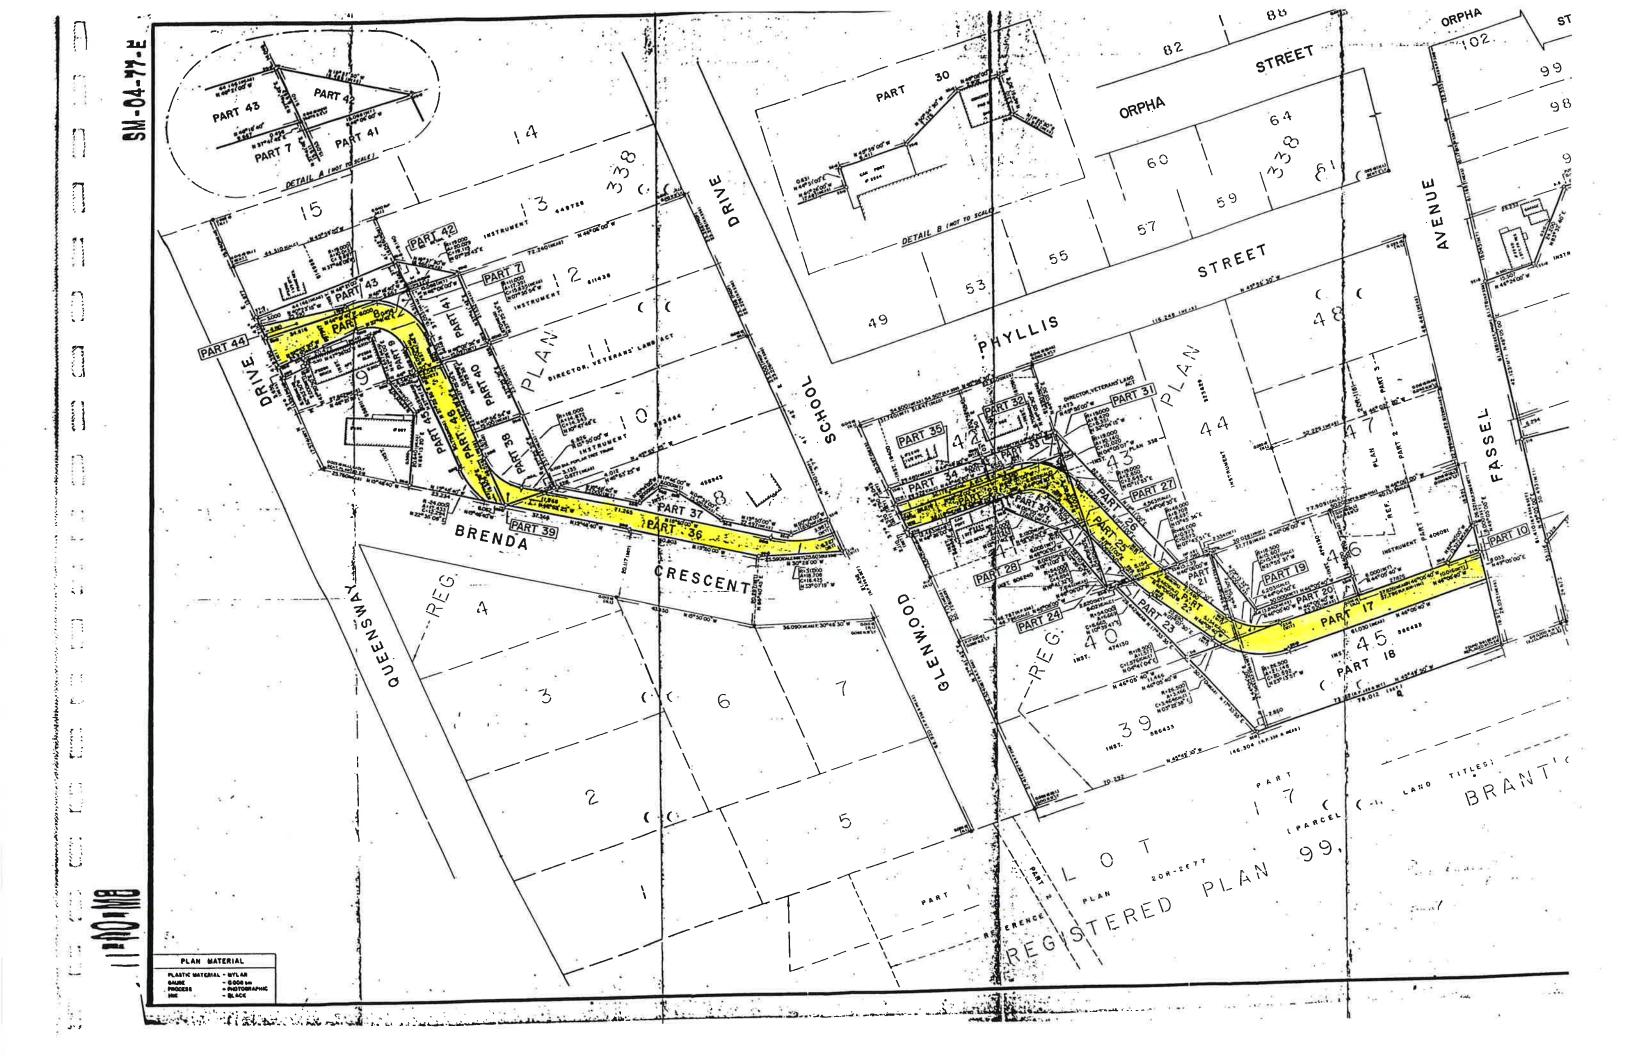


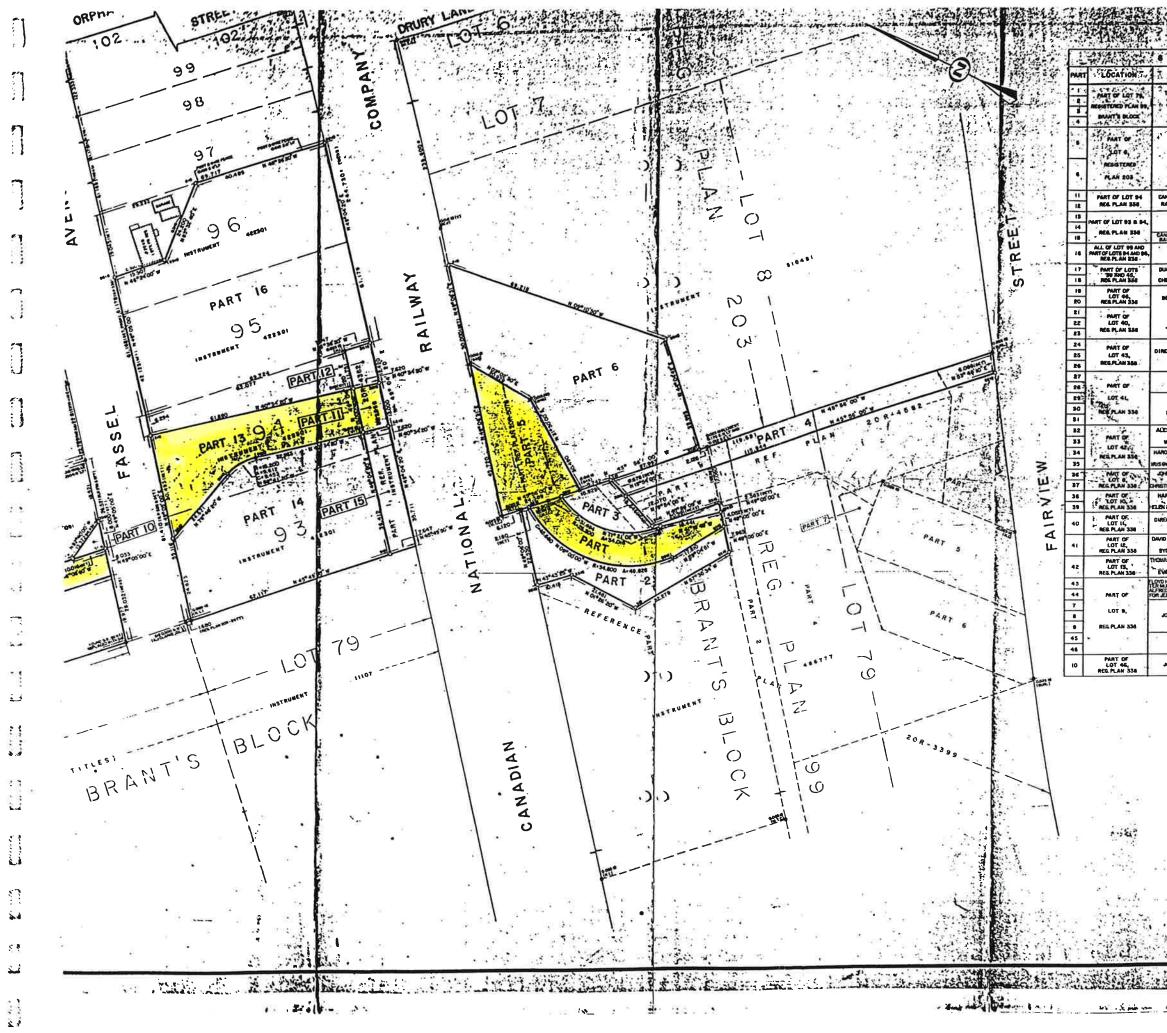


|  | 30,000                                 |                        |          | . 014        | <b>P</b>              | ATT REAL PARTY OF   |
|--|--|------------------------|----------|--------------|-----------------------|---|
|  | S C H E                                | D'U'L E                | 1400 A   | : 1930       | 564                   | allanch Hall &  |
|  | TOWNER                                 | INSTRUMENT             |          |              |                       | TI ONTALLA LAND BURYTON OF  |
|  |  |                        |          |              | URANI                 | THE CITY OF BURLINGTON  |
|  | TRANSIT                                | 484777                 | 1.10     |              |                       | CAUTION THIS PLAN IS NOT A PLA  |
|  |  | 4.44                   |          | _            |                       |   |
|  |  | SI0481                 | 1.00     |              | <b>第秋</b>             | File  |
|  | BOUGLAS                                | BUBJECT TO<br>EASEMENT | 707.48   |              |                       | Cort.   |
|  | ROY                                    |                        | 0.0.0    |              |                       |   |
| Concernment         Series         Description           Series         Series         Series         Series           Series         Series         Series         Series <td>LEGGAT</td> <td></td> <td>· · .</td> <td></td> <td></td> <td>PLAN</td>  | LEGGAT                                 |                        | · · .    |              |                       | PLAN  |
| 33, 40, 41, 42, 43, 45, 46, An           30, 40, 41, 42, 43, 45, 46, An           30, 40, 41, 42, 43, 46, An           30, 41, 42, 42, 43, 46, An           30, 41, 42, 41, 42, 43, 46, An           30, 41, 42, 41, 42, 41, 42, 41, 42, 41, 42, 41, 42, 41, 42, 41, 42, 41, 42, 41, 42, 41, 42, 41, 42, 41, 42, 41, 42, 41, 41, 41, 41,  | RAILINKY COMPANY                       | 622958                 |          | 82.834       | 1                     |   |
|  | EDWARD                                 | 422301                 | 1014.724 | E217.44+     | × . :                 |   |
|  | CAULDIAN MATIONIAL<br>RAILIMAY COMPANY | \$22.958               |          | £74.764      | 1.000                 | AND   |
| BARTE 2004         BARTE 2  | ETHNARD                                | 422301                 |          | 4387.70      | 19 m                  | ALL OF LOTS 45, 93, 94 AND  |
|  | DUARTE & BOUSA                         |                        | 638.24+  | *            | 1 A                   | REGISTERED PLAN 338   |
| BELLEVIE         PART OF LOT 6,<br>State         PART OF LOT 6,<br>State           AU         State         State         State           AU         State         State         State           State         State         State         State           State <t< td=""><td>AND</td><td>\$65433</td><td></td><td>17-3404</td><td>10</td><td>AND</td></t<>   | AND                                    | \$65433                |          | 17-3404      | 10                    | AND   |
| MO         MO         REGISTERED PLAN 2           LAD AT         REAL         REGISTERED PLAN 2           LAD AT         REAL         REAL           AT         REAL         REAL           AT         REAL         REAL           REAL         REAL         REAL           REAL <t< td=""><td>DENJAMIN LEWO</td><td>474130<br/>(FIRSTLY)</td><td>69.48°</td><td>944 184</td><td>- 2</td><td>PART OF LOT 8,</td></t<>   | DENJAMIN LEWO                          | 474130<br>(FIRSTLY)    | 69.48°   | 944 184      | - 2                   | PART OF LOT 8,  |
|  | AND                                    |                        |          |              |                       | REGISTERED PLAN 203   |
|  | JEAN BLEWR                             | 474130<br>(SECONDLY)   | 246.894  |              |                       | AND   |
|  |  |                        |          | 207.56       | 88,814                | PART OF LOT 79,   |
|  |  | PLAN 338               | 226.76+  |              | 34.41-                |   |
|  | 12 15.                                 |                        |          | 248.35       |                       |   |
| Autra L<br>strongen         Hesses         Hesses         BADY           Altra L<br>strongen         Hesses         BADY         BADY         BADY           Mark Balewords         Hesses         BADY         Hesses         CITY OF BURLINGT           Mark Balewords         BADY         BADY         BADY         BADY         BADY           Mark Balewords         BADY         BADY         BADY         BADY         BADY         BADY           Mark Balewords         BADY         BADY         BADY         BADY         BADY         BADY           Mark Balewords         BADY         BADY         BADY         BADY         BADY         BADY         BADY           ADY LLB         Strongen         BADY         BADY         BADY         BADY         BADY         BADY         BADY           ADY LLB         Strongen         BADY         BADY         BADY         BADY         BADY         BADY         BADY         BADY   | MARIE                                  | - 406240               | 4,841    | 74 44        | ( t. 1                |   |
|  |  | - ×                    | 363.72+  |              |                       | GEOGRAPHIC TOWNSHIP OF NELSON   |
|  |  | 568662                 |          | 106.50/      |                       | NOW IN THE  |
| Mage Market Register         Faces         REGIONAL MUNICIPALITY OF HAL           Market Register         140000         70224         6000           April Good Tables         140000         70224         6000           April Good Tables         140000         70224         6000           April Good Tables         283.64         77.68         77.68           April Good Tables         283.64         77.68         77.68           April Good Tables         283.64         77.68         77.68           April Good Tables         14.33         347.14         76.60           April Good Tables         14.33         347.84         76.60           April Control With Mark         14.33         76.76         76.00           April Control With Mark         14.33         76.76         76.00           A  |  |                        | 25 801   |              | 20.46*                | CITY OF BURLINGTON  |
| ABOYON WAR ARANGE ARANG   | AND                                    | * 16(09)               |          | 132.44       |                       | REGIONAL MUNICIPALITY OF HALTON   |
| INSUECCOLOR FRAME<br>PERIOD RECEIPTION AND THE SECOND SECOND SECOND RECEIPTION AND THE SECOND RECEIPTION AND AND AND AND AND AND AND AND AND AN  |  | 194000                 |          | 145.99       |                       | SCALE-I-500   |
| with a different       459953       27788         MARY AND WIT FOW       433483       53224         Inder Control Moderne       61635       37788         Mary Brocked Intercet       61035       123564         Jone Nacria       40509       33564         Jone Nacria       33564       38660         Jone Nacria       40509       33660         Jone Nacria       60509       38600         Jone Nacria       60509       38600         Jone Nacria       60509       84       605078         Jone Nacria       605078       60078       60078  | IS OND DOLLAE FEMOR                    | 1.0                    |          |              | 1. E I                | · · · · · · · · ·   |
| NUME         283483         28328         1986           Lik COTTINI VACENCE         283483         347.54           AND DECOM VENE         611436         347.54           AND ALL RULE         64327         265.99           AND LEV         537667         44327           AND LEV         53767         44327           AND LEV         53801         355.64           AND LEV         557667         60.091           BEARING NOTE         EARNES RECOVER AND LEVENT REAL ACTURE           CONN MACTURE         60.001         557.500777           AND LEVENT REAL ACTU  | AND .                                  | 458943                 |          |              | 1157                  | WILL THE SAME ALLAN CHALL OLS Y WAT   |
| LIB CONTINUEDERS AND THE CAR START FLAM START AND RECORD VECTOR V   | HARRY BACKEWICH                        | 203468                 | 3        | 293.234      | 1.5                   | 1986 1 1  |
| LAND RECARD WHEN WE CAN<br>WE DRAWN WHEN WHEN WHEN WHEN WHEN WHEN WHEN WH  |  |                        | 63.854   |              |                       |   |
| BYTEM KALL       614358       337.01         BUDG STEMENT       419726       4337.01         PRIME WITHOUT       149726       4337.01         BYTEM KERNENT       419726       4337.01         ADVIN WEELMOTT       527867       628.01         SUBATES HARDING NOTE       18       658.01         BEARING NOTE       100       18<  |  | PLAN 338               | <u>5</u> | 347.144      | 18 I.                 |   |
| STORA GLUE REL<br>BY AN OTHER<br>BY AN OTHER<br>BY AN OTHER<br>BY AN OTHER<br>SON WELLOW<br>SON WELLOW<br>SON<br>SON<br>SON WELLOW<br>SON<br>SON<br>SON<br>SON<br>SON<br>SON<br>SON<br>SON   |  | 611438                 |          | 347.814      |                       | 17  |
| EW AWE STEWENT     449726     449726     449726     449726       DEV AWE STEWENT     449726     206,599     80724     120210       DOWN WEELHOFT     557867     443,977     202,777     1002,777       AOVI LEW     353801     335,664     1002,777     1002,777       AOVI LEW     353,664     1002,777     1002,777     1002,777       AOVI LEW     353,664     1002,777     1002,777     1002,777       AOVI LEW     350,664     1002,777     1002,777     1002,777       BEARING NOTE     BEARING NOTE     1000,777,777     1002,777       BEARING NOTE     BEARING NOTE     1000,777,777 <td>SYDNA GAIL BELL</td> <td></td> <td></td> <td></td> <td></td> <td></td>   | SYDNA GAIL BELL                        |                        |          |              |                       |   |
| DEVELOPMENT       SLASSE       SLASSE       SLASSE       METRIC         JOIN WEELMOT       SSZECT       42.327       Internet of the state of the   | AND                                    | 449726                 |          | 64.55        |                       |   |
| ADVISUATE CONTRACTOR OF THE CONTRACT OF THE SHOWN OF THE  | MD HOLLENEROX, ONES-                   | 514988                 |          | 266.99       |                       | 8   |
| METRIC<br>METRIC<br>METRIC<br>Distances shown on this PLAM<br>IN METRES AND CAR BE CONVERTE<br>TO FEET BY DIVIDING BY 0.3048<br>METRIC AB ECONVERTE<br>TO FEET BY DIVIDING BY 0.3048<br>BEARING NOTE<br>BEARING NOTE<br>BE   | R JEHOVAH'S WITHESES                   |                        |          |              | - 1                   |   |
| ADV LEW 353841<br>335.647<br>JOHN HAGVAN 406081<br>335.647<br>JOHN HAGVAN 406081<br>JOHN HAGVAN 4070 HAVAN 4070 HAVAN 4080 HAVAN 408   | JOHN WEELHOFF                          | 557967                 |          |              |                       |   |
| ADVI LEV 338811 335.647<br>JOHN MAGYAM 406081 335.647<br>JOHN MAGYAM 406081 38500<br>BEARING NOTE<br>BEARING | 2                                      |                        |          |              | .                     |   |
| JONN MAGYAR     406001     38.00       BEARING NOTE     BEARING NOTE       BEARING RECONDER CRISSOTS, DUSTBODYS AND DASTBODYS AND DASTBODYS AND DASTBODYS AND ANE REFERED TO<br>CENTRAL MERIDAN BITO DO COVERET LONGITURE OF ZONE IT AND ARE REFERED TO<br>CENTRAL MERIDAN BITO DO COVERET LONGITURE OF ZONE IT AND ARE REFERED TO<br>STA BAUEST BRANCH TO DO COVERET LONGITURE OF ZONE IT AND ARE REFERED TO<br>STA BAUEST BRANCH TON BAR     63       LEGEND     0     0     DEDOTES FOAD<br>STA BOARD IRON BAR     63       STA BOARD STA AND ARE DUSTES TRANGADD IRON BAR     63     DEMOTES FOAD<br>STA BOARD IRON BAR     63       STA BOARD STA AND ARE DUSTES MONTHAND     STA BOARD IRON BAR     MITE CONCESS AND<br>STA BOARD IRON BAR     MITE CONCESS AND<br>AND THE REMARK AND IRON BAR     MITE CONCESS AND<br>AND THE REMARK TAND THE CONCEST AND IN ACCORDANCE WITH THE BURN<br>AND THE REMARKY CONTRY THAT -       L THE SUMMEY AND TOP ANAL CONTRY THAT -     L THE SUMMEY AND DAR COMPETER AND THE ACCORDANCE WITH THE BURN<br>AND THE REMARKY ON THE CONCEST AND IN ACCORDANCE WITH THE BURN<br>AND THE REMARKY AND USE  | JUDY LEW                               | 558941                 | 115 641  | 366.07       |                       |   |
| BEARING NOTE<br>BEARING NOTE<br>BEARING NEED<br>DIESSOFS, CHISTO SCARINGS, CERIVED FROM HORIZONTAL CONT<br>OCISSOFS, CHISTOP, CHISTOPOT AND CHIZONTAL CONT<br>OCISSOFS, CONTES FLANED<br>STA ADJASTBERT.<br>LEGEND<br>SIB - DENOTES FLANED<br>SIB - DENOTES FLANAD<br>SIB - DENOTES FLANAD IRON BAR<br>SIB - DENOTES FLANATE<br>SIB - DENOTES FLANAD IRON BAR<br>SIB - DENOTES FLANATE<br>SIB - DENOTES FLANATION IRON BAR<br>SIB - DENOTES FLANATION IRON BAR<br>NL - DENOTES FLANATION<br>SIB - DENOTES FLANATION IRON BAR<br>NL - DENOTES FLANATION<br>SIB - DENOTES FLANATION IRON BAR<br>SIG - DENOTES FLANATION IRON  |  |                        | 333.00   |              |                       |   |
| BEARING NOTE<br>BEARINGS HEREON ARE GRID BEARINGS, DERIVED FROM HORIZONTAL CONTE<br>ORISSON, DOIESSON, DAYSBODY AND ARE FEFERED T<br>CENTRAL BERIDAR HEROL<br>1874 ADJASTRENT.<br>LEGEND<br>9 DEDOTES FLANTED<br>9 DEDOTES FLANTED<br>9 DEDOTES FLANTAD<br>9 DEDOTES FLANTAD INON BAR<br>9 DEDOTES FLANTAD<br>9 DEDOTES FLANTAD INON BAR<br>9 DEDOTES FLANTAD INON BAR<br>10 DEDOTES FL   | JOHN MAGYAR                            | 406091                 |          | . (          |                       | 27 H. 2   |
| BEARINGS HEREON ARE GRID BEARINGS, DERIVED FROM HOW 20NTAL CONT<br>ODESDOTE, DOIESDOTE, DATE DEVOTO: WEST LONGTIDE OF ZONE TAND ARE BE<br>1974 ADJASTRENT.<br>LEGEND<br>B. DENOTES FOLKD<br>G. DENOTES FOLKO<br>G. DENOTES<br>G. DENOTES FOLKO<br>G. DENOTES FOLKO<br>G. DENOTES<br>G.   |  |                        |          | 1            | 0                     |   |
| LEGEND<br>B. DENOTES FOLNO<br>G. DENOTES FANACADD INCN BAR<br>SIG - DENOTES READADD INCN BAR<br>SIG - DENOTES READADD INCN BAR<br>SIG - DENOTES READADD INCN BAR<br>R.L DENOTES INCN<br>SURVEYOR'S CERTIFICATE<br>MERGAT CONFET AND IN ACCORDANCE WITH THE SURV<br>AND THE REGISTRY AND THAN ARE CONDANCE WITH THE SURV<br>AND THE REGISTRY AND THAN ARE CONDANCE WITH THE SURV<br>AND THE REGISTRY AND THE REALTONS MADE THERELADER.<br>2. THE SURVEY WAS COMPLETED ON THE 28M DAY OF JANUARY, 1995.<br>  |  |                        |          |              |                       |   |
| LEGEND<br>B. DENOTES FOLNO<br>G. DENOTES FANACADD INCN BAR<br>SIG - DENOTES READADD INCN BAR<br>SIG - DENOTES READADD INCN BAR<br>SIG - DENOTES READADD INCN BAR<br>R.L DENOTES INCN<br>SURVEYOR'S CERTIFICATE<br>MERGAT CONFET AND IN ACCORDANCE WITH THE SURV<br>AND THE REGISTRY AND THAN ARE CONDANCE WITH THE SURV<br>AND THE REGISTRY AND THAN ARE CONDANCE WITH THE SURV<br>AND THE REGISTRY AND THE REALTONS MADE THERELADER.<br>2. THE SURVEY WAS COMPLETED ON THE 28M DAY OF JANUARY, 1995.<br>  |  |                        | 200      |              | BEARING<br>0016530    | S HEREON ARE GRID BEARINGS, DERIVED FROM HORIZONTAL CONTROL MC<br>78, 001655079, 043760073 AND 043760074 AND ARE REFERED TO THE       |
| B - DENOTES FOLNO<br>DENOTES FRANTED<br>SIB - DENOTES ITANACARD INON BAR<br>SIB - DENOTES MEANTED<br>SIB - DENOTES<br>SIB - DENOTES<br>SIB - DENOTES  |  |                        |          |              | 1974 AD               | JUSTMENT.   |
|  |  |                        |          | - 1          |                       |   |
| SITE - DENOTES SUCHT STANDARD INCN BAR<br>BUIL - DENOTES MUNIN<br>RIB - DENOTES ROUND IRON FAR<br>RIB - DENOTES ROUND IRON FAR<br>RIL - DENOTES MUNIN<br>SURVEYOR'S CERTIFICATE<br>INCL - DENOTES MUNIN<br>RIL - DEN   |  |                        |          |              | £18 ~                 | DENOTES FOUND 18 - DENOTES INCO BAN<br>DENOTES PLANTED 646 - DENOTES ILG SEVEL(<br>DENOTES STANDARD IRON BAR 655 - DENOTES MACKAY, MA |
| SURVEYOR'S CERTIFICATE<br>HEREBY CORINEY THAT:<br>L THE SURVEY AND PLAN ARE CONRECT AND IN ACCORDANCE WITH THE SURV<br>A THE BURNEY WAS CONFECTED ON THE 28D DAY OF JANUARY, 1985.<br>   |  |                        |          |              |                       | DENOTES SHOPT STANDARD INCH BAR BURL + DENOTES CITY OF BU   |
| L THIS BARVEY MAD PLAN ARE CONDUCTED AND IN ACCOMPANES WITH THE BARV<br>AND THE REGISTRY ALT AND THE REGISTRATALITORS MADE THEREARDER.<br>2. THE BURNEY WAS COMPLETED ON THE 28M DAY OF JANUARY, 1985.<br>   |  |                        |          |              |                       | ICL - DENVIES INVITUATION   |
| L THIS BARVEY MAD PLAN ARE CONDUCTED AND IN ACCOMPANES WITH THE BARV<br>AND THE REGISTRY ALT AND THE REGISTRATALITORS MADE THEREARDER.<br>2. THE BURNEY WAS COMPLETED ON THE 28M DAY OF JANUARY, 1985.<br>   |  | 100 A                  |          | .)]          | HEREBY                | CONTINY THAT -  |
| 2. THE BURNEY WAS COMPLETED ON THE 28M DAY OF JANUARY, 1985.<br>   |  |                        |          |              | L THIS SUR<br>AND THE | VEY AND PLAN ARE CORRECT AND IN ACCORDANCE WITH THE BURVEYS AC REGISTRY ACT AND THE REGULATIONS MADE THEREUNDER.                      |
| CITY OF BURLINGTON<br>DEPARTMENT OF PUBLIC WORKS-SURV<br>426 DRANY STREET<br>UNITY IT. I.  |  |                        |          |              | 8. THE SUR            | VEY WAS COMPLETED ON THE 29M DAY OF JANUARY, 1985.  |
| CITY OF BURLINGTON<br>DEPARTMENT OF PUBLIC WORKS-SURV<br>426 DRANT STREET<br>UNITY IT I. I ALL FILL BOOK<br>DRAY IT I. INFORMAL<br>RAMBO CREEK- EAST BRANCH FROM<br>FA BVIEW STREET TO QUEENSWAY<br>DR YE<br>DR YE   | 3 <b>8</b> 0                           |                        |          |              | <b>41.</b>            | MUARY RM. 1994  |
| DEPARTMENT OF PUBLIC WORKS-SURV<br>UNIT TITE T A ALE FIELD BOOK COMPUTED BY D KUMAN<br>ONANG TITE A GOMERAN<br>ONANG   | N                                      |                        |          | _1           |                       |   |
| 426 DRANT STREET<br>UNITY IT. F.Y. & 4.E. FIELD BOOK COMPUTED BY D. KUMAN<br>DRAY BY: 6. BENERAL PIELD BOOK DATE<br>DRAY BY: 6. BENERAL DATE<br>RAMBO CREEK-EAST BRANCH FROM PI<br>FAI BVIEW STREET TO QUEENSWAY 1<br>DR YE<br>FIELD BOOK HER 12 SEE<br>INTERCEPTING DIFFERENCE SEE<br>INTERCEPTING DIF   | • X.                                   | 1                      |          | 1            |                       | CITY OF BURLINGTON  |
| RAMBO CREEK- EAST BRANCH FROM PIL<br>RAMBO CREEK- EAST BRANCH FROM PIL<br>FA BVIEW STREET TO QUEENSWAY<br>DR VE  |  |                        |          |              | UEPAR                 | IMENT OF PUBLIC WORKS - SURVEY  |
| RAMBO CREEK- EAST BRANCH FROM<br>FAIRVIEW STREET TO QUEENSWAY<br>DR YE   | - 141 ( <b>1</b> 42)                   | s - x                  |          | SURV T       | EY + F.Y. &           |   |
| FA RVIEW STREET TO QUEENSWAY<br>DR YE  | 8                                      | 1. Aug.                |          | DRAID B      | Y                     |   |
|  | к. —                                   | 1.1                    | 2        | RAM          | BO C                  |   |
| FEB 12 1865  |  | 18 × 1                 |          | FAIR         | VIEW                  | STREET TO QUEENSWAY SM-(  |
|  | 51854                                  | A.1                    | ~        | DRI          | E                     |   |
|  | · · · · ·                              | -(i <sup>22</sup>      | t 167 J  | YV           | *                     | FEB 1,2 1985  |
|  | FEN - ML                               | ènita d                |          | , F. YE      | 14                    | Ultrate   |
| s≓ en andara subara ta an bas dikendika  |  |                        |          | 2            |                       | A second second second  |
|  | s =s                                   | 8                      |          | . <u>9</u> . | с - <del>8</del>      | aslan an 1 a sa 1 kun Blin <del>Mad</del> 1   |
|  |  |                        |          |              |                       |   |

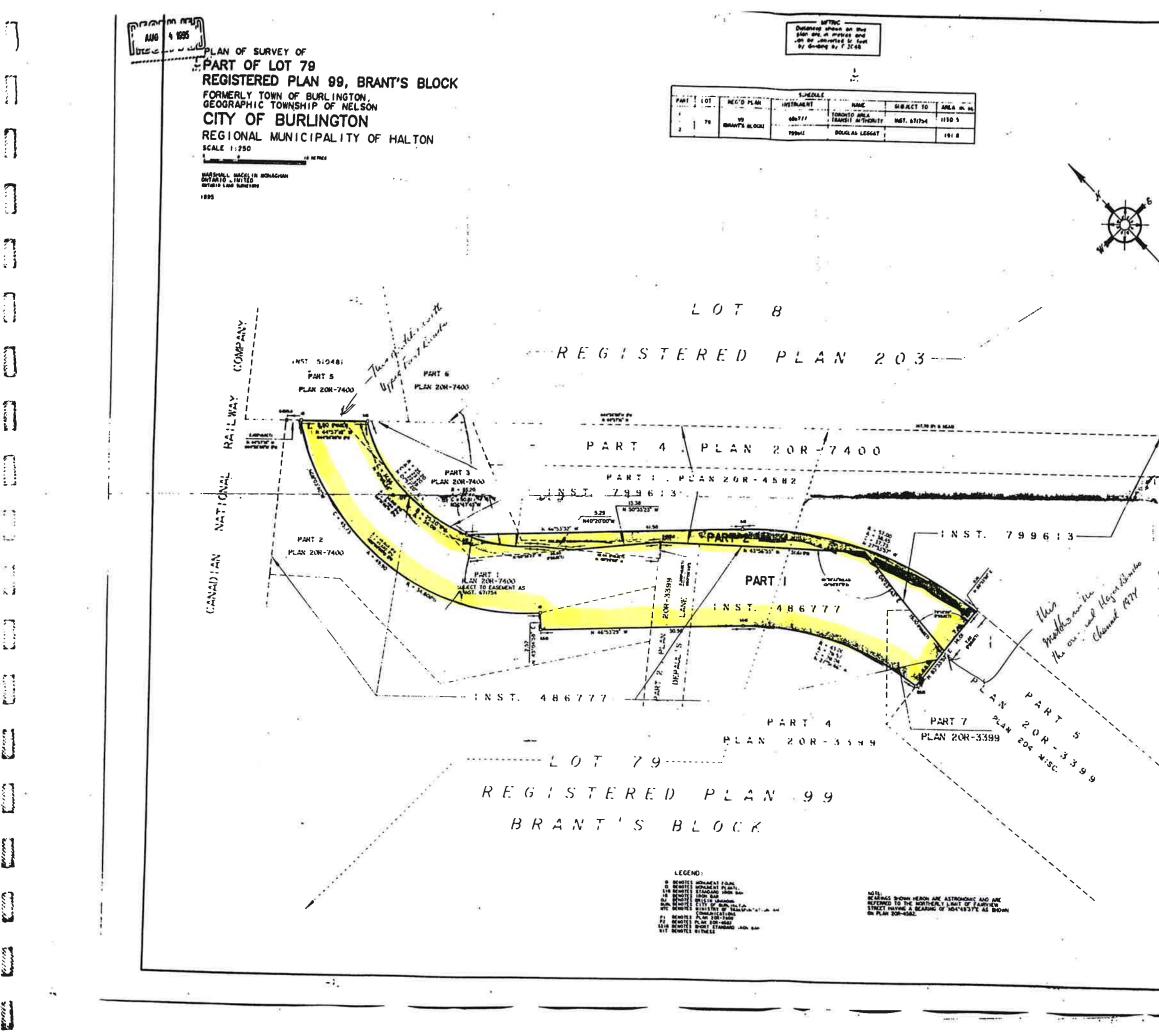

I REGULIRE THIS PLAN TO PLAN 20R-1811 RECEIVED AND DEPOSITED DATE AUGUST 4, 1995 DATE 04 AUG. 1995 Spuis Bert Bruce I. M. MURCHY B. L. I CAUTION THIS PLAN IS NOT A PLAN OF SUBDIVISION WITHIN THE MEANING OF THE PLANNING ACT ΩŤ. 0 0 . 1 STREE FAIRVIEW A Lower East Rambe Channel Port 1.82 owned by Hicert SURVEYOR'S CERTIFICATE I CERTIFY THAT THIS SURVEY AND PLAN ARE CORRECT AND IN ACCOR THE SURVEYS ACT AND THE REGISTRY ACT AND TH REGULATIONS MADE THEREUNDER. THE SURVEY WAS COMPLETED ON 10-5 L.S. MARSHALL MACKLIN ONTARIO LIMITED Onterie Land Surveyers

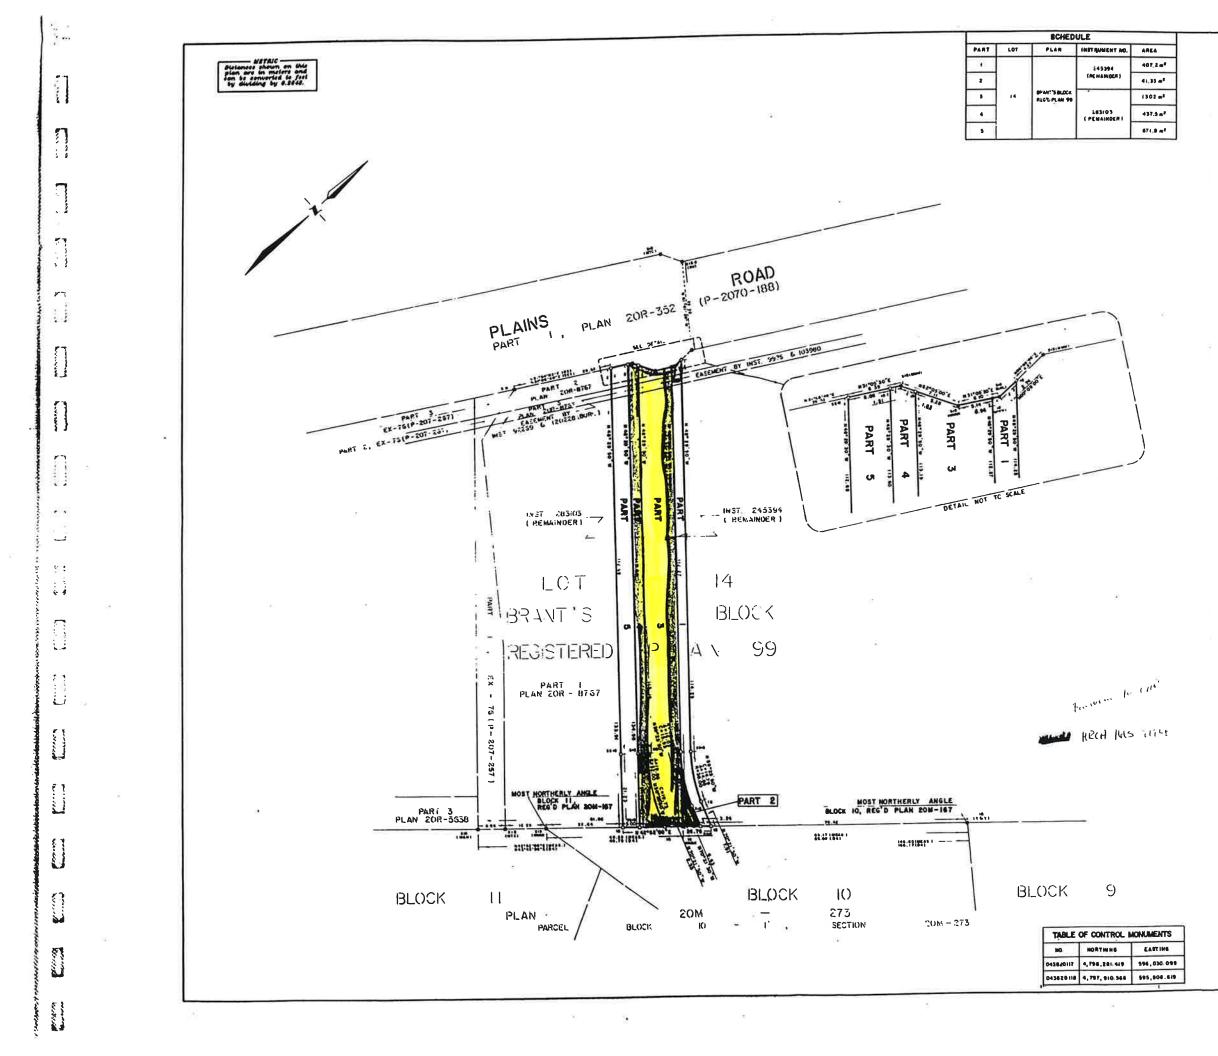

|   | I REQUIRE THIS PLAN TO   | PLAN 20R-9601  |  |  |  |  |  |
|---|--|--|--|--|--|--|--|
|   | BE DEPOSITED UNDER<br>THE REGISTRY ACT.  | RECEIVED AND DEPOSITED   |  |  |  |  |  |
|   | DATE OCT. 23, 1989   | DATE 31 OCT 1989   |  |  |  |  |  |
|   | B - Jaim   | Sheilo Bell  |  |  |  |  |  |
|   | SALCE I. MALACHY O.L.S.  | Tan De actisme bivisian ar mutan   |  |  |  |  |  |
|   |  |  |  |  |  |  |  |
|   | CAU  | TION   |  |  |  |  |  |
|   | THIS PLAN IS NOT A PLA   | IN OF SUBDIVISION WITHIN<br>THE PLANNING ACT   |  |  |  |  |  |
| PLAN OF SURVEY OF<br>PART OF LOT 14<br>BRANT'S BLOCK<br>REGISTERED PLAN 99<br>FORMERLY IN THE VILLAGE OF BURLINGTON<br>COUNTY OF HALTON<br>CITY OF BURLINGTON<br>REGIONAL MUNICIPALITY OF HALTON<br>STALL 1:500<br>MARGINE MARTING<br>MARGINE MARTING<br>MARGINE MARTING<br>MARGINE MARTING<br>1989 |  |  |  |  |  |  |  |
|   |  | 8  |  |  |  |  |  |
|   | NOTE<br>blarmics focum nerelin are grid ant de<br>cartra, monuments orszatilt and grid<br>rear erefereto for feft in ard syste<br>curral meriodian bifod doffwest.   | RIVLO FROM<br>OLE AND<br>M EORE IV.  |  |  |  |  |  |
|   | LEGEND<br>CONTRACTOR POUND<br>CONTRACTOR POUND<br>CONTRACTOR POUND<br>CONTRACTOR POUND<br>CONTRACTOR POUND<br>CONTRACTOR POUND<br>CONTRACTOR POUND<br>CONTRACTOR POUND<br>CONTRACTOR POUND<br>CONTRACTOR<br>CONTRACTOR<br>CONTRACTOR<br>CONTRACTOR<br>CONTRACTOR<br>CONTRACTOR<br>CONTRACTOR<br>CONTRACTOR<br>CONTRACTOR<br>CONTRACTOR<br>CONTRACTOR<br>CONTRACTOR<br>CONTRACTOR<br>CONTRACTOR<br>CONTRACTOR<br>CONTRACTOR<br>CONTRACTOR<br>CONTRACTOR<br>CONTRACTOR<br>CONTRACTOR<br>CONTRACTOR<br>CONTRACTOR<br>CONTRACTOR<br>CONTRACTOR<br>CONTRACTOR<br>CONTRACTOR<br>CONTRACTOR<br>CONTRACTOR<br>CONTRACTOR<br>CONTRACTOR<br>CONTRACTOR<br>CONTRACTOR<br>CONTRACTOR<br>CONTRACTOR<br>CONTRACTOR<br>CONTRACTOR<br>CONTRACTOR<br>CONTRACTOR<br>CONTRACTOR<br>CONTRACTOR<br>CONTRACTOR<br>CONTRACTOR<br>CONTRACTOR<br>CONTRACTOR<br>CONTRACTOR<br>CONTRACTOR<br>CONTRACTOR<br>CONTRACTOR<br>CONTRACTOR<br>CONTRACTOR<br>CONTRACTOR<br>CONTRACTOR<br>CONTRACTOR<br>CONTRACTOR<br>CONTRACTOR<br>CONTRACTOR<br>CONTRACTOR<br>CONTRACTOR<br>CONTRACTOR<br>CONTRACTOR<br>CONTRACTOR<br>CONTRACTOR<br>CONTRACTOR<br>CONTRACTOR<br>CONTRACTOR<br>CONTRACTOR<br>CONTRACTOR<br>CONTRACTOR<br>CONTRACTOR<br>CONTRACTOR<br>CONTRACTOR<br>CONTRACTOR<br>CONTRACTOR<br>CONTRACTOR<br>CONTRACTOR<br>CONTRACTOR<br>CONTRACTOR<br>CONTRACTOR<br>CONTRACTOR<br>CONTRACTOR<br>CONTRACTOR<br>CONTRACTOR<br>CONTRACTOR<br>CONTRACTOR<br>CONTRACTOR<br>CONTRACTOR<br>CONTRACTOR<br>CONTRACTOR<br>CONTRACTOR<br>CONTRACTOR<br>CONTRACTOR<br>CONTRACTOR<br>CONTRACTON<br>CONTRACTOR<br>CONTRACTOR<br>CONTRACTON<br>CONT | NAR<br>PLETAIKA AND LOMM MIGRINAN<br>La 5<br>L. Monagnan, 0 L 5.                         |  |  |  |  |  |
|   | THE SURVEYS ACT AND<br>REGULATIONS MADE THEREUNDER.  | RRECT AND IN ACCORDANCE WITH<br>THE REGISTRY ACT AND THE<br>THE 42% DAY OF OCTONER, 1985 |  |  |  |  |  |
|   | CCT. 23. 1989  | E 1. MilaROW MINIS Lass former   |  |  |  |  |  |
|   | obselled B.M. Plan sills K   | 21-85-585-000-1  |  |  |  |  |  |
|   | ONTARIO LIMITED  | Lond   |  |  |  |  |  |
|   |  |  |  |  |  |  |  |

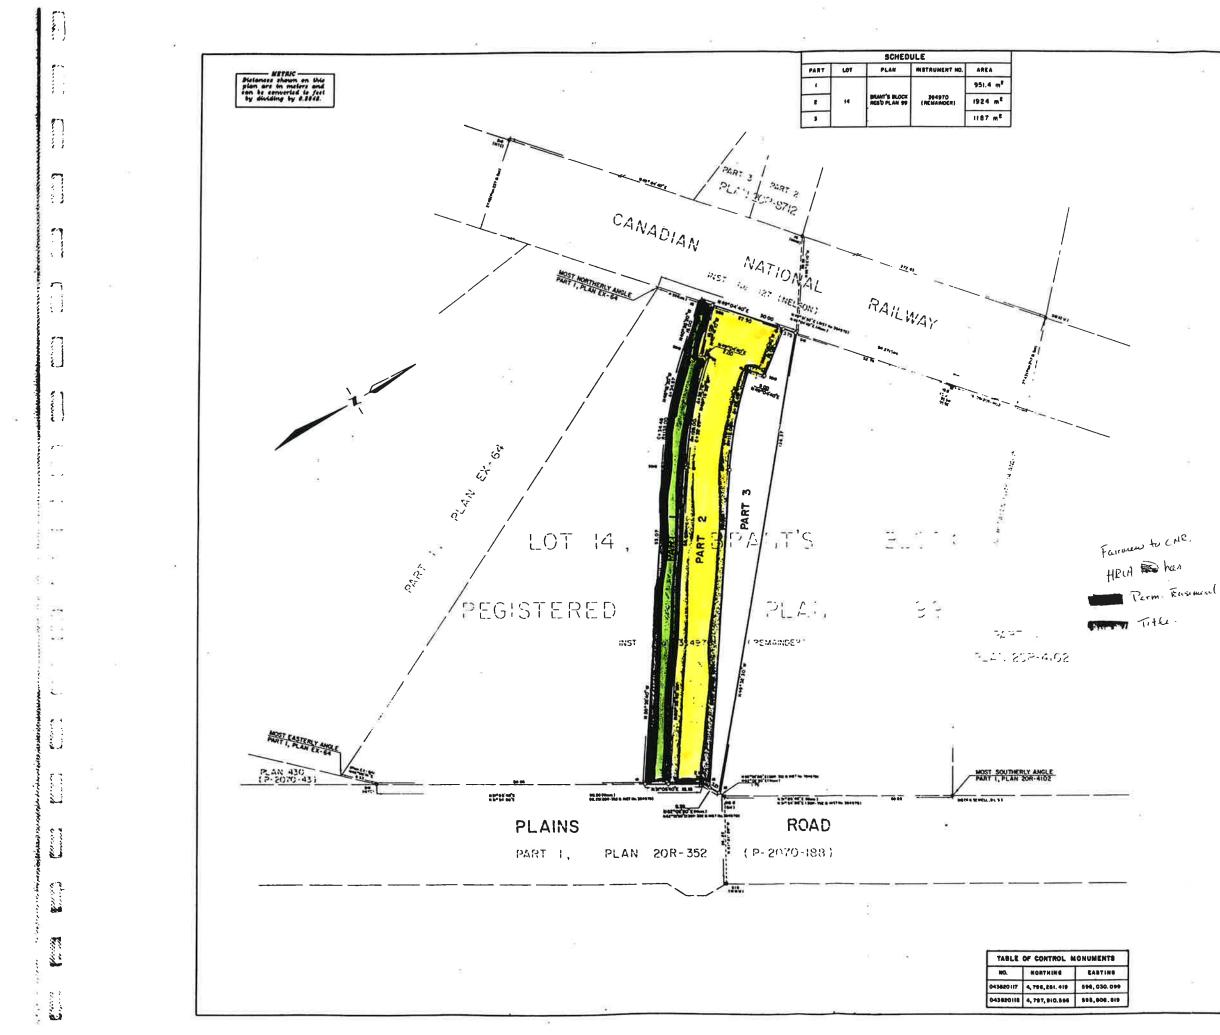

PLAN 20R-9602 I REQUIRE THIS PLAN TO BE DEPOSITED UNDER THE REGISTRY ACT. RECEIVED AND DEPOSITED DATE 31 DCT. 1989 DATE OCT. 23, 1989 Buce 1. Martin C.L.S. CAUTION THIS PLAN IS NOT A PLAN OF SUBDIVISION WITHIN THE MEANING OF THE PLANNING ACT

PLAN OF SURVEY OF PART OF LOT 14 BRANT'S BLOCK REGISTERED PLAN 99 FORMERLY IN THE VILLAGE OF BURLINGTON COUNTY OF HALTON CITY OF BURLINGTON REGIONAL MUNICIPALITY OF HALTON 20

SCALE 1:500

MARSHALL MACKLIN ( ONTARIO LIMITED ONTARIO LAND SURVEYORS

NOTE

BEARINGS SHOWN HEREON ARE OND AND DERIVED FROM CONTROL MONUMENTS O4362017 AND 04362018 AND ARE REFERRED TO THE STUTIN SHO SYSTEM ZONE IF,

#### LEGEND


|       | DENOTES | FOUND   |
|-------|---------|---|
| 0     | DENOTES | PLANTED   |
|       | DENOTES | STANDARD IRON BAR                                 |
| \$5/8 | DENOTES | SHORT STANDARD IRON BAR                           |
| MTC   | DENOTES | MINISTRY OF TRANSPORTATION AND COMMUNICATION      |
|       | DENOTES | ROUND   |
| o.u.  | DENOTES | ORIGHI UNKNOWN                                    |
| 18    | DENCTES | IRON BAR  |
|       | DENOTES | MARSHALL MACHLIN MONAGHAN<br>SHTARO LIMPED, O L 3 |


#### SURVEYOR'S CERTIFICATE


I CERTIFY THAT


- I. THIS SURVEY AND PLAN ARE CORRECT THE SURVEYS ACT AND THE ACCULATIONS MADE THEREUNDER.
- 2. THE SURVEY WAS COMPLETED ON

| OCT. 23, 1989       | Bun            | 97KTA                      |
|---------------------|----------------|----------------------------|
| erann ER Benet CET. | pies size g    | 105 ML.<br>21-09-305-000-2 |
|                     | ALL MACKLIN MO | Lend<br>Surveyers          |

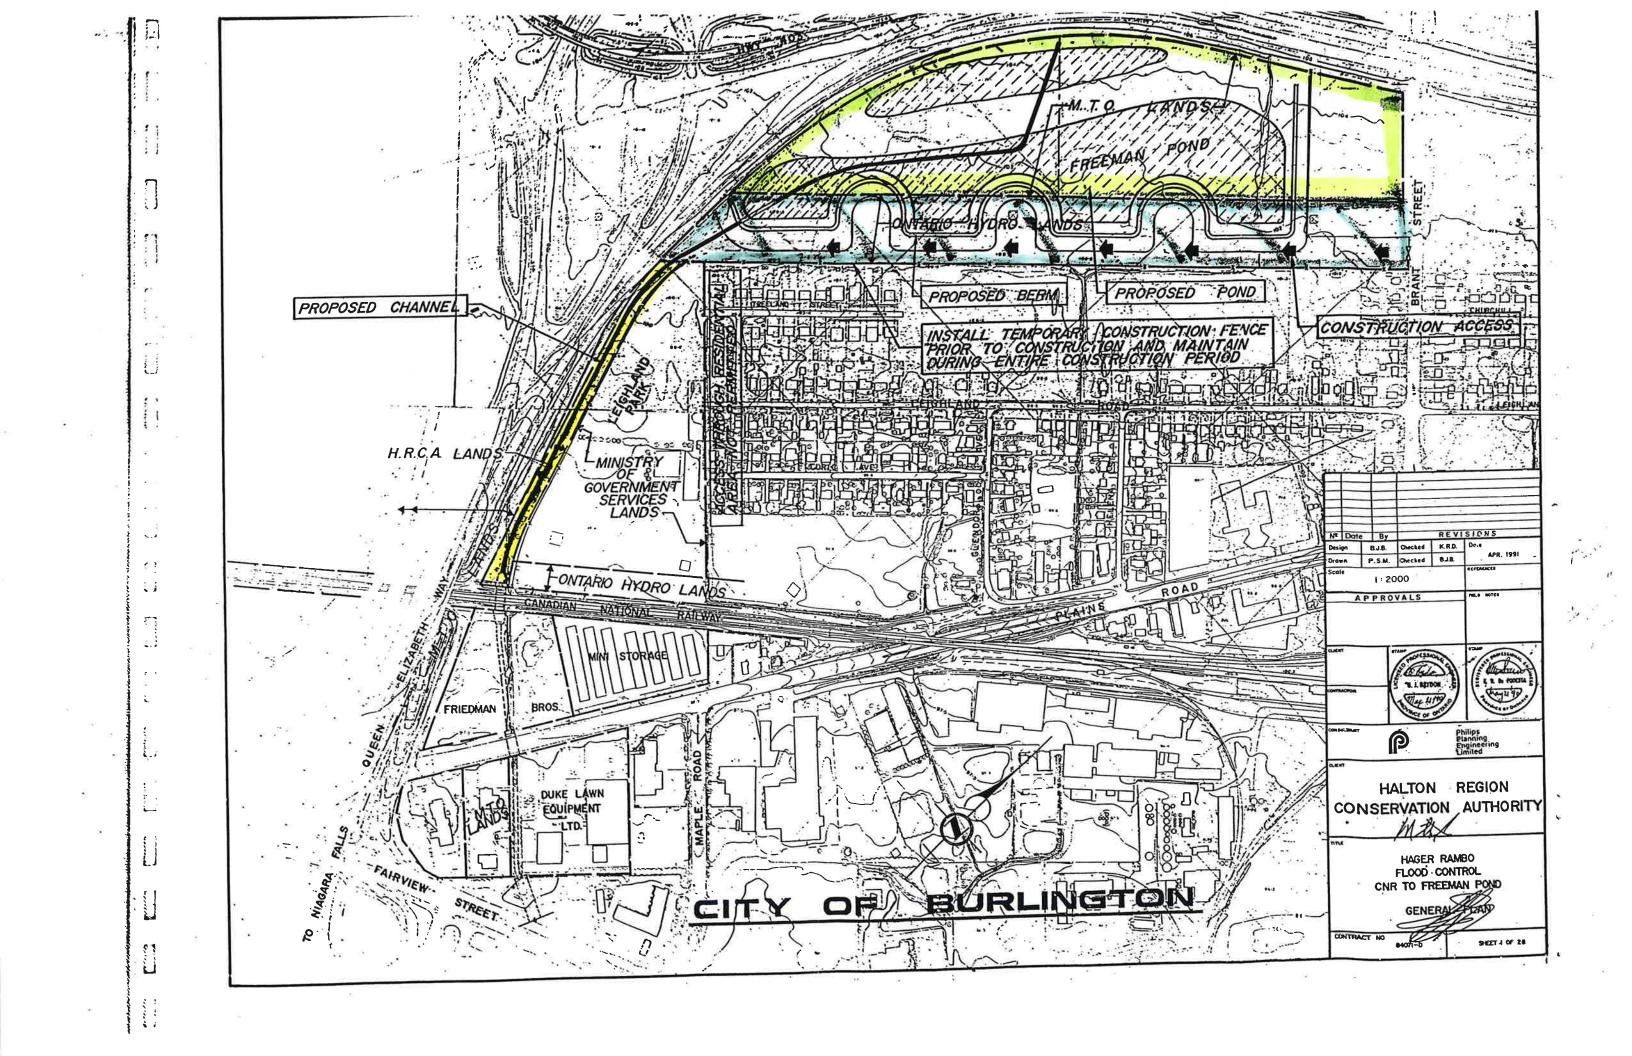

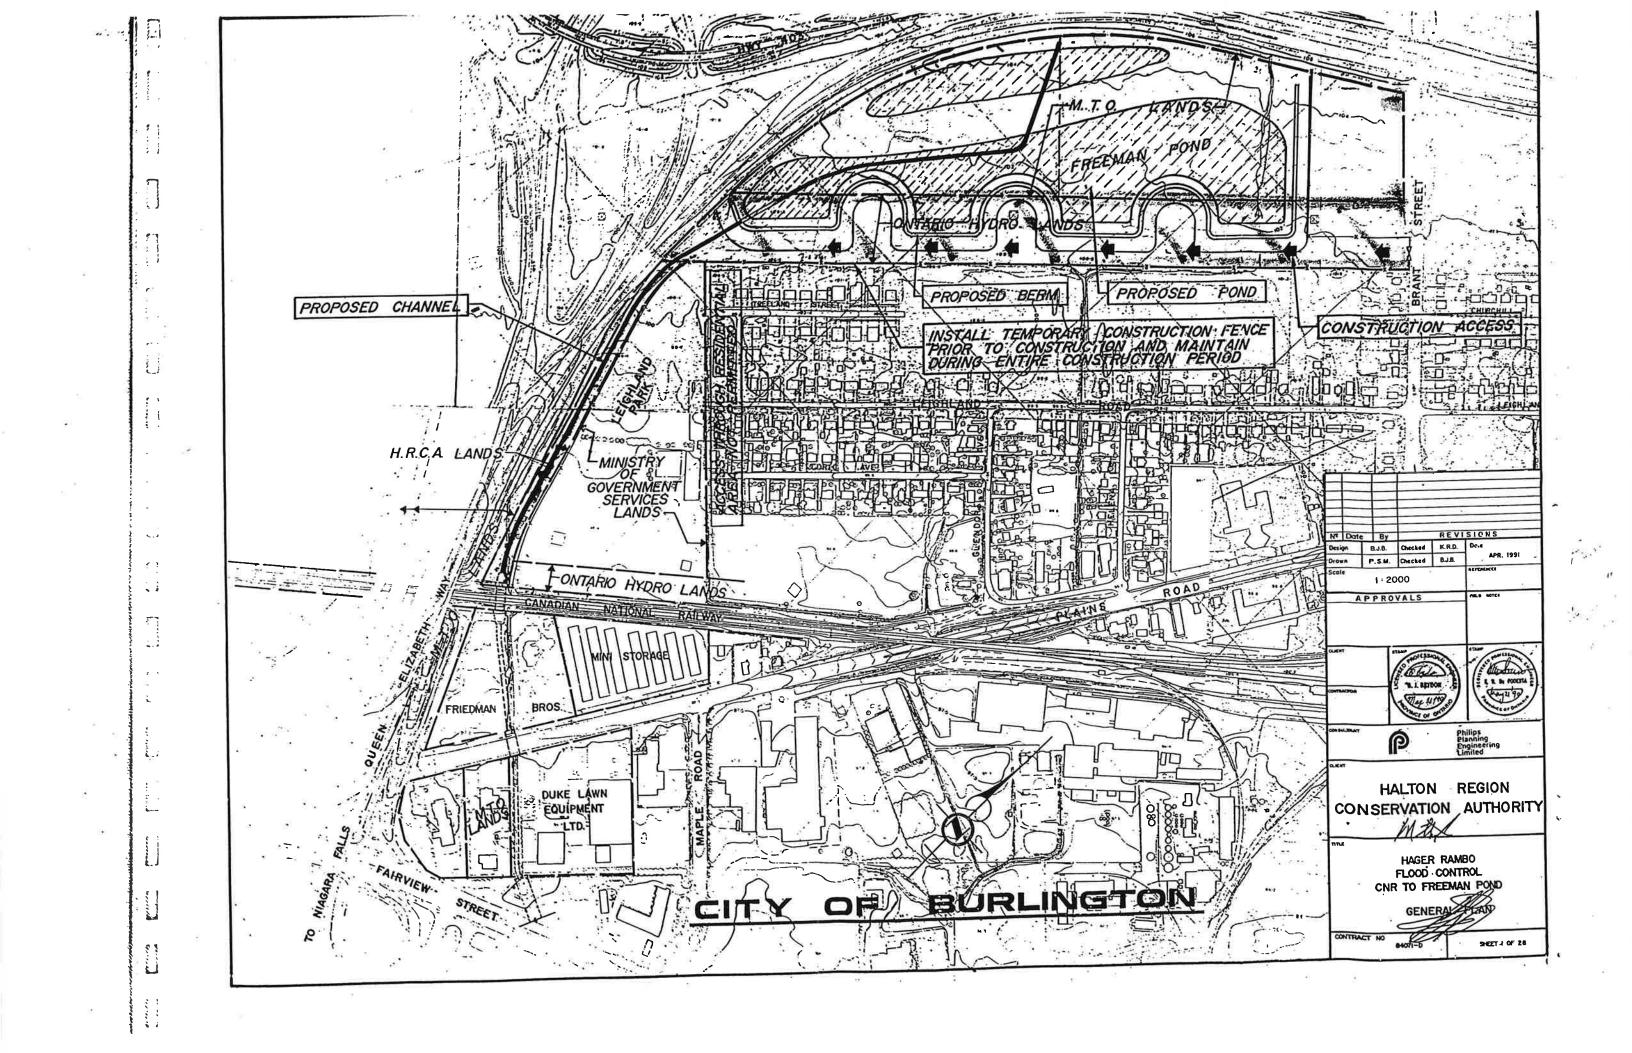

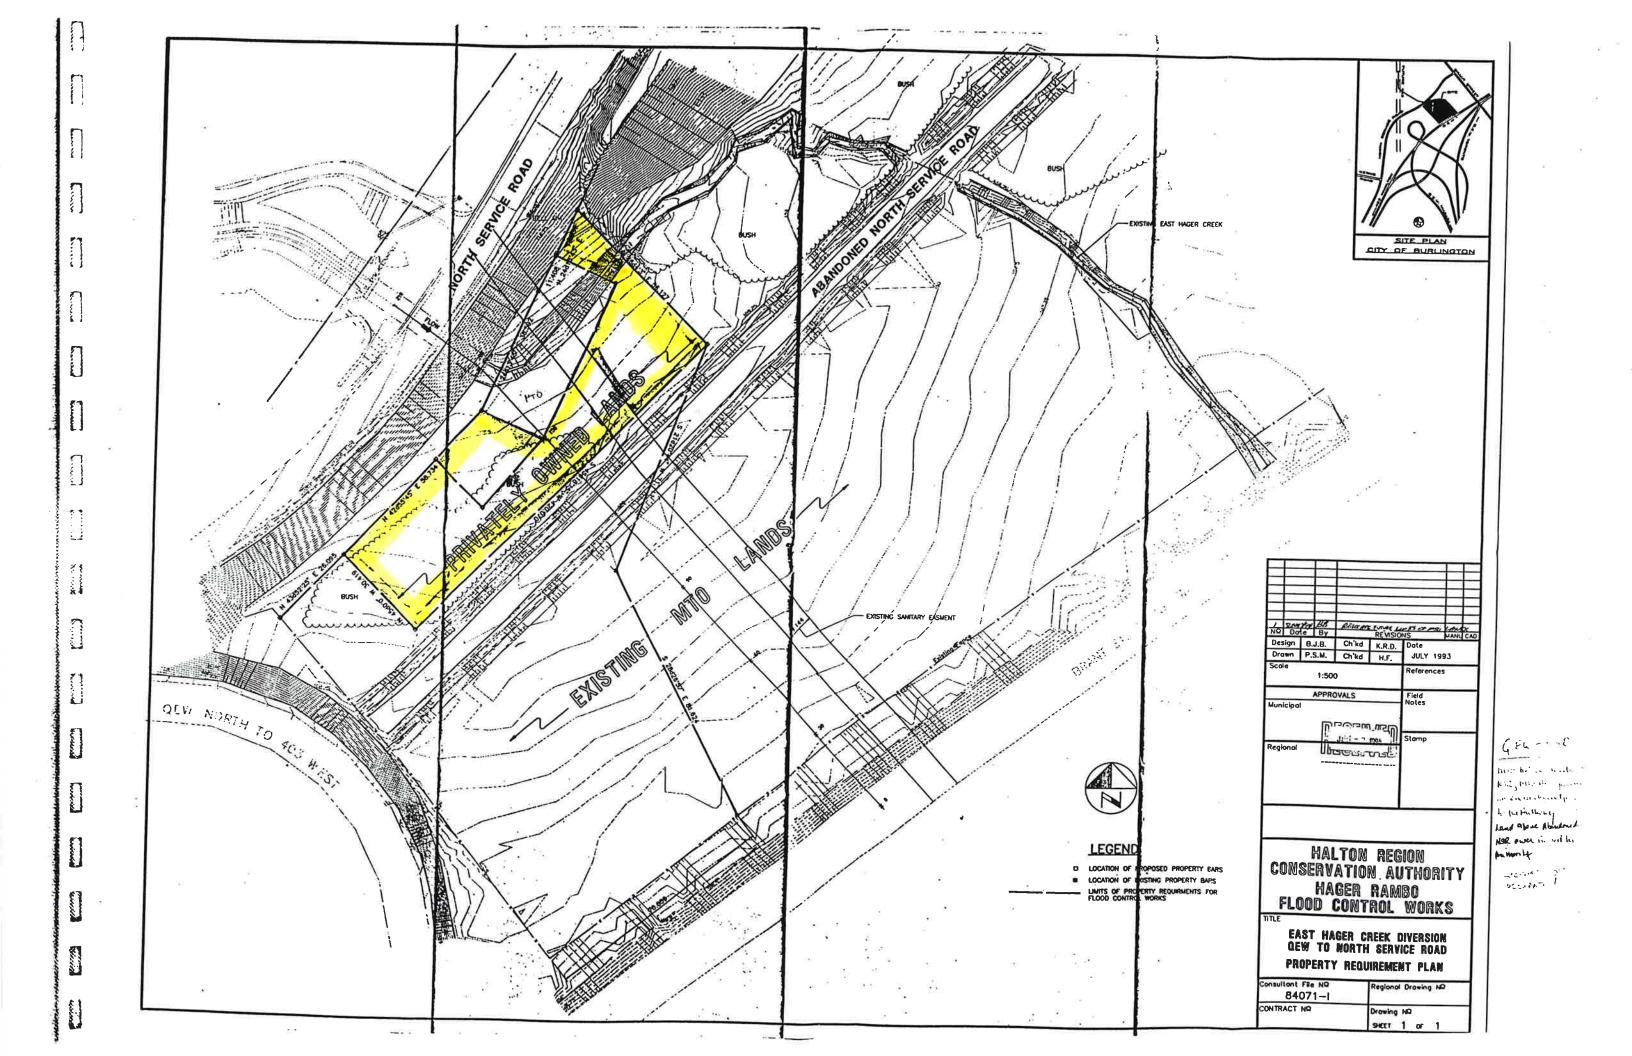

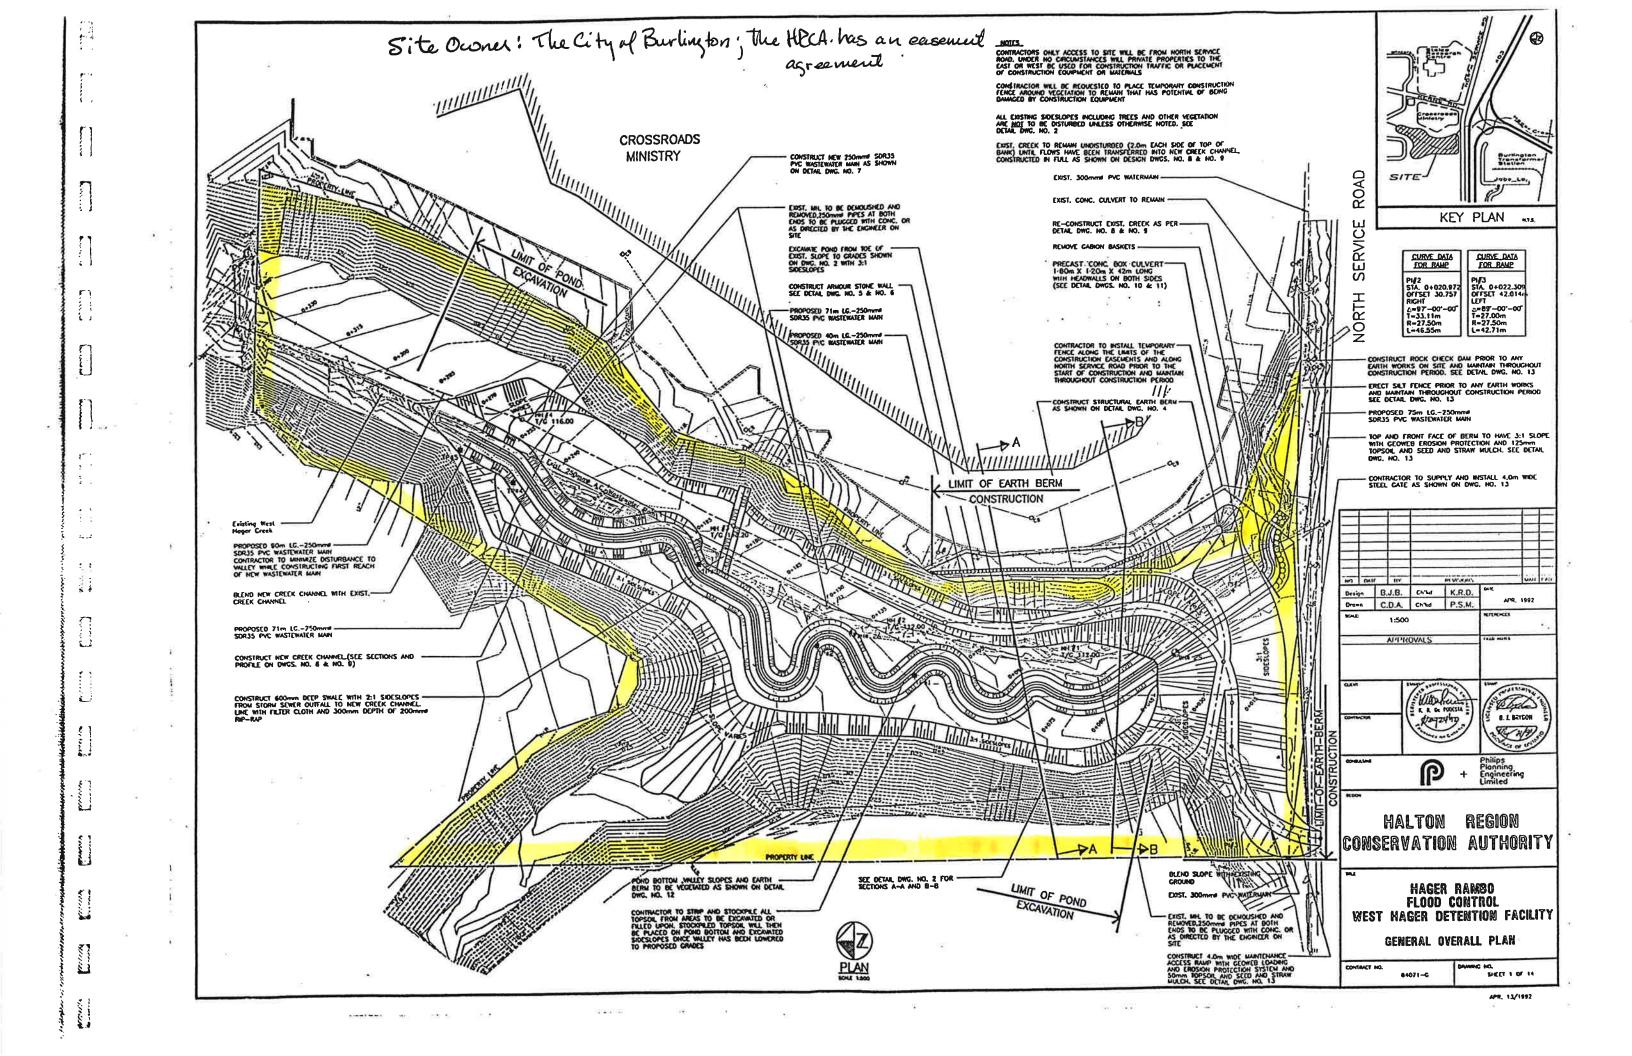

..... 548 NV 8. 51400 0.54 METRIC Distances shown on this plan are in metres and can be converted to feet by dividing by 0.3048. East Hager Channel Reconstruction Owned by HRLA Pts 1-4 with Past 2 builty a water main comment to the region ' -≒®≓-PART 5 91.3 SUBLECT TO EASEMENT AS IN INST. 217147 PART 1 2 PART 2 0 , U 8, P 2H(:F:-PIRT 1 1 PARCEL 7-4 , SECTION H-99 N 75'32'3 9. 1 1 3.1 01.31.10 H 37007394 122 Y PART 10 ير. 8-1 0 . PC <u></u>2-٠ ć Ì 12 ي. م 57 SECTION i Propriet Line 20R-1090  ${\mathbb C}^{n,n}$ PAR. Ċ. 7 PART 5 T ()8 2 ERED 9 AN Ρ T G S ć, ÿ NORTH 60° JT 05' C a strator passe au **i**. J LEGEND: PI DENOTES PLAN 208-7371 MTC DENOTES MINISTRY OF TR AND COMMUNICATION P2 DENOTES PLAN 208-7090 BANCOCOTAT IO

PLAN 20R- 11144 I REQUIRE THIS PLAN TO BE DEPOSITED UNDER RECEIVED AND DEPOSITED THE LAND TITLES ACT. DATE\_\_\_\_\_NAT 5, 1993 DATE OUN. 3 Inilland LAND REGISTRAR FOR THE BRUCE I. MOMURCHY O.L.S. LAND TITLES BIVISION OF HALTON NO. 20 CAUTION THIS PLAN IS NOT A PLAN OF SUBDIVISION WITHIN THE MEANING OF THE PLANNING ACT PARTS I TO & INCLUSIVE PART OF PARCEL 7-4 ,SECTION H-99 PART 2 - SUBJECT TO EASEMENT AS IN INST. 217147 PLAN OF SURVEY OF PART OF LOT 8, BRANT'S BLOCK **REGISTERED PLAN 99** VILLAGE OF BURLINGTON CITY OF BURLINGTON REGIONAL MUNICIPALITY OF HALTON SCALE 1: 750 0 5 0 10 ISMETTES MARSHALL MACKLIN MONAGHAN ONTARIO LAND SURVETORS 1993 REFERRED TO THE WESTERLY LIMIT OF PART IO HAVING A BEARING OF N 12'09'40'W AS SHOWN ON BIAN 2072-7571 SURVEYOR'S CERTIFICATE I CERTIFY THAT I. THIS SURVEY AND PLAN ARE CORRECT AND IN ACCORDANCE WITH THE SURVEYS ACT AND THE LAND TITLES ACT AND THE REGULATIONS MADE THEREUNDER. 2. THE SURVEY WAS COMPLETED ON THE 41% DAY OF malpin MAY 5, 1993 OATE BRUCE I. MCMURCHY Balarta Land Su denns seels 1:750 T.R. jeb ne. 20-93657-01-000 pten stat J checked B.M. MARSHALL MACONDATED ONTARIO LIMITED 4200 SOUTH SCRVICE ROAD, SUITE 101 BAR INCTON, ONT., LTL 433, 639-4644 MARSHALL MACKLIN MONAGHAN Onlario Lond Surveyors

## **APPENDIX 'B'**

# STANDARD INSPECTION FORM

## HAGER-RAMBO SITE INSPECTION FORM

| Name o             | f Inspector:   |  |   |       |
|--------------------|--|--|---|-------|
| Site:              |  | Date:  | (Annu-  | Time: |
|                    | e for Inspection:<br>Complaint<br>Annual<br>Semi-Annual<br>Other | Date o   | of Last Rainfall:<br>Photographs Taken?:                | Y/N   |
| Comme              | ents on:   |  |   |       |
| Ingress/           | /Egress: -<br>-<br>-   | Locks functioning?:<br>Is site accessible?:<br>Any remediation?: | Y/N<br>Y/N  |       |
| Excessi<br>If Yes: |  | on or Vegetation?:<br>be location:                               |   |       |
|                    | Recom  | mended Action:   |   |       |
|                    | If Yes:  |  | ment or Failure Includin<br>g or Cracking? Y/N<br>(mm)? |       |
| Subdrat<br>If Yes: | in Blockage?<br>Where  | Y/N  |   |       |
|                    | Recom  | mendation:   |   |       |
| Fence I<br>If Yes: | Problems:<br>Where   | Y/N  |   |       |
|                    | Recom  | mendation:   |   |       |
| Aesthe<br>If Yes:  | tic Concerns?<br>What?   |  |   |       |
|                    | Where  | ?:   |   |       |
| Other (            | Observations:  |  |   |       |

## Hager-Rambo Flood Control Works

## Operation and Maintenance Deficiency Check List

| Project Element            | Туре                        | Deficiency                | Method to Address       |
|----------------------------|-----------------------------|---------------------------|-------------------------|
| Concrete                   | Channel Invert              | Deterioration             | Sealing                 |
|                            | Culverts                    | Diagonal Cracking         | Grouting                |
|                            | Vertical Drop Structures    | Displacement/Distress     | Replacement             |
|                            | Headwall                    | Heaving                   | Removal of Vegetation   |
|                            | Wingwall                    | Infiltration/Exfiltration |                         |
|                            | Retaining                   | Longitudinal Cracking     |                         |
|                            | Dissipation Blocks          | Offsets                   |                         |
|                            |                             | Seepage                   |                         |
|                            |                             | Surface Defects           |                         |
|                            |                             | Transverse Cracking       |                         |
|                            |                             | Vandalism                 |                         |
|                            |                             | Vegetation Growth         |                         |
| Channel/Erosion Protection | Armour Stone                | Degradation               | Replacement             |
|                            |                             | Displacement              | Removal of Vegetation   |
|                            |                             | Vegetation                |                         |
| 1                          | Rip-Rap                     | Degradation               | Replacement             |
|                            |                             | Displacement              |                         |
|                            |                             | Erosion Beneath           |                         |
|                            |                             | Geotextiles Exposed       |                         |
|                            | Gabions                     | Rock Degradation          | Replacement             |
|                            |                             | Settling Displacement     | Removal of Vegetation   |
|                            |                             | Spaces                    | Repair Basket Wire      |
|                            |                             | Vegetation Growth         |                         |
| 1                          |                             | Wire Degradation          |                         |
|                            | Interlocking Concrete Block | Displacement              | Replacement             |
|                            |                             | Heaving                   |                         |
|                            |                             | Spaces                    |                         |
| Detention Facility         | Berms                       | Slope Failure             | Stope Stabilization     |
|                            | Overlow Valves              | Defective                 | Replacement             |
|                            | Sluice Gates                | Damaged                   | Repair                  |
|                            | Retention Ponds             | Sediment/Siltation        | Dredging                |
| Obstructions               | Channel                     | Aquatic Vegetation        | Removal                 |
|                            | Low Flow Channel            | Dams                      |                         |
|                            | Culverts                    | Debris                    |                         |
|                            | Sub-drains                  | Fallen Rocks              |                         |
|                            | Outlets                     | Sediment/Siltation        |                         |
|                            |                             | Shrubs                    |                         |
|                            |                             | Slope Failure             |                         |
|                            |                             | Tall Weeds                |                         |
|                            |                             | Trees                     |                         |
| Site Access & Protection   | Access Ramps                | Obstructions              | Replacement             |
|                            | Security Fencing            | Damaged                   | Repair                  |
|                            | Pedestrian Handrails        | Defective                 | Removal of Obstructions |
|                            | Gates                       | Visibilty                 |                         |
|                            | Locks                       | - G                       |                         |
|                            | Hinges                      |                           |                         |
|                            | Signs                       |                           |                         |

## **APPENDIX 'C'**

## **1997 FIELD RECONNAISSANCE**

### APPENDIX 'C'

### **1997 FIELD RECONNAISSANCE**

## East Rambo Creek Channelization (Queensway Drive to CNR-Oakville)

On June 20, 1997, the works were inspected by Philips Planning and Engineering Limited personnel. The concrete lined invert is in good shape, with only the expected shrinkage cracks. At one location (station 0+110) a slight (20 mm) settlement has occurred at the shrinkage crack. Gabion baskets are in excellent condition, with no evidence of settlement or potential failure.

The gate at Fassel Drive (east side) is damaged and in need of repair. As well, the Fassel Drive and Queensway Drive maintenance access locations are in need of clean up due to a high amount of vegetative growth, which may inhibit routine or emergency access to the channel invert.

### Lower East Rambo Creek Channelization (CNR-Oakville to Fairview Street

Based on the June 1997 inspection, the concrete works for this project including the channel lining and the Fairview Street culvert appear to be in excellent condition. There are no signs of major cracking of the channel invert; however, vegetation is growing between the channel lining and the base of the armour stone retaining walls in a few locations. The low flow channel has a high amount of algae and sediment within it. The armour stone shows no sign of displacement or deterioration, and the fencing and gated access is in good condition and working order.

### East Hager Creek Channelization (Fairview Street to CNR - Halton)

On August 6, 1997, the works were inspected by Philips Planning and Engineering Personnel. At the time of the site visit, the water level was contained to the low flow channel, with a high level of algae growth and sediment. The channel walls and the Plains Road Culvert were found to be in good condition. However; the channel lining has vegetation growing up through the control and/or expansion joints in a few areas.

### East Hager Creek (CNR Halton Culvert Crossing)

The channel and culvert appear to be in good condition, however; vegetation growth is present in some areas of the control and expansion joints. The protective fencing around the perimeter of the site is in good condition. The walls of the CNR structure both upstream and downstream have been defaced by graffiti.

### East Hager Creek Channelization

During the site visit on August 6, 1997, by Philips Planning and Engineering personnel, it was observed that this section of channel works is in very good condition. The interlocking concrete block lined channel shows no signs of failure in the form of displacement or buckling, and vegetation has grown very well throughout. The channel invert is well vegetated with Purple Loosestrife being the dominant species. Slight sediment build up has occurred in the low flow channel of the concrete sections, and the sub-drains are blocked with vegetation. (Reference Section 6.5)

## Freeman Detention Facility and East Hager Creek Channelization

On August 6, 1997, a site visit was undertaken by Philips Planning and Engineering personnel. The three concrete culverts and the concrete channel transitions appear to be in good condition with no signs of distress or displacement; however, the upstream side of the outlet culvert has been defaced by vandalism. The interlocking concrete block channel is in good condition and heavily vegetated throughout, although Purple Loosestrife is the dominant species and clearly defines the channel as seen in the photographs (reference Section 7.5).

The vegetation throughout the remainder of the site seems to have taken well considering the minimal amount of topsoil. The chainlink security fence enclosing the facility is also in good condition with exception of a 0.4 metre opening at the northeast corner of the park where the chainlink fence ends adjacent to private property.

### East Hager Creek Realignment and Pond System

At the time of the photographic reconnaissance on August 6, 1997, the watercourse was in a low flow state. The amount of vegetation growth immediately around the pond system has developed well, most notably at the first pond (furthest upstream) where a high concentration of cat-tails has evolved. However, the vegetation throughout the remainder of the overbank areas is very sparse.

The drop structures and retaining walls of each of the ponds appear to be in good condition, as well as the dissipation blocks at the base of the third pond (furthest downstream) and the upstream face of the Highway 403 culvert. There is an accumulation of algae on the face of each of the retaining walls, and evidence of vandalism is shown by the graffiti on the inlet structure and the damage to the access gate.

An additional site visit was made in November 1997, by Halton Region Conservation Authority and Philips Planning and Engineering personnel to determine the cause of the low permanent level of the ponds. It has been determined that each of the three sluice gates have been damaged and that slight leaking is occurring. Consultation with the manufacturer (Armtec<sup>TM</sup>) has taken place and minor repairs have been made and water levels are back to where they have been designed. In December 1998, leaking was observed on the west side of the control structure for the downstream facility. As of the time of writing, the source of the leak was not yet identified; resolution of this issue is anticipated in the spring.

## East Hager Creek Reconstruction (North Service Rd. to Future Hwy. 407)

At the time of the site visit on August 6, 1997, by Philips Planning and Engineering staff, the vegetation within the site appears to have grown very well (reference Section 9.5). Purple Loosestrife is the dominant species with the channel, as seen in Photos 1-4. The North Service Road culvert and the culvert and cut-off wall at the upstream limit of the site appear to be in good condition, however the handrails and fencing around the culvert and cut-off wall are damaged and in need of repair. The armour stone is in good condition and shows no sign of degradation or displacement. As seen in Photo 9.6, slight bank erosion is occurring just upstream of the cut-off wall.

## West Hager Detention Facility

On August 6,1997, the works were inspected by Philips Planning and Engineering personnel. The valley has vegetated very well, including the infestation of Purple Loosestrife that follows the channel. The outlet culvert appears to be in good condition; however, vegetation and debris block both the outlet culvert and the existing culvert that conveys flow under the North Service Road.

## **APPENDIX 'D'**

# **1998 AERIAL PHOTOGRAPHS**



Freeman Pond – Inter Ramp Storage Area (looking north, northeast)



Freeman Pond and West Hager Outlet Channel (looking west)



West Hager Pond (looking south)



East Hager Stormwater Energy Dissipation Ponds North Service Road to QEW (looking northwest)



East Rambo Creek Channelization Glenwood School Drive to Queensway (looking east)



East Rambo Creek Channelization CNR to Upstream of Fassel Drive (looking east)



Lower East Rambo Creek Channelization Fairview Street to CNR (looking east)



West Hager Creek Outlet Channel (Concrete Block), CNR Triple Cell Culvert crossing, West Hager Creek Channelization (Concrete) CNR to Fairview Street (looking south)



## Memo

To:Heather Dearlove and Jannette Brenner, Conservation HaltonFrom:Ron Scheckenberger and Matt Senior, WoodDate:August 9, 2019 (Revised December 18, 2019)File:TPB178008cc:Leah Smith, Cary Clark, and Umar Malik, City of BurlingtonRe:Downtown and Burlington GO Mobility Hubs<br/>Flood Hazard and Scoped SWM Assessment<br/>East Rambo Flood Control Facility – Retrofit Feasibility Assessment<br/>City of Burlington

### A. Introduction and Background

Further to Wood's submission of the updated "Flood Hazard and Scoped Stormwater Management Assessment, Burlington GO and Downtown Mobility Hubs" Report (February 25, 2019), and the receipt of comments from Conservation Halton (ref. e-mail Dearlove-Enns, June 27, 2019 and written comments ref. Dearlove-Bustamante, July 25, 2019), as well as the meeting of July 9, 2019, we hereby provide a summary outlining Wood's professional opinion on the potential feasibility of a retrofit of the East Rambo Flood Control Facility, to prevent the spill condition to the West Rambo Creek. The text herein also reflects comments provided by Conservation Halton (CH) in its correspondence of September 25, 2019 (Dearlove-Malik).

As you are aware, the results of the previously noted assessment have indicated that under sufficiently high flows (approximately the 1 in 10-year storm event) the East Rambo Flood Control Facility (FCF) would generate uncontrolled spills via the CNR crossing under the QEW, which would direct flows to the West Rambo Creek system, south of the QEW (rather than the controlled discharge from the East Rambo FCF, which is directed to the East Rambo Creek at Plains Road/Brenda Crescent). This condition results in flows from the East Rambo FCF being split between the East and West Rambo Creek systems, contrary to the previously understood design performance (with all flows being directed to the East Rambo Creek system).

Based on the preceding, CH has previously requested that two (2) modelling scenarios be assessed: with the division of flows as estimated based on actual existing conditions (Scenario 1) and with all flows being directed to East Rambo Creek, as originally intended (Scenario 2). Peak flows for both scenarios were generated and included in the previously noted report, as well as estimated floodplain mapping for both scenarios.

In its comments of July 5, 2019 ref. (e-mail Dearlove-Enns), CH has noted that while Scenario 1 is more representative of existing conditions, it does not represent the worst case scenario for East Rambo Creek and the eventual receiver of East Rambo Creek flows, namely the Hager-Rambo Diversion Channel. Further, CH has suggested that Scenario 1 does not meet Provincial Guidelines, which recommend that reduced flows (i.e. to East Rambo Creek) should only be used after a review of alternatives proves that the spill cannot reasonably be prevented. CH has therefore recommended that Scenario 2 be used to delineate the flood hazard for the East Rambo Creek, as well as the Hager-Rambo Diversion Channel. Under Scenario 2, the generated floodplain mapping (refer to Drawing 5B from the previously noted report) indicates the potential for spill flows from East Rambo Creek in the vicinity of Fairview Street and Argon Court, as well as from the Hager-Rambo Diversion Channel itself, along Fairview Street, between the East and West Rambo Creeks. CH has suggested that these spill flows require additional assessment to better understand the impacts of these flows to the Burlington GO Mobility Hub, as well as the impact of routed flows to the downstream receivers (i.e. Lower Rambo Creek) within the Downtown Mobility Hub.

As discussed at the meeting of July 9, 2019 (and in Comment 11c of its July 25, 2019 comments), CH staff has indicated they may be in a position to support the application of the current condition and more representative flows associated with Scenario 1 (which would then eliminate the need for further hydraulic modelling and floodplain mapping for Scenario 2), if a sufficiently robust alternative/feasibility assessment is undertaken to demonstrate that it is not considered reasonably feasible or likely that the East Rambo FCF could ever be retrofitted or altered to address the previously noted spill. This memorandum is intended to document this assessment.

### B. Potential Retrofitting East Rambo FCF – Review of Considerations

Wood is of the professional opinion that a retrofit of the East Rambo FCF to re-direct flood flows towards the East Rambo Creek is both undesirable (given the potential impacts) and also infeasible (given the technical and financial burdens associated with such works). This would apply both to a complete or partial re-direction of flows, given that similar challenges would occur in both instances. A summary of the rationale for this opinion is outlined herein.

1. Flood Impacts to Residential Properties. As evident from previously prepared floodplain mapping for Scenarios 1 (as per existing conditions) and 2 (all flows from the East Rambo FCF re-directed to East Rambo Creek), Scenario 2 results in a much more extensive floodplain for the East Rambo Creek between the QEW and Fairview Street (ref. Drawings 5A and 5B from the previously noted report). Based on a preliminary estimate, approximately 40 +\- additional detached residential homes between Plains Road and the CNR tracks would be placed within the Regulatory Floodplain under Scenario 2 as compared to Scenario 1, which would notably increase flood risk and damage potential. Further, a large number of additional residential homes would be placed at risk south of Fairview Street due to spill flows from East Rambo Creek and the Hager-Rambo Diversion

Channel under Scenario 2 as compared to Scenario 1. Based on a high-level review with staff from the City of Burlington, it is understood that there are no other critical infrastructure installations that should be considered in either spill area (i.e. electrical substations, telecommunications hub, waste management sites, etcetera). It is further understood that there are no critical vulnerable populations in either area (nursing homes, retirement homes, hospitals, etcetera). Thus, the primary differentiator between the flood risks in the two (2) areas relates to the presence (or absence) of residential units.

Under Scenario 1, spill flows to West Rambo Creek via the CNR would primarily impact industrial/commercial properties only, which would be expected to have a correspondingly lower risk to public life and public property as noted previously. The exception would be high surface flows along Plains Road and the Brant Street underpass, which would be expected to flood due to spill flows and would correspondingly pose a safety risk to drivers.

These flood risks could potentially be practically mitigated through additional measures however, such as increased culvert capacity of West Rambo Creek at Plains Road, grading modifications, and storage. This could also potentially include channel improvements to increase capacity.

With respect to Scenario 1, based on a review of property limits and grading, opportunities are generally considered limited along West Rambo Creek, downstream of Plains Road (subject to acquiring private property) and would also necessitate co-ordination to upgrade three (3) hydraulic structures (two (2) railway lines and one (1) private crossing).

With respect to Scenario 2, channel improvements would be further constrained by the larger number of private properties crossed by East Rambo Creek, and the greater complexities associated with acquiring private residential properties (as opposed to commercial/industrial properties). Although opportunities along both watercourses are considered limited/constrained, improvements to West Rambo Creek would generally be more feasible.

Overall, it is considered that the flood impacts and risks under Scenario 2 are greater than under Scenario 1, given the direct impact to residential properties and residents which involve overnight uses. Channel improvements along East Rambo Creek (which would receive more of the flow under Scenario 2) would also be more complex.

The preceding suggests that a retrofit of the East Rambo FCF to re-direct spill flows to East Rambo Creek (either partially or wholly) would be counter-productive in terms of risk management, and ultimately counter to the overall goals of both the City of Burlington and Conservation Halton.

2. Feasibility of Preventing Spill via CNR Crossing. As noted previously, based on the hydrologic modelling conducted for the Mobility Hub Study, the East Rambo FCF would be expected to spill to the West Rambo Creek system via the CNR crossing at approximately the 1 in 10-year storm event. The spill elevation of the railway tracks in this location has been estimated as 105.5 m, as compared to the base facility elevation of 103.3 m (active depth of 2.2 m at spill point). By contrast, the maximum simulated water level within the facility for the Regional Storm Event (Scenario 1) is estimated as 106.43 m (or some 0.93 m higher), or just above the secondary North Service Road spill elevation of 106.40 m.

Given the grade constraints associated with railway tracks, it is considered unlikely that the railway tracks could be practically raised to address the spill; further this would have impacts on the vertical clearance within the CNR enclosure itself, which would suggest that the structure would need to be altered and replaced to meet CNR clearance requirements. Even a partial adjustment of rail geometry would be complex and costly, and ultimately only partially effective.

A stand-alone automated active flood barrier could potentially be implemented on the CNR QEW crossing (to be enabled once flood levels within the pond reached a certain critical level), however this would require active ongoing monitoring of pond levels and associated automated controls for the barrier. It is unclear who would be responsible for the long-term capital, and operation and maintenance costs for such a system. It is also unclear whether or not both CNR and MTO would agree to the implementation of such a system within their jurisdiction. Such a flood barrier would also likely not be fully watertight, given the nature of railway tracks (i.e. irregular granular bedding and elevated tracks), although it would likely reduce flood spills, if it could be feasibly implemented.

A passive flood barrier (i.e. a berm or wall) could also potentially be considered to prevent spill from entering the CNR QEW crossing. Notwithstanding, the barrier would need to be completed on both sides of the CNR tracks, given the potential for backwater and flooding on the upstream side of the CNR tracks via East Rambo Creek and the associated culvert crossing of the CNR. This would also require re-alignment of East Rambo Creek on the downstream side of the FCF and would also reduce the available flood storage volume within the FCF due to the barrier (notably there would be a reduced impact associated with a wall as compared to a sloped berm however). A barrier on the upstream side of the CNR would be constrained by available space and the numerous landowner interests in this area. Alternatively, a backwater prevention system could potentially be implemented and fitted to the East Rambo Creek culvert, however further detailed hydraulic modelling would need to be completed to confirm to assess effectiveness and feasibility at this scale.

With respect to both active and passive flood barriers to prevent spill via the CNR crossing, the local impacts of implementing such a flood barrier have also not been assessed. Increased operating levels in the FCF have the potential to result in additional flooding of the surrounding area unless additional flow relief was implemented in combination with the flood barrier. In particular, flood encroachment on the properties at 2220, 2250 and 2260 Industrial Street is estimated to occur at an elevation of approximately 106.0 m; this could potentially be worsened by berming off relief flow via the CNR QEW crossing and increasing operating levels within the facility.

Re-grading/expansion of the pond to reduce operating levels is also considered infeasible given surrounding infrastructure (roadways and railways). It is understood that available storage in the facility was maximized at the time of design and also further extended as part of the Area 8 Roseland Creek Diversion, hence potential for additional storage is not considered available. If the North Service Road were theoretically to be shifted closer to the QEW, there would be the potential to increase the facility footprint area, however this would be subject to the acquisition of additional land and agreement with the MTO, both of which may not be forthcoming given active uses in the area. In addition, such an expansion in storage in and of itself would likely not be effective; this storage expansion would likely need to be combined with additional relief flow, necessitating additional infrastructure upgrades (assessed further as part of the subsequent review point).

Based on the preceding, the direct elimination of spill flows through physical works via raising of the CNR tracks, implementation of a flood barrier, or re-grading/expansion of the existing FCF are all considered unlikely or infeasible. Spill flows via the CNR QEW crossing could also potentially be reduced/prevented if additional relief flow could be incorporated to re-direct flows towards East Rambo Creek; this is considered further as part of the subsequent review point.

**3.** *Feasibility of Re-Directing Flows to East Rambo Creek.* As a final consideration, the feasibility of re-directing overflows from the East Rambo FCF to East Rambo Creek has also been reviewed. Based on the currently estimated facility operating curve (stage-storage-discharge), the existing low flow outlet (3.0 m wide x 1.5 m high box culvert) has a limited capacity, which restricts discharge and ultimately results in spill via the first relief point (i.e. the CNR QEW crossing). As such, in order to re-direct flows to the East Rambo Creek, the FCF outlet would either need to be upgraded/upsized, or potentially twinned with a secondary relief crossing of the QEW to the East Rambo Creek. Such an undertaking would be expected to be extremely complex and costly. The crossing would need to cross not only the North Service Road but the QEW, with a combined 12 lanes of active traffic. Construction would therefore need to utilize trenchless methods, such as microtunnelling or jack and bore to avoid disruption to the roadways, and clearly require agreement with the MTO. The cost of the construction (including implementation of large diameter piping)

would be expected to be high. Additional reconstruction on Plains Road and Brenda Crescent/Queensway Drive would also be required to re-direct the additional storm flows to East Rambo Creek.

Further, the estimated Regional Storm inflow to the East Rambo FCF is  $62.0 \text{ m}^3/\text{s}$ . As per the simulated results for Scenario 2, the existing box culvert has been estimated to convey some  $18.5 \text{ m}^3/\text{s}$ , leaving a residual peak flow to be conveyed of some  $43.5 \text{ m}^3/\text{s}$ . Assuming a concrete box culvert structure at a 0.5% grade, and a similar rise to the existing structure (1.5 m), an additional width of some 7.5 m would be required. This large geometry would further increase construction costs, potentially necessitating two (2) separate relief lines.

A less costly alternative could potentially be to re-direct spill flow from the CNR at the downstream side of the QEW, via the existing grassed area in the QEW right-of-way between the CNR and Plains Road/Brenda Crescent. The feasibility of completely blocking and re-directing uncontrolled spill flows at this magnitude is considered low however; the potential for practically constructing a flow bypass in the noted area is unknown without further detailed assessment. Such a system would further require agreement with MTO (and could potentially limit its use of the corridor including any potential future widening), and would also need to assess any potential impacts to the existing industrial properties fronting on Plains Road in this area.

All of the preceding measures also assume no additional flow restrictor controls within the East Rambo FCF. Ultimately, the FCF was originally approved to provide flow controls up to and including the 100-year storm event. Any potential retrofit would need to consider what, if any, potential measures could be incorporated into the design to achieve a greater degree of flow control to ensure compatibility with the originally approved intent and mitigate downstream impacts associated with legacy works. The feasibility of this approach would require further consideration and assessment.

Overall, the re-direction of spill flows from West Rambo Creek to East Rambo Creek would be a highly complex and costly undertaking, and would necessarily involve partnership and agreement with the MTO given the works in proximity to the QEW.


#### C. Summary

Based on the preceding, Wood is of the professional opinion that a retrofit of the East Rambo Flood Control Facility to re-direct predicted spill flows towards East Rambo Creek is neither desirable (given the associated increase in flood damages and risk to residential properties and residents themselves) nor technically feasible (given the technical complexities and associated costs in preventing and re-directing the aforementioned spill flows).

Wood further notes that the City of Burlington is also of the same opinion with respect to the preceding; City staff will provide separate written confirmation of same.

It is recommended that the findings of the preceding be reviewed with CN rail staff, given the potential implications to CN rail infrastructure, and its potential interest in reducing the spill frequency associated with its infrastructure. It is recommended that the City of Burlington share this memorandum and associated reporting information with CN rail staff, and document any associated correspondence accordingly.


We trust the preceding to be satisfactory; please do not hesitate to contact Wood should you wish to discuss the matter further.

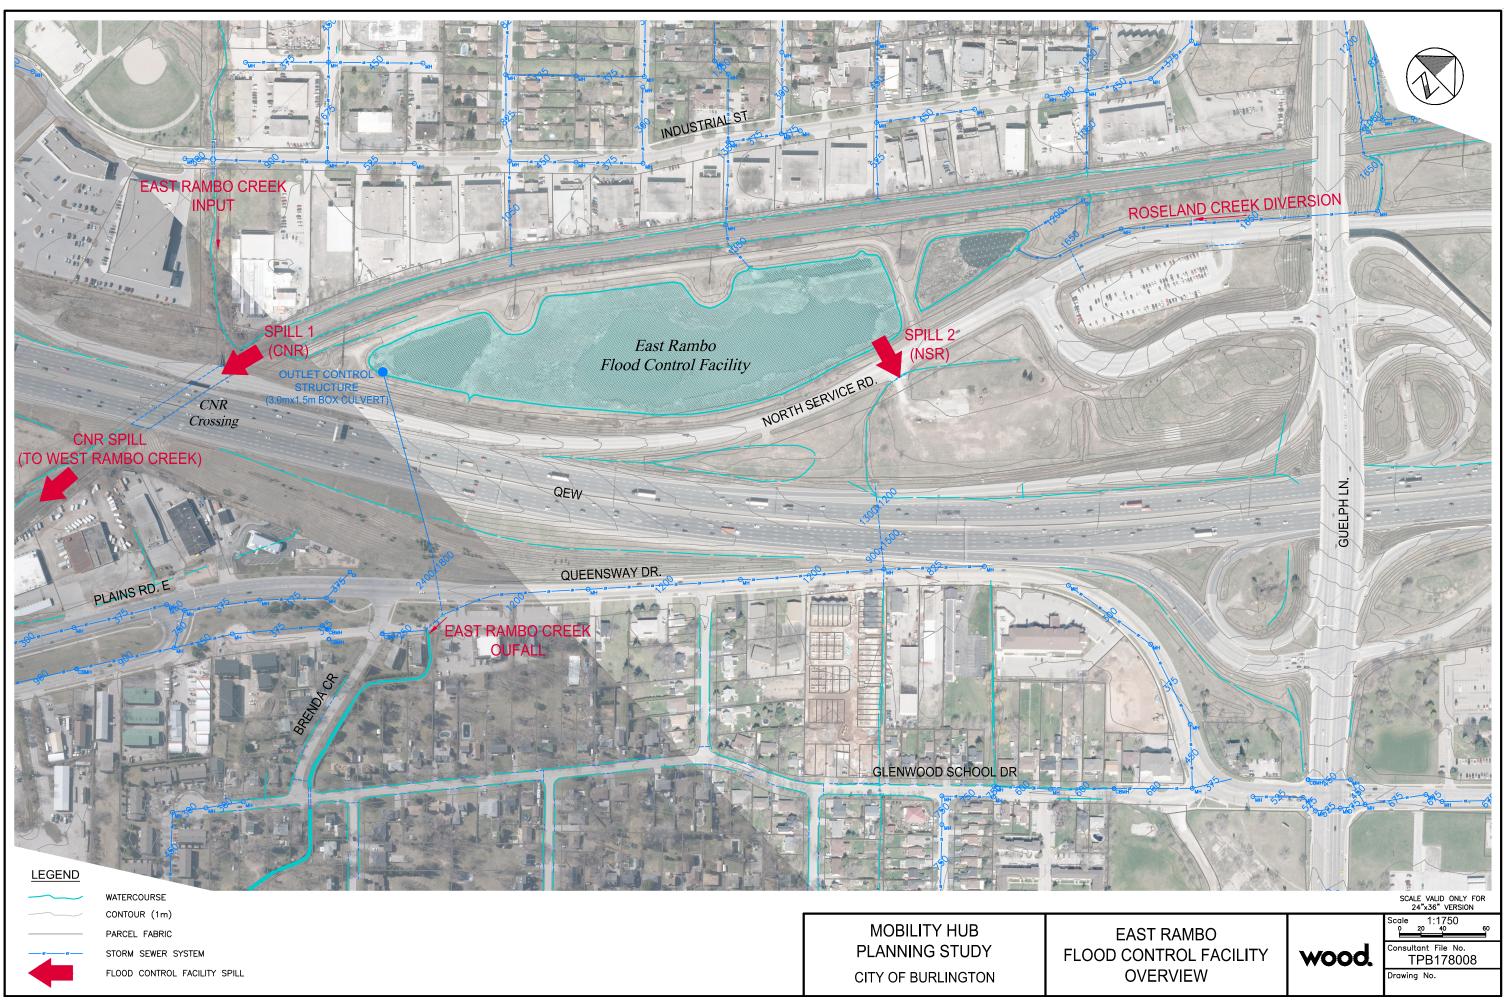




# **Appendix B**

# **Geotechnical Investigation**

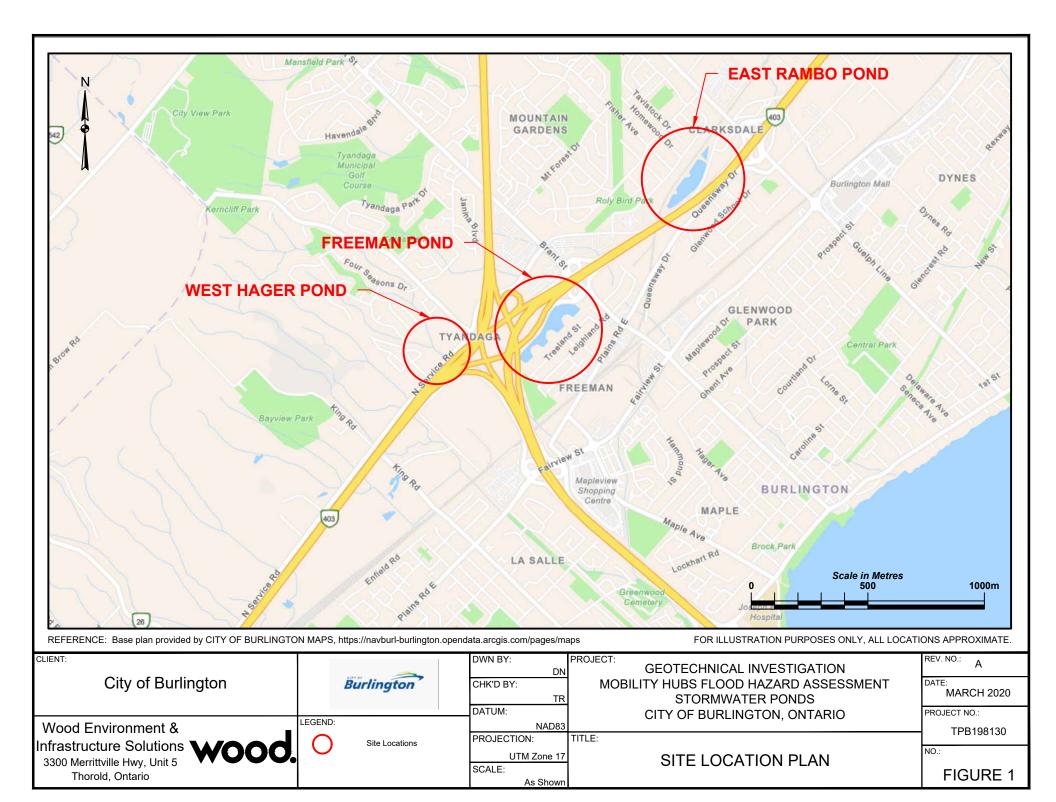

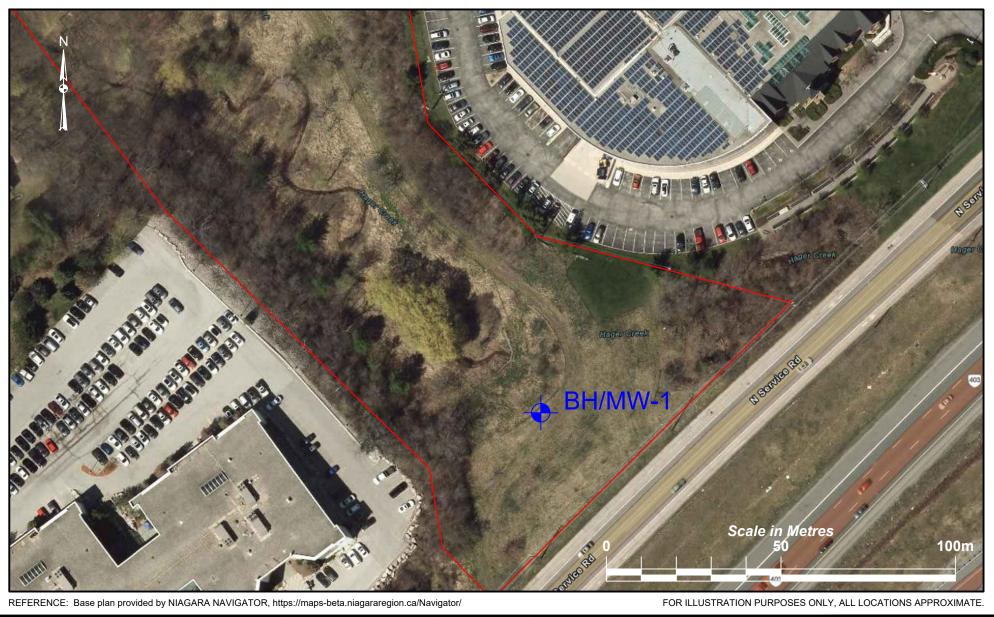

| CLIENT:                       |            |                          | DWN BY:<br>DN | PROJECT:<br>GEOTECHNICAL INVESTIGATION | REV. NO.: A         |
|-------------------------------|------------|--------------------------|---------------|--|---------------------|
| City of Burlington            | Burlington |                          | CHK'D BY:     | MOBILITY HUBS FLOOD HAZARD ASSESSMENT  | DATE:<br>MARCH 2020 |
|                               |            |                          | DATUM:        | STORMWATER PONDS                       |                     |
| Marad Frankraumant 0          | LEGEND:    |                          | NAD83         | CITY OF BURLINGTON, ONTARIO            | PROJECT NO.:        |
| Wood Environment &            | , BH/MW-1  |                          | PROJECTION:   | TITLE: BOREHOLE and MONITORING WELL    | TPB198130           |
| Infrastructure Solutions WOOO | •          | Monitoring Well Location | UTM Zone 17   |  | NO.:                |
| Thorold, Ontario              |            | Site Boundary            | SCALE:        |  | FIGURE 2A           |



REFERENCE: Base plan provided by NIAGARA NAVIGATOR, https://maps-beta.niagararegion.ca/Navigator/

FOR ILLUSTRATION PURPOSES ONLY, ALL LOCATIONS APPROXIMATE.

| CLIENT:                       |                           | DWN BY:     | PROJECT:                                   | REV. NO.:     |
|-------------------------------|---------------------------|-------------|--|---------------|
|                               |                           | DN          |  | A             |
| City of Burlington            | Burlington                | CHK'D BY:   | MOBILITY HUBS FLOOD HAZARD ASSESSMENT      | DATE:         |
|                               | 2                         | TR          | STORMWATER PONDS                           | MARCH 2020    |
|                               |                           | DATUM:      | CITY OF BURLINGTON, ONTARIO                | PROJECT NO .: |
| Wood Environment &            | LEGEND:                   | NAD83       |  | TPB198130     |
|                               | BH-4<br>Borehole Location | PROJECTION: | <b>TITLE: BOREHOLE and MONITORING WELL</b> | IFD190130     |
| Infrastructure Solutions WOOO | BH/MW-2                   | UTM Zone 17 | LOCATION PLAN                              | NO.:          |
|                               |                           | SCALE:      |  |               |
| Thorold, Ontario              | Site Boundary             | As Shown    | FREEMAN POND                               | FIGURE 2B     |



REFERENCE: Base plan provided by NIAGARA NAVIGATOR, https://maps-beta.niagararegion.ca/Navigator/

FOR ILLUSTRATION PURPOSES ONLY, ALL LOCATIONS APPROXIMATE.

| CLIENT:   |                                | DWN BY:               | PROJECT:  | REV. NO.: A         |
|---|--------------------------------|-----------------------|---|---------------------|
| City of Burlington  | Burlington                     | DN<br>CHK'D BY:<br>TR | GEOTECHNICAL INVESTIGATION<br>MOBILITY HUBS FLOOD HAZARD ASSESSMENT<br>STORMWATER PONDS | DATE:<br>MARCH 2020 |
|   |                                | DATUM:                | CITY OF BURLINGTON, ONTARIO   | PROJECT NO .:       |
| Wood Environment &  | LEGEND:<br>BH-5                | NAD83                 |   | TPB198130           |
| Infrastructure Solutions <b>MAGA</b>                      |                                | PROJECTION:           | <b>TITLE: BOREHOLE and MONITORING WELL</b>  |                     |
| Infrastructure Solutions<br>3300 Merrittville Hwy, Unit 5 | BH/MW-6<br>Monitoring Well Loo |                       | LOCATION PLAN   | NO.:                |
| Thorold, Ontario  | Site Boundary                  | SCALE:<br>As Shown    | EAST RAMBO POND   | FIGURE 2C           |

## **EXPLANATION OF BOREHOLE LOG**

This form describes some of the information provided on the borehole logs, which is based primarily on examination of the recovered samples, and the results of the field and laboratory tests. Additional description of the soil/rock encountered is given in the accompanying geotechnical report.

#### **GENERAL INFORMATION**

Project details, borehole number, location coordinates and type of drilling equipment used are given at the top of the borehole log.

#### SOIL LITHOLOGY

#### Elevation and Depth

This column gives the elevation and depth of inferred geologic layers. The elevation is referred to the datum shown in the Description column.

#### **Lithology Plot**

This column presents a graphic depiction of the soil and rock stratigraphy encountered within the borehole.

#### Description

This column gives a description of the soil stratums, based on visual and tactile examination of the samples augmented with field and laboratory test results. Each stratum is described according to the *Modified Unified Soil Classification System* (modified slightly so that an inorganic clay of "medium plasticity" is recognized).

The compactness condition of cohesionless soils based on standard penetration testing (SPT) and the consistency of cohesive soils (undrained shear strength) are defined as follows (*Ref. Canadian Foundation Engineering Manual*, 4<sup>th</sup> Edition, 2006):

| Compactness of Cohesionless Soils | SPT<br>N-Value |  |  |
|-----------------------------------|----------------|--|--|
| Very Loose                        | 0 to 4         |  |  |
| Loose                             | 4 to 10        |  |  |
| Compact                           | 10 to 30       |  |  |
| Dense                             | 30 to 50       |  |  |
| Very Dense                        | > 50           |  |  |

| Consistency of Cohesive Soils | Unconfined Compressive Strength |              |  |  |
|-------------------------------|---------------------------------|--------------|--|--|
| Consistency of Conesive Sons  | kPa                             | psf          |  |  |
| Very Soft                     | 0 to 12                         | 0 to 250     |  |  |
| Soft                          | 12 to 25                        | 250 to 500   |  |  |
| Firm                          | 25 to 50                        | 500 to 1000  |  |  |
| Stiff                         | 50 to 100                       | 1000 to 2000 |  |  |
| Very Stiff                    | 100 to 200                      | 2000 to 4000 |  |  |
| Hard                          | > 200                           | > 4000       |  |  |

#### SOIL SAMPLING

Sample types are abbreviated as follows:

| SS | Split Spoon  | TW | Thin Walled Open (Pushed)   | RC | Rock Core     | GS | Grab Sample       |
|----|--------------|----|-----------------------------|----|---------------|----|-------------------|
| AS | Auger Sample | TP | Thin Walled Piston (Pushed) | WS | Washed Sample | AR | Air Return Sample |

Additional information provided in this section includes sample numbering, sample recovery (%) and numerical testing results (SPT).

#### FIELD AND LABORATORY SAMPLING

Results of field testing (e.g., SPT, pocket penetrometer, and vane testing) and laboratory testing (e.g., natural moisture content, and limits) executed on the recovered samples are plotted in this section.

#### **Definitions of Penetration Resistance**

Standard penetration resistance 'N' – The number of blows required to advance a standard split spoon sampler 30 cm into the subsoil, driven by means of a 63.5 kg hammer falling freely a distance of 76 cm.

Dynamic penetration resistance – The number of blows required to advance a 50 mm, 60 degree cone, fitted to the end of drill rods, 30 cm into the subsoil, the driving energy being 474.5 Joules per blow.

#### INSTRUMENTATION INSTALLATION

Instrumentation installations (monitoring wells, piezometers, inclinometers, etc.) are plotted in this section.

#### WATER LEVEL

Water levels, if measured during fieldwork, are plotted in the depth/elevation column. These water levels may or may not be representative of the static groundwater level depending on the nature of soil stratum where the piezometer tips are located, the time elapsed from installation to reading and other applicable factors. Other information includes the depth of borehole cave-in, if any. This information is also included in the borehole log footer.

#### COMMENTS

www.woodplc.com

This column is used to describe non-standard situations or notes of interest.

#### Wood Environment & Infrastructure Solutions

a Division of Wood Canada Limited Geotechnical Discipline - Ontario Region



## **EXPLANATION OF BOREHOLE LOG**

**GENERAL REPORT NOTE** The soil conditions, profiles, comments, conclusions and recommendations found in this report are based upon the samples recovered during the fieldwork. Soils are heterogeneous materials and, consequently, variations (possibly extreme) may be encountered at site locations away from boreholes. During construction, competent, qualified inspection personnel should verify that no significant variations exist from the conditions described in this report.

v Date: January 7, 2019

| MAJOR DIVISION GROUP  |  |   |                                     | . TYPICAL DESCRIPTION   |                                       |   |   | LABORATORY CLASSIFICATION CRITERIA |   |  |               |    |  |
|---|--|---|-------------------------------------|---|---------------------------------------|---|---|------------------------------------|---|--|---------------|----|--|
|   | Smm  | CLEAN GRAVELS                                 | GW                                  | WELL GRADED GRAVELS, GRAVEL-SAND MIXTURES, LITTLE OR NO FINES                     |                                       |   |   |                                    | $C_u = \underline{D}_{60} > 4;$ $C_c = \underline{(D_{30})^2} = 1 \text{ to } 3$                  |  |               |    |  |
| COARSE GRAINED SOILS<br>(MORE THAN HALF BY WEIGHT LARGER THAN 75µm) | GRAVELS<br>GRAVELS<br>MORE THAN HALF THE COARSE<br>FRACTION LARGER THAN 4.75mm | (TRACE OR NO<br>FINES)                        | GP                                  | POORLY GRADED GRAVELS, GRAVEL-SAND  |                                       |   |   |                                    | D <sub>10</sub> D <sub>10</sub> X D <sub>60</sub><br>NOT MEETING ABOVE REQUIREMENTS               |  |               |    |  |
|   |  | DIRTY GRAVELS<br>(WITH SOME OR<br>MORE FINES) | GM                                  | MIXTURES, LITTLE OR NO FINES<br>SILTY GRAVELS, GRAVEL-SAND-SILT MIXTURES          |                                       |   |   |                                    | ATTERBERG LIMITS BELOW "A" LINE OR I <sub>2</sub> LESS THAN 4                                     |  |               |    |  |
|   |  |   | GC                                  | CLAYEY GRAVELS, GRAVEL-SAND-CLAY MIXTURES   |                                       |   |   |                                    | ATTERBERG LIMITS ABOVE "A" LINE OR I <sub>P</sub> MORE THAN 7                                     |  |               |    |  |
|   |  |   |                                     | WELL GRADED SANDS, GRAVELLY SANDS, LITTLE OR NO FINES                             |                                       |   |   |                                    | $C_u = \underline{D}_{60} > 6;$ $C_c = \underline{(D_{30})^2} = 1 \text{ to } 3$                  |  |               |    |  |
|   | SANDS<br>SANDS<br>MORE THAN HALF THE COARSE<br>FRACTION SMALLER THAN 4.75mm    | CLEAN SANDS<br>(TRACE OR NO<br>FINES)         | SW                                  |   |                                       |   |   |                                    |   |  |               |    |  |
|   |  |   | SP                                  | POORLY GRADED GRAVELS, GRAVEL-SAND MIXTURES, LITTLE OR NO FINES                   |                                       |   |   |                                    | NOT MEETING ABOVE REQUIREMENTS  |  |               |    |  |
|   |  | DIRTY SANDS<br>(WITH SOME OR<br>MORE FINES)   | SM                                  | SILTY SANDS, SAND-SILT MIXTURES   |                                       |   |   |                                    | ATTERBERG LIMITS BELOW "A" LINE OR IP LESS THAN 4   |  |               |    |  |
|   |  | MORE FINES)                                   | SC                                  | CLAYEY SANDS, SAND-CLAY MIXTURES  |                                       |   |   |                                    | ATTERBERG LIMITS ABOVE "A" LINE OR IP MORE THAN 7   |  |               |    |  |
| FINE-GRAINED SOILS<br>(MORE THAN HALF BY WEIGHT SMALLER THAN 75µm)  | SILTS<br>SILTS<br>BELOW "A" LINE<br>NEGLIGIBLE ORGANIC<br>CONTENT              | W <sub>L</sub> < 50%                          | ML                                  | INORGANIC SILTS AND VERY FINE SANDS, ROCK FLOUR, SILTY SANDS OF SLIGHT PLASTICITY |                                       |   |   |                                    |   |  |               |    |  |
|   | BELC   | W <sub>L</sub> > 50%                          | МН                                  | INORGANIC SILTS, MICACEOUS OR DIATOMACEOUS, FINE SANDY OR SILTY SOILS             |                                       |   |   |                                    | CLASSIFICATION IS BASED UPON PLASTICITY CHART<br>(SEE BELOW)                                      |  |               |    |  |
|   | CLAYS<br>ABOVE "A" LINE<br>NEGLIGIBLE ORGANIC<br>CONTENT                       | W <sub>L</sub> < 30%                          | CL                                  | INORGANIC CLAYS OF LOW PLASTICITY, GRAVELLY, SANDY OR SILTY CLAYS, LEAN CLAYS     |                                       |   |   |                                    |   |  |               |    |  |
|   |  | 30% < W <sub>L</sub> < 50%                    | CI                                  | INORGANIC CLAYS OF MEDIUM PLASTICITY, SILTY CLAYS                                 |                                       |   |   |                                    | 1   |  |               |    |  |
|   |  | W <sub>L</sub> > 50%                          | СН                                  | INORGANIC CLAYS OF HIGH PLASTICITY, FAT CLAYS                                     |                                       |   |   |                                    |   |  |               |    |  |
|   | IIC<br>LAYS  | W <sub>L</sub> < 50%                          | OL                                  | ORGANIC SILTS AND ORGANIC SILTY CLAYS OF LOW PLASTICITY                           |                                       |   |   |                                    | WHENEVER THE NATURE OF THE FINES CONTENT HAS NOT  |  |               |    |  |
|   | ORGANIC<br>SLITS & CLAVS<br>BELOW "A" LINE                                     | W <sub>L</sub> > 50%                          | ОН                                  | ORGANIC CLAYS OF HIGH PLASTICITY  |                                       |   |   |                                    | DETERMINED, IT IS DESIGNATED BY THE LETTER "F",<br>e.g. SF IS A MIXTURE OF SAND WITH SILT OR CLAY |  |               |    |  |
|   | HIGH ORGANIC SOILS   |   | PEAT AND OTHER HIGHLY ORGANIC SOILS |   |                                       |   | STRONG COLOUR OR ODOUR, AND OFTEN FIBROUS TEXTL |                                    |   |  |               |    |  |
|   |  | SOIL COM                                      | PONENTS                             | -   |                                       |   | Plastic   | city Chart for                     | Soil Passing  | 425 µm Sie                                   | ve            |    |  |
| FRACTION  | U.S ST   | ANDARD SIEVE SIZ                              | ZE                                  | DEFINING RANGES OF PERCENTAGE<br>BY WEIGHT<br>OF MINOR COMPONENTS                 |                                       |   | 60  |                                    |   | JI B   |               |    |  |
|   |  | PASSING                                       | RETAINED                            | PERCENT   | DESCRIPTOR                            | 50  |   |                                    | <i>"</i>  | <u>,</u> ,,,,,,,,,,,,,,,,,,,,,,,,,,,,,,,,,,, |               | 2  |  |
| GRAVEL  | COARSE   | 75 mm   | 19 mm                               | 35 - 50   | AND                                   | G <sup>40</sup>                           |   |                                    |   | / СН   | 10.73 cm      | 20 |  |
|   | FINE   | 19 mm   | 4.75 mm                             | 20 - 35   | Y/EY                                  | (%) <b>4</b> 1 ')                         |   | v                                  | / <sub>L</sub> = 50   |  | 10.1×         |    |  |
| SAND  | COARSE   | 4.75 mm                                       | 2.00 mm                             | 10 - 20   | SOME                                  | <b>A Inde</b> 30                          |   |                                    |   |  |               |    |  |
|   | MEDIUM   | 2.00 mm                                       | 425 μm                              | 1 - 10  | TRACE                                 | <sup>00</sup> <sup>00</sup> <sup>00</sup> | w   | = 30                               | α   | мна  | r OH          |    |  |
|   | FINE   | 425 µm  | 75 µm                               |   |                                       |   |   |                                    |   |  |               |    |  |
| NES (SILT AND CLAY BASED ON PLASTICITY) 75 µm                       |  |   |                                     |   |                                       | 10  |   |                                    |   |  |               | +  |  |
|   |  | OVERSIZED                                     | MATERIAL                            |   |                                       |   | CL-M  | <u>IL</u><br>,´ML                  | or OI   |  |               |    |  |
|   |  |   |                                     |   | 0 0 0 0 0 0 0 0 0 0 0 0 0 0 0 0 0 0 0 |   |   |                                    | 50 60 70 80 90 100<br>id Limit, W <sub>L</sub> (%)  |  |               |    |  |
| a Divisi  | I Environment &<br>ion of Wood Canac<br>:hnical Discipline -                   | da Limited                                    | ure Solution                        |   |                                       | Note 1: Soils                             | re classified and d                             |                                    | DIFIED U  |  | nd helpsvigur |    |  |

|                                       | RD OF BOREHOL  | .E No                                      | <b>o.</b> !  | <u>BH/</u>    | MW           | -1                |                | Drillin    | - Lecation:                          | N: 4709767                                     | 5. 504256                                    |  |                                 |           |                                    |            |            |
|---------------------------------------|--|--|--------------|---------------|--------------|-------------------|----------------|------------|--------------------------------------|--|--|--|---------------------------------|-----------|------------------------------------|------------|------------|
| Project Number<br>Project Client:     |  |  |              |               |              |                   |                |            | g Location:<br>g Method:             | <u>N: 4798767</u><br>150 mm Sol                | E: 594356                                    |  |                                 | —         |                                    |            |            |
| Project Name:                         |  | Flood F                                    | Pemidi       | iation        |              |                   |                |            | g Machine:                           | Track Mount                                    |  | 15   |                                 |           | WC                                 |            | U.         |
|                                       | ion: Burlington, ON  |  |              | <u>auoi.</u>  |              |                   |                | _          | Started:                             | Feb 10, 20                                     |  | npleted: <u>Fe</u>                           | b 10, 20                        |           |                                    |            |            |
| Logged by:                            | PG   | Comp                                       | biled by:    | <i>ı</i> :    | PG           | . <u></u> i       |                | Revie      | ewed by:                             | TR   | Revision                                     | No.: 2,                                      | 3/28/20                         |           |                                    |            |            |
|                                       |  |  | r Ó          |               | AMPLI        |                   |                |            | 1                                    | TESTING  | LAB TES                                      | STING  |                                 |           |                                    |            |            |
| Y Plot                                | DESCRIPTION  |  |              | Sample Number |              | SPT 'N' / RQD (%) | Œ,             | TION (m)   | O SPT □<br>MTO Vane*<br>△ Intact     | Intact   |  | ■ TOV (LEL)<br>6 8<br>▲ TOV (ppm)<br>300 400 | INSTRUMENTATION<br>INSTALLATION |           | COMMEI<br>&<br>GRAIN S<br>DISTRIBU | SIZE       |            |
| told XB000411                         |  |  | Sample Type  | aldmi         | Recovery (%) | N. L              | DEPTH (m)      | ELEVATION  | Remould                              |  | W <sub>P</sub> W<br>■ O<br>Plastic           | W <sub>L</sub><br>•<br>Liquid                | STRU<br>STAL                    |           | (%)                                |            |            |
| Local Ground                          | Surface Elevation: 115.8 m<br>Topsoil                          | 115.7                                      | Sa           | Sa            | Re           | SF                |                |            | 20 40                                |  |  | 60 80  | ĬŽŽ                             | GR        | SA                                 | SI         | CL         |
| ▓`                                    | 50 mm<br>Red   |  | SS           | 1             | 42           | 11                | F              |            | - 0                                  |  | °22  |  |                                 |           |                                    |            |            |
|                                       | Silty Clay / Clayey Silt FILL<br>trace to some sand and gravel |  | I!           |               |              |                   | Ē              | -          | -                                    |  | 22   |  |                                 |           |                                    |            |            |
| ***                                   | firm to stiff<br>moist to damp                                 |  | $\square$    | <u> </u>      | <u> </u>     | <u> </u>          | Ŧ              | 115 —      | 1 :                                  |  |  |  |                                 |           |                                    |            |            |
| ***                                   |  |  | SS           | 2             | 67           | 11                | - 1            | -          |                                      |  | 0-<br>17                                     |  |                                 |           |                                    |            |            |
| ***                                   |  |  | 1 1          |               |              |                   | Ē              |            |                                      |  | <u>17</u>                                    |  |                                 |           |                                    |            |            |
| ***                                   |  | ļ  | $\square$    |               |              | <u> </u>          | 1              |            |                                      |  |  |  |                                 |           |                                    |            |            |
| ***                                   |  |  | 1 !          |               |              |                   | F              | 11/ -      | -                                    |  |  | · · ·  |                                 |           |                                    |            |            |
| ***                                   |  |  | SS           | 3             | 100          | 10                | - 2            | 114 -      |                                      |  | 0<br>17                                      |  |                                 |           |                                    |            |            |
| ***                                   |  | ŀ  | <sup>_</sup> | <u> </u>      |              | +                 | ŧ              |            | -                                    |  |  |  |                                 |           |                                    |            |            |
| ***                                   |  | Γ  | ,            |               |              |                   | Ē              | -          | <b>-</b>                             | ;  |  | · · · · · · · · · · · · · · · · · · ·        |                                 |           |                                    |            |            |
| ***                                   |  |  | SS           | 4             | 75           | 7                 | Ē              |            | -                                    |  | о <sub>19</sub>                              | • •<br>• •<br>• •                            |                                 |           |                                    |            |            |
| ***                                   |  |  | <u> </u>     |               | <b> </b>     | <u> </u>          | ţ              | 113 -      | -                                    |  |  |  |                                 |           |                                    |            |            |
| ***                                   |  | ł  | <b></b> +    | $\vdash$      |              |                   | 3<br>          | -          | -                                    |  |  | · · · · · · · · · · · · · · · · · · ·        |                                 |           |                                    |            |            |
| ***                                   |  |  | SS           | 5             | 83           | 12                | Ē              |            |                                      |  | 0<br>18                                      |  |                                 |           |                                    |            |            |
| ***                                   |  |  | I!           |               |              |                   | F              |            | 1                                    |  | 10   |  |                                 |           |                                    |            |            |
| ***                                   |  |  | <u> </u>     |               | $\square$    | $\square$         | 1              | 112 -      | 1 :                                  |  | · · · · · · · · · · · · · · · · · · ·        |  |                                 |           |                                    |            |            |
| XXX                                   |  |  | 1 1          |               |              |                   | - 4            |            | ]                                    |  | ,  | · · · · · · · · · · · · · · · · · · ·        |                                 |           |                                    |            |            |
| ***                                   |  |  | 1 1          |               |              |                   | Ē              |            | <u>]</u>                             |  |  |  |                                 |           |                                    |            |            |
| ***                                   |  |  | I!           |               |              |                   | F              | -          | 1                                    |  |  | · · ·  |                                 |           |                                    |            |            |
| ***                                   |  |  | <u> </u>     |               |              |                   | 1              | 111 –      | 1                                    |  |  |  |                                 |           |                                    |            |            |
| ***                                   |  |  | SS           | 6             | 71           | 6                 | - 5            |            | -0                                   |  | 0<br>21                                      |  |                                 |           |                                    |            |            |
| ***                                   |  | ł  | <b>—</b> —   | ──            | <u> </u>     | <u> </u>          | ∔ <sup>∙</sup> | -          | 1                                    |  |  |  |                                 |           |                                    |            |            |
| ***                                   |  |  | 1 1          |               |              |                   | F              | -          | Ŧ                                    |  |  |  |                                 |           |                                    |            |            |
| ***                                   |  |  | 1 1          |               |              |                   | Ē              |            | <u>-</u>                             |  |  |  | 6 6                             |           |                                    |            |            |
| ***                                   |  |  | 1 1          |               |              |                   | Ē              | 110 -      | ]                                    |  |  |  |                                 |           |                                    |            |            |
| <b>***</b>                            |  | ŀ  | I'           |               | _            | –                 | 6              | -          | 1                                    | · · · · · · · · · · · · · · · · · · ·          |  |  | ╠╔┟┫╔╿                          |           |                                    |            |            |
| ***                                   |  |  | SS           | 7             | 67           | 7                 | Ē              |            |                                      |  | 0  | ļ  |                                 |           |                                    |            |            |
| ***                                   |  |  |              | '             | 0.           | '                 | F              |            | ] :                                  |  | °22  |  | :目:                             |           |                                    |            |            |
| ***                                   |  | f  | []           | <u> </u>      | <u> </u>     | +                 | ŧ              | 109 -      | -                                    |  |  |  |                                 |           |                                    |            |            |
| XX                                    | Red  | 108.8<br>7.0                               | i 1          |               |              |                   | - 7            | -          | ]                                    |  |  |  | :目:                             |           |                                    |            |            |
|                                       | Silt Till<br>compact   |  | 1 1          |               |              |                   | F              |            | <b>-</b>                             |  |  |  | [::目::                          |           |                                    |            |            |
|                                       | moist  |  | 1 1          |               |              |                   | F              | -          | -                                    |  |  | • •  |                                 |           |                                    |            |            |
|                                       |  | ſ  | i – ,        |               |              | 1                 | Ē              | 108 —      | 1                                    |  |  |  |                                 |           |                                    |            |            |
|                                       |  |  | SS           | 8             | 0            | 24                | - 8            | 100        | - o                                  | · · · · · · · · · · · · · · · · · · ·          |  |  |                                 |           |                                    |            |            |
|                                       |  | ļ  | <u> </u>     | <b> </b>      | <u> </u>     | <b> </b>          | Ł              | -          | <b>-</b>                             |  |  |  |                                 |           |                                    |            |            |
|                                       |  |  | i 1          |               |              |                   | Ē              |            | 1                                    |  |  |  |                                 |           |                                    |            |            |
|                                       |  |  | i 1          |               |              |                   | F              |            | -                                    |  |  |  | [:目:]                           |           |                                    |            |            |
|                                       |  |  | i 1          |               |              |                   | F              | 107 -      | -                                    |  |  | · · · · · · · · · · · · · · · · · · ·        |                                 |           |                                    |            |            |
|                                       | Red  | 106.6                                      | SS           | 9             | 100          | 50/25             | - 9<br>5-      |            | 1                                    |  | 0_   |  | 目                               | Lipon co  | ompletion bore                     | ehole rem  | ained      |
| Boreho                                | Weathered Shale  | 10 <b>6.5</b>                              |              | 9             | 100          | mm                | ╞──            |            |                                      |  |  |  |                                 | open an   |                                    |            |            |
| Borenoi                               | ble Terminated at Refusal on Inferr<br>Bedrock                 | rea  | 1 1          |               |              |                   |                |            |                                      |  | · · ·  | · · ·  |                                 | schedule  | e 40 PVC pipe<br>10 mil slotted    | e with 3.1 | m          |
|                                       |  |  | 1 1          |               |              |                   |                |            | : :                                  |  |  |  |                                 | sand, sti | tickup monum                       | ent casing | 10.∠<br>J. |
| Wood                                  |  |  |              |               | ·            |                   |                | - crobs    |                                      | the of drilling                                |  |  | <u> </u>                        | <u> </u>  |                                    |            |            |
| Environment & I                       |  |  |              |               |              |                   |                |            | ole upon compl<br>of: <u>8.1 m</u> . | eletion of drilling.                           |  |  |                                 |           |                                    |            |            |
| 3450 Harvester F<br>Burlington, Ontar | ario, L7N 3W5  |  |              |               |              |                   |                |            |                                      | del conditiono pre                             |  |  |                                 |           |                                    |            |            |
| Canada<br>Tel. No.: 1 (905)           | ) 335-2353 a qualifie  | ole details a<br>fied Geotec<br>ssioned an | chnical E    | Engineer.     | . Also, bo   | orehole in        | nformatio      | ion should | d be read in conju                   | ential conditions pre<br>junction with the geo | esent and require in<br>otechnical report fo | terpretative ass<br>r which it was           | sistance fro                    | m         |                                    | Scale: 1   | 1:53       |
| www.woodplc.com                       | m  | .5101.02 -                                 |              | Jon.p ,       | ////9        | 16111444          | 0. 20. 2       |            |                                      |  |  |  |                                 |           | F                                  | Page: 1    | of 1       |

| R              | ECORD                             | OF BOREHO   | LE N                          | 0.                     | BH/           | MW                    | <u>-2</u>             |                      |                         |                                    |  |   |   |                                 |  |  |                 |
|----------------|-----------------------------------|---|-------------------------------|------------------------|---------------|-----------------------|-----------------------|----------------------|-------------------------|------------------------------------|--|---|---|---------------------------------|--|--|-----------------|
|                | ect Number:                       |   |                               |                        |               |                       |                       |                      | -                       | g Location:                        | <u>N: 4798729</u>  |   |   |                                 |  |  | Т               |
| -              | ect Client:                       | City of Burlington  |                               |                        |               |                       |                       |                      | -                       | g Method:                          |  | lid Stem Auge   | ers   |                                 |  | WOO  | O.              |
| -              | ect Name:                         | Burlington Stormwate  | er Flood F                    | Remidi                 | ation         |                       |                       |                      |                         | g Machine:                         | Track Mount  |   | unlatadi <b>F</b> a                                       | h 44 - 20                       |  |  |                 |
| Proj           | ect location:                     | Burlington, ON  |                               |                        |               |                       |                       |                      | Date                    | Started:                           | Feb 11, 20   | Date Cor  | npleted: Fe   | 0 11, 20                        |  |  |                 |
| Log            | ged by:                           | PG  | Comp                          | iled by                |               | PG                    |                       | -                    | Revie                   | wed by:                            | TR<br>TESTING  | Revision  |   | 3/28/20                         |  |  |                 |
|                | LITH                              |   |                               | SC                     | DIL SA        | AMPL                  | _                     |                      |                         | Penetra                            | ationTesting   | Soil Vapour<br>COV (LEL)  | Reading<br>TOV (LEL)                                      | NOI                             | с  | OMMENTS  |                 |
| Lithology Plot |                                   | DESCRIPTION   |                               | Sample Type            | Sample Number | Recovery (%)          | SPT 'N' / RQD (%)     | DEPTH (m)            | ELEVATION (m)           | MTO Vane*<br>△ Intact<br>▲ Remould | PPT • DCPT<br>Nilcon Vane*<br>• Intact<br>• Remould<br>hear Strength (kPa) | 2 4<br>△ COV (ppm)<br>100 200<br>W <sub>P</sub> W<br>● O<br>Plastic | 6 8<br>▲ TOV (ppm)<br>300 400<br>W <sub>L</sub><br>Liquid | INSTRUMENTATION<br>INSTALLATION |  | &<br>RAIN SIZE<br>STRIBUTION<br>(%)  |                 |
|                | Local Ground Surfa                | ce Elevation: 104.7 m<br>Paving Stones  | 104.5                         | Sa                     | Sa            | Re                    | SP                    | _ <u>8</u>           | Ш                       | 20 40                              |  | 20 40   | 60 80   | Ξž                              | GR   | SA SI  | CL              |
| ×              | Geo                               | 150 mm<br>otextile Layer at 150 mm<br>Red   | 0.2                           | SS                     | 1             | 0                     | 50 / 25<br>mm         | -                    |                         | -                                  |  |   | · · · · · · · · · · · · · · · · · · ·                     |                                 |  |  |                 |
|                | Silt<br>trace                     | ty Clay / Clayey Silt <b>FILL</b><br>to some sand and gravel<br>firm to very stiff<br>moist |                               |                        |               |                       |                       |                      | 104 -                   |                                    |  |   |   |                                 |  |  |                 |
|                |                                   | moist   |                               | SS                     | 2             | 21                    | 5                     | 1<br><br>            |                         |                                    |  | 0 <sub>16</sub>   |   |                                 |  |  |                 |
|                |                                   |   |                               | ss                     | 3             | 58                    | 5                     |                      | 103 -                   | -0                                 |  |   |   |                                 |  |  |                 |
|                |                                   |   |                               |                        | 3             | 56                    | 5                     | -<br>- 2<br>-        |                         |                                    |  | 0<br>13   |   |                                 |  |  |                 |
| *              |                                   |   |                               | SS                     | 4             | 25                    | 12                    | -<br>-<br>-          |                         | - 0                                |  | ° <sub>14</sub>   |   |                                 |  |  |                 |
| *              |                                   |   |                               |                        |               |                       |                       | -<br>-<br>           | 102 -                   |                                    |  |   |   |                                 |  |  |                 |
|                |                                   |   |                               | SS                     | 5             | 75                    | 17                    | -                    |                         | 0                                  |  |   |   |                                 |  |  |                 |
|                |                                   |   |                               |                        |               |                       |                       | -                    | 101 -                   | -                                  |  |   | · · · · · · · · · · · · · · · · · · ·                     |                                 |  |  |                 |
|                |                                   |   |                               |                        |               |                       |                       | 4<br><br>            |                         |                                    |  |   |   |                                 |  |  |                 |
|                |                                   | Brown<br>Silt Till  | 100.1<br>4.6                  |                        |               |                       |                       |                      | 100 -                   |                                    |  |   | · · · · · · · · · · · · · · · · · · ·                     |                                 |  |  |                 |
|                |                                   | Geotextile at 4.5 m<br>dense<br>moist   |                               | SS                     | 6             | 38                    | 22                    | -<br>5<br>-          |                         | -<br>-<br>-<br>-                   |  |   |   |                                 |  |  |                 |
|                |                                   |   |                               |                        |               |                       |                       | -                    | 99 -                    |                                    | · · · · · · · · · · · · · · · · · · ·                                      |   |   |                                 |  |  |                 |
|                |                                   |   |                               |                        |               |                       |                       | - 6                  | 55                      |                                    |  |   |   |                                 |  |  |                 |
|                |                                   |   |                               | SS                     | 7             | 100                   | 38                    | -                    |                         |                                    |  | - o<br>12   | · · · · · · · · · · · · · · · · · · ·                     |                                 |  |  |                 |
|                |                                   |   |                               |                        |               |                       |                       | -                    | 98 -                    |                                    |  | · · · · · · · · · · · · · · · · · · ·                               |   |                                 |  |  |                 |
|                |                                   |   |                               |                        |               |                       |                       | 7<br><br>            |                         |                                    |  |   |   |                                 |  |  |                 |
|                |                                   |   |                               |                        |               |                       |                       |                      | 97 -                    |                                    |  |   | · · · · · · · · · · · · · · · · · · ·                     |                                 |  |  |                 |
|                |                                   |   |                               | SS                     | 8             | 67                    | 42                    | - 8                  |                         |                                    | )  | 8   |   |                                 |  |  |                 |
|                |                                   |   |                               |                        |               |                       |                       | -<br>-<br>-          |                         | -                                  |  |   |   |                                 |  |  |                 |
|                |                                   |   |                               |                        |               |                       |                       | -<br>-<br>- 9        | 96 -                    |                                    |  | · · · · · · · · · · · · · · · · · · ·                               | · · · · · · · · · · · · · · · · · · ·                     |                                 |  |  |                 |
|                |                                   |   | 95.4                          | SS                     | 9             | 0                     | 50 / 25<br>mm         | - <sup>-</sup>       |                         |                                    |  | 0 <sub>11</sub>   | · · · · · · · · · · · · · · · · · · ·                     |                                 | Upon comp<br>open and d                    | letion borehole re   | mained          |
|                | Borehole Te                       | erminated at Refusal on In<br>Bedrock   | ferred9.3                     |                        |               |                       |                       |                      |                         |                                    |  |   |   |                                 | Well installa<br>schedule 40<br>length #10 | ry.<br>ttion: 5 cm diamet<br>) PVC pipe with 3.<br>mil slotted screen,<br>ip monument casi | .1 m<br>No. 2   |
| Woo            | d                                 |   | Nofer                         |                        |               | uotoo -'              |                       |                      | berr                    |                                    | otion of definition of   | : :   |   |                                 |  |  |                 |
| Envi           |                                   |   | Groundwa                      |                        |               |                       |                       |                      |                         |                                    | etion of drilling.   |   |   |                                 |  |  |                 |
| Burli<br>Cana  | ngton, Ontario, L<br>ada          | -7N 3W5 Bore  | hole details                  | as prese               | nted, do      | not cons              | titute a th           | norough              | understa                | nding of all pote                  | ential conditions pre  | esent and require in  | terpretative as   | sistance fro                    | m  | Soole  | 1.50            |
| Tel. I<br>www  | No.: 1 (905) 335-<br>.woodplc.com | -2353 a qua<br>comi   | alified Geote<br>missioned ar | cnnical E<br>nd the ac | company       | AISO, bo<br>ying 'Exp | renole in<br>lanation | ormation<br>of Borel | on should<br>hole Log'. | be read in conj                    | unction with the geo   | necnnical report fo   | or which it was   |                                 |  | Page: 2  | :1:53<br>1 of 1 |

| R                                       | ECORD                               | OF BOREH                                      |   | 0.          | BH/           | MW           | -3            |           |           |                         |   |   |                                       |                                 |                         |  |               |
|---|-------------------------------------|---|---|-------------|---------------|--------------|---------------|-----------|-----------|-------------------------|---|---|---------------------------------------|---------------------------------|-------------------------|--|---------------|
| Pro                                     | ject Number:                        | TPB198130                                     |   |             |               |              |               |           | Drilling  | g Location:             | <u>N: 4798976</u>                               | E: 595233                                   |                                       |                                 |                         |  |               |
| Pro                                     | ject Client:                        | City of Burlington                            |   |             |               |              |               |           |           | g Method:               | 150 mm So                                       | olid Stem Auge                              | ers                                   |                                 | _                       | WO   | od.           |
| Pro                                     | ject Name:                          | Burlington Stormw                             | ater Flood F  | Remidi      | ation         |              |               |           | Drilling  | g Machine:              | Track Mount                                     | ted Drill                                   |                                       |                                 |                         |  |               |
| Pro                                     | ject Location:                      | Burlington, ON                                |   |             |               |              |               |           | Date      | Started:                | Feb 11, 20                                      | Date Cor                                    | mpleted: <u>Fe</u>                    | b 11, 20                        |                         |  |               |
| Log                                     | iged by:                            | PG  | Comp  | iled by     | r:            | PG           |               |           | Revie     | wed by:                 | TR  | Revision                                    | No.: 2,                               | 3/28/20                         |                         |  |               |
|   | LITH                                | OLOGY PROFILE                                 |   | SC          | DIL SA        | MPL          | NG            |           |           | FIELD                   | TESTING   | LAB TE<br>Soil Vapou                        |                                       | _                               |                         |  |               |
|   |                                     |   |   |             |               |              | (%            |           | (E)       |                         |   | COV (LEL)<br>2 4                            | TOV (LEL)                             | INSTRUMENTATION<br>INSTALLATION | (                       | COMMEN                                       | ITS           |
| lot                                     |                                     | DESCRIPTION                                   |   | be          | mber          | (%           | 'N' / RQD (%) | 2         |           | O SPT □<br>MTO Vane*    | PPT • DCPT<br>Nilcon Vane*                      |   | TOV (ppm)                             | TION                            |                         | &<br>GRAIN S                                 | IZE           |
| ogy F                                   |                                     |   |   | le Ty       | le Nu         | /ery (       | N', R         | ц<br>Н    | ATIC      | ∆ Intact<br>▲ Remould   | <ul> <li>♦ Intact</li> <li>♦ Remould</li> </ul> | W <sub>P</sub> W                            |                                       | ALLA                            | D                       | ISTRIBUT<br>(%)                              | ΓΙΟΝ          |
| Lithology Plot                          | Local Ground Surf                   | ace Elevation: 105.2 m                        |   | Sample Type | Sample Number | Recovery (%) | SPT -         | DEPTH (m) | ELEVATION | * Undrained Sh<br>20 40 | ear Strength (kPa)<br>60 80                     | Plastic<br>20 40                            | Liquid                                | INSTI<br>INST                   | GR                      | SA (70)                                      | SI CL         |
| ~~~~~~~~~~~~~~~~~~~~~~~~~~~~~~~~~~~~~~~ | <u></u> ∩                           | Topsoil<br>150 mm                             | 105.0<br>0.2  |             |               |              |               | -         | 105 -     |                         |   |   |                                       |                                 |                         |  |               |
|   | Si                                  | Red<br>ty Clay / Clayey Silt <b>FILL</b>      |   | SS          | 1             | 42           | 7             | -         |           | 0                       | •••••   | 0<br>13                                     |                                       |                                 |                         |  |               |
|   | trac                                | e to some sand and grav<br>firm to very stiff | vel   |             |               |              |               | Ē         |           |                         |   |   |                                       |                                 |                         |  |               |
|   |                                     | moist   |   |             |               |              |               | Ē,        |           |                         |   |   |                                       |                                 |                         |  |               |
|   |                                     |   |   | SS          | 2             | 29           | 9             | - '       | 104 -     | 0                       | · · · · · · · · · · · · · · · · · · ·           | 0 <sub>14</sub>                             |                                       |                                 |                         |  |               |
|   |                                     |   |   |             |               |              |               | Ē         |           |                         |   |   |                                       |                                 |                         |  |               |
|   |                                     |   |   |             |               |              |               | -         |           |                         | · · ·   |   | · · ·                                 |                                 |                         |  |               |
|   |                                     |   |   | SS          | 3             | 25           | 7             | - 2       |           | 0                       |   | °10   |                                       |                                 |                         |  |               |
|   |                                     |   |   |             |               |              |               | F         | 103 -     |                         |   |   |                                       |                                 |                         |  |               |
|   |                                     |   |   |             |               |              |               | Ē         |           |                         | •••••   |   |                                       |                                 |                         |  |               |
|   |                                     |   |   | SS          | 4             | 92           | 35            | -         |           | 0                       | •••••   | °12   |                                       |                                 |                         |  |               |
|   |                                     |   |   |             |               |              |               | - 3       |           |                         | · · · · · · · · · · · · · · · · · · ·           |   |                                       |                                 |                         |  |               |
|   |                                     |   |   |             | _             | 100          |               | -         | 102 -     |                         |   |   |                                       |                                 |                         |  |               |
|   |                                     |   |   | SS          | 5             | 100          | 14            | -         |           | 0                       |   | 15  |                                       |                                 |                         |  |               |
|   |                                     |   |   |             |               |              |               | Ē         |           |                         | •••••   |   |                                       | 1                               |                         |  |               |
|   |                                     |   | 101.1   |             |               |              |               | - 4       |           |                         | · · · · · · · · · · · · · · · · · · ·           |   | · · · · · · · · · · · · · · · · · · · |                                 |                         |  |               |
| T                                       |                                     | Red<br>Silt                                   | 4.1   |             |               |              |               | Ē         | 101 -     |                         |   |   |                                       |                                 |                         |  |               |
|   | some<br>Col                         | sand, trace clay and gra                      | avel<br>m   |             |               |              |               | Ē         |           |                         |   |   |                                       |                                 |                         |  |               |
|   |                                     | compact to dense<br>moist                     |   | SS          | 6             | 67           | 10            | -         |           |                         | · · ·   |   |                                       |                                 |                         |  |               |
|   |                                     |   |   | 55          |               | 07           |               | - 5       |           |                         |   | 0<br>13                                     |                                       |                                 |                         |  |               |
|   |                                     |   |   |             |               |              |               | Ē         | 100 -     |                         | · · · · · · · · · · · · · · · · · · ·           | · · · · · · · · · · · · · · · · · · ·       |                                       |                                 |                         |  |               |
|   |                                     |   |   |             |               |              |               | -         |           |                         | •••••   |   |                                       | 1 日 1                           |                         |  |               |
|   |                                     |   |   |             |               |              |               | -         |           |                         | · · · · · · · · · · · · · · · · · · ·           |   |                                       |                                 |                         |  |               |
|   |                                     | Red   | 99.1<br>6 1   | SS          | 7             | 150          | 50/50         | - 6       | 99 -      |                         |   | 0_  | · · · · · · · · · · · · · · · · · · · | 目                               |                         |  |               |
|   | Borehole T                          | Weathered Shale<br>erminated at Refusal or    | 98:9<br>1 Inferred <sup>6:3</sup>                     | 33          | 1             | 150          | mm            | <u> </u>  | 99        |                         |   |   |                                       |                                 |                         |  | hole remained |
|   | 2010110101                          | Bedrock                                       |   |             |               |              |               |           |           |                         |   |   | · · ·                                 |                                 | open and<br>Well instal | llation: 5 cm                                | diameter      |
|   |                                     |   |   |             |               |              |               |           |           |                         |   |   |                                       |                                 | length #10              | 40 PVC pipe<br>) mil slotted s<br>kup monume | screen, No. 2 |
|   |                                     |   |   |             |               |              |               |           |           |                         | · ·   |   |                                       |                                 | Sanu, Sucr              | tup monume                                   | ni casing.    |
|   |                                     |   |   |             |               |              |               |           |           |                         |   |   |                                       |                                 |                         |  |               |
|   |                                     |   |   |             |               |              |               |           |           |                         | · · ·   |   |                                       |                                 |                         |  |               |
|   |                                     |   |   |             |               |              |               |           |           |                         |   |   |                                       |                                 |                         |  |               |
|   |                                     |   |   |             |               |              |               |           |           |                         | · ·   |   |                                       |                                 |                         |  |               |
|   |                                     |   |   |             |               |              |               |           |           |                         |   |   |                                       |                                 |                         |  |               |
|   |                                     |   |   |             |               |              |               |           |           |                         | • • •<br>• • •<br>• •                           |   | · · · · · · · · · · · · · · · · · · · |                                 |                         |  |               |
|   |                                     |   |   |             |               |              |               |           |           |                         |   |   | · · ·                                 |                                 |                         |  |               |
|   |                                     |   |   |             |               |              |               |           |           |                         | • •   | • •   | · · ·                                 |                                 |                         |  |               |
| Woo<br>Envi                             |                                     | astructure Solutions                          | -   |             |               |              |               |           |           |                         | etion of drilling.                              |   |                                       |                                 |                         |  |               |
| Burli                                   | ) Harvester Roa<br>ington, Ontario, | L7N 3W5                                       |   |             |               |              |               |           |           |                         |   |   |                                       |                                 |                         |  |               |
|   | No.: 1 (905) 335                    | _2353 a                                       | orehole details<br>qualified Geote<br>commissioned ar | chnical E   | Ingineer.     | Also, bo     | rehole in     | formatio  | on should | be read in conju        | ntial conditions pre<br>Inction with the geo    | esent and require i<br>otechnical report fo | or which it was                       | sistance fro                    | 411                     |  | Scale: 1 : 53 |
| www                                     | .woodplc.com                        |   |   |             |               |              |               |           | -         |                         |   |   |                                       |                                 |                         | I P  | age: 1 of 1   |

| R                  | ECORD (              | OF BOREH   |                         | 0.                    | BH-           | <u>4</u>             |                   |                                 |   |                                    |   |   |  |                                 |    |                         |               |        |
|--------------------|----------------------|--|-------------------------|-----------------------|---------------|----------------------|-------------------|---------------------------------|---|------------------------------------|---|---|--|---------------------------------|----|-------------------------|---------------|--------|
| Pro                | ject Number:         | TPB198130  |                         |                       |               |                      |                   |                                 | Drilling  | Location:                          | <u>N: 4799128</u>                               | E: 595375   |  |                                 |    |                         |               |        |
| Pro                | ject Client:         | City of Burlington   |                         |                       |               |                      |                   |                                 | Drilling  | Method:                            |   | lid Stem Aug  | ers                                    |                                 | _  | W                       | 00            | d.     |
|                    |                      | Burlington Stormw  | ater Flood F            | Remidi                | ation         |                      |                   |                                 |   | Machine:                           | Track Mount                                     |   |  |                                 | —  |                         |               |        |
| Pro                | ject Location:       | Burlington, ON   |                         |                       |               |                      |                   |                                 | Date S  | Started:                           | Feb 11, 20                                      | Date Co   | mpleted: Fe                            | b 11, 20                        |    |                         |               |        |
| Log                | , ,                  | PG   | Comp                    | iled by               |               | PG                   |                   |                                 | Revie   | wed by:                            | TR  | Revision  | -                                      | 3/28/20                         |    |                         |               |        |
|                    | LITHO                | LOGY PROFILE   |                         | SC                    |               | MPLI                 |                   |                                 | Ű.  | Penetra                            | TESTING<br>ationTesting<br>PPT • DCPT           | Soil Vapou<br>COV (LEL)<br>2 4  | ur Reading                             | ATION                           |    | COMMI<br>&              |               |        |
| Lithology Plot     | C                    | DESCRIPTION  |                         | Sample Type           | Sample Number | Recovery (%)         | SPT 'N' / RQD (%) | DEPTH (m)                       | ELEVATION (   | MTO Vane*<br>△ Intact<br>▲ Remould | <ul> <li>♦ Intact</li> <li>♦ Remould</li> </ul> | W <sub>P</sub> W  | 300 400<br>/ WL                        | INSTRUMENTATION<br>INSTALLATION |    | GRAIN<br>DISTRIB<br>(%) | SIZE<br>UTION |        |
| Lith               | Local Ground Surface | e Elevation: 105.2 m<br>Topsoil  | 105.1                   | San                   | San           | Rec                  | SPT               | DEF                             | ELE   | * Undrained Sh<br>20 40            | ear Strength (kPa)<br>60 80                     | Plastic<br>20 40  | Liquid<br>60 80                        | SNS                             | GR | SA                      | SI            | CL     |
|                    | Silty<br>trace to    | 100 mm<br>Red<br>Clay / Clayey Silt FILL<br>o some sand, trace grav<br>firm to very stiff<br>moist to damp | 105.1<br>0.1            | SS                    | 1             | 29                   | 10                |                                 | 105   | 0                                  |   | 0<br>15   |  |                                 |    |                         |               |        |
|                    |                      |  |                         | SS                    | 2             | 75                   | 9                 | -<br>- 1<br>-<br>-              | -<br>-<br>-<br>-<br>-<br>-  | 0                                  |   | 0<br>18   |  |                                 |    |                         |               |        |
|                    |                      |  |                         | SS                    | 3             | 71                   | 14                | -<br>-<br>- 2<br>-              | -<br>-<br>-<br>-<br>-<br>-<br>-<br>-<br>-<br>-<br>-<br>-<br>-<br>-<br>-<br>-<br>-<br>-<br>- | 0                                  |   | 0<br>18   |  |                                 |    |                         |               |        |
|                    |                      |  |                         | SS                    | 4             | 46                   | 12                |                                 | -   | 0                                  |   | °13   |  |                                 |    |                         |               |        |
|                    |                      |  |                         | SS                    | 5             | 100                  | 21                | - 3<br>-<br>-<br>-              | 102 -   | 0                                  |   | ••••••••••••••••••••••••••••••••••••••  |  |                                 |    |                         |               |        |
|                    |                      |  |                         |                       |               |                      |                   | -<br>-<br>- 4<br>-<br>-<br>-    | -<br>-<br>-<br>101 —<br>-<br>-  |                                    |   |   |  |                                 |    |                         |               |        |
|                    |                      |  |                         | SS                    | 6             | 58                   | 27                | -<br>-<br>-<br>-<br>-<br>-<br>- | 100 -   | Ō                                  |   | 0,<br>15  |  |                                 |    |                         |               |        |
|                    |                      |  | 99.1                    |                       |               |                      | 50 / 76           |                                 | -   |                                    |   |   |  |                                 |    |                         |               |        |
| Wo                 |                      | Red<br>Shale<br>minated at Refusal or<br>Bedrock   | 98.9<br>6.2<br>Inferred | s                     |               |                      | mm                | -                               | -   |                                    |   | 9   |  |                                 |    |                         |               |        |
| 345<br>Burl<br>Car |                      | B 8  | orehole details         | as prese<br>chnical E | nted, do      | not cons<br>Also, bo | itute a th        | orough                          | understar   | nding of all pote                  | etion of drilling.<br>ntial conditions pre      | esent and require in the second se | interpretative ass<br>for which it was | istance from                    | m  |                         | Scale:        | 1 : 53 |
|                    | v.woodplc.com        | C  | ommissioned ar          | ia the ac             | company       | ng Exp               | anation o         | Boreh                           | uie Log'.   |                                    |   |   |  |                                 |    |                         | Page: 1       | of 1   |

|                          | ECORD OF BOREHOLE N   | 0.                   | BH/                               | MW           | -6                                   |                                 | Drilling              | Location:   | N: 4800335   | E: 596400  |  |                                 |                             |   |
|--------------------------|---|----------------------|-----------------------------------|--------------|--------------------------------------|---------------------------------|-----------------------|---|--|--|--|---------------------------------|-----------------------------|---|
|                          | pject Client: City of Burlington  |                      |                                   |              |                                      |                                 |                       | Method:   | 150 mm So  |  | iders  |                                 | _                           | wood  |
|                          | bject Name: Burlington Stormwater Flood                                   | Remidi               | ation                             |              |                                      |                                 |                       | y Machine:  | Track Mount  |  | .90.0  |                                 | _                           | wood.   |
|                          | oject Location: Burlington, ON  |                      | uuon                              |              |                                      |                                 |                       | Started:  | Feb 10, 20   |  | Completed: Fe  | b 10, 20                        |                             |   |
| Lo                       | gged by: <b>PG</b> Com  | piled by             | r:                                | PG           |                                      |                                 | Revie                 | wed by:   | TR   | Revisio  | on No.: 2, 3   | 3/28/20                         |                             |   |
|                          | LITHOLOGY PROFILE   | SC                   | DIL SA                            | AMPL         | NG                                   |                                 |                       | FIELD   | TESTING  |  | ESTING   |                                 |                             |   |
| Lithology Plot           | DESCRIPTION   | Sample Type          | Sample Number                     | Recovery (%) | SPT 'N' / RQD (%)                    | DEPTH (m)                       | ELEVATION (m)         | O SPT □<br>MTO Vane*<br>△ Intact<br>▲ Remould<br>* Undrained Sh | tionTesting<br>PPT   DCPT<br>Nilcon Vane*<br>Intact<br>Remould<br>ear Strength (kPa) | □ COV (LEL<br>2 4<br>△ COV (ppm<br>100 200<br>W <sub>P</sub><br>■<br>Plastic | ) ▲ TOV (ppm)<br>) 300 400<br>W W <sub>L</sub><br>Liquid | INSTRUMENTATION<br>INSTALLATION | G<br>DIS                    | OMMENTS<br>&<br>RAIN SIZE<br>STRIBUTION<br>(%)  |
| Ч                        | Local Ground Surface Elevation: 104.8 m<br>Red/Brown                      | Š                    | Š                                 | ž            | SF                                   | <u>10</u>                       |                       | 20 40<br>: :  | 60 80  | 20 40  | 60 80  | ZZ                              | GR                          | SA SI CL  |
|                          | Clayey Silt<br>some gravel<br>soft<br>damp 104.2<br>Red 0.6               | SS                   | 1                                 | 100          | 8                                    | -                               | -<br>-<br>-<br>-<br>- | 0   |  | 0<br>19  |  |                                 |                             |   |
|                          | Silt<br>some gravel and cobbles<br>compact<br>moist                       | s                    | 2                                 | 75           | 36                                   | -<br>                           | 104 -                 | 0   |  | ° <sub>14</sub>  |  |                                 |                             |   |
|                          |   | ss                   | 3                                 | 92           | 52                                   | -<br>-<br>-<br>-<br>-<br>-<br>2 | 103 -                 |   | · O·   | - o<br>13  |  |                                 |                             |   |
|                          | Red 2.1<br>Sit Till<br>layers of weathered shale throughout<br>very dense | SS                   | 4                                 | 91           | 50 /<br>127<br>mm                    | -                               |                       |   |  | -0.<br>10  |  |                                 |                             |   |
|                          | moist   |                      |                                   | 07           | 50 / 76                              | -<br>-<br>- 3<br>-              | 102 -                 |   |  |  |  |                                 |                             |   |
|                          |   | SS                   | 5                                 | 87           | mm                                   | -                               | 101 -                 |   |  |  |  |                                 |                             |   |
| <u> </u>                 | 100.8<br>Red 100.6<br>Weathered Shale 4.∅                                 | ss                   | 6                                 | 0            | 50 / 76<br>mm                        | -<br>4                          |                       |   | · · · · · · · · · · · · · · · · · · ·  | 0  |  |                                 |                             | etion borehole remained   |
|                          | Borehole Terminated on Inferred Bedrock                                   |                      |                                   |              |                                      |                                 |                       |   |  |  |  |                                 | schedule 40<br>length #10 r | y.<br>ton: 5 cm diameter<br>IPVC pipe with 3.1 m<br>nil slotted screen, No. 2<br>p monument casing. |
| 345<br>Bur<br>Car<br>Tel | irronment & Infrastructure Solutions                                      | ater dep<br>as prese | oth obse<br>nted, do<br>Engineer. | not cons     | 3/13/20<br>titute a th<br>rehole inf | 20 at a orough                  | understa              | of: <u>3.0 m</u> .  | etion of drilling.<br>ntial conditions pre<br>nction with the geo                    | esent and requir   | e interpretative ass<br>t for which it was               | istance fro                     | om                          | Scale: 1 : 53<br>Page: 1 of 1   |

| R              | ECORD OF BOREHO  |   | o. <u> </u> | BH-           | 7            |                   |           |           |   |  |   |                               |          |                     |                   |    |
|----------------|--|---|-------------|---------------|--------------|-------------------|-----------|-----------|---|--|---|-------------------------------|----------|---------------------|-------------------|----|
| Pro            | ject Number: TPB198130                                       |   |             |               |              |                   |           | Drilling  | g Location:                                     | <u>N: 4800425</u>  | E: 596548   |                               |          |                     |                   |    |
|                | ject Client: City of Burlington                              |   |             |               |              |                   |           |           | g Method:                                       | 150 mm So  | olid Stem Augers  |                               |          | W                   | 00                | d. |
|                | ject Name: Burlington Stormwa                                | ter Flood F                                       | Remidia     | ation         |              |                   |           |           | g Machine:                                      | Track Moun   |   |                               |          |                     |                   |    |
| Pro            | ject Location: Burlington, ON                                |   |             |               |              |                   |           | Date \$   | Started:  | Feb 10, 20   | Date Complete   | d: Feb 10, 20                 | <u> </u> |                     |                   |    |
| Log            | ged by: PG   | Comp  | iled by     |               | PG           |                   | 1         | Revie     | wed by:   | TR   | Revision No.:   | 2, 3/28/20                    |          |                     |                   |    |
| ot             | LITHOLOGY PROFILE  |   |             |               |              |                   |           | (E)       | Penetra<br>O SPT □                              | TESTING<br>ationTesting<br>PPT • DCPT                                | LAB TESTING           Soil Vapour Reading           □ COV (LEL)         ■ TOV           2         4         6           △ COV (ppm)         ▲ TOV | -                             |          | COMMI<br>&<br>GRAIN |                   |    |
| Lithology Plot |  |   | Sample Type | Sample Number | Recovery (%) | SPT 'N' / RQD (%) | DEPTH (m) | ELEVATION | <ul> <li>△ Intact</li> <li>▲ Remould</li> </ul> | Nilcon Vane*<br>♦ Intact<br>♦ Remould<br>ear Strength (kPa)<br>60 80 | 100 200 300 4<br>W <sub>P</sub> W<br>■ O<br>Plastic Liq   | ● <sup>™</sup> 0              | GR       | DISTRIB<br>(%       | UTION             | CL |
|                | Local Ground Surface Elevation: 105.9 m<br>Topsoil<br>250 mm | 105.6   | 0           | 0             | <u> </u>     | 0                 |           | <u> </u>  | 20 40   | <u>60 80</u>   | 20 40 60  |                               |          |                     |                   |    |
| ΪŤ             | Red<br>Silt  | 0.2   | SS          | 1             | 63           | 10                | -         |           | 0   |  | °14   | ;<br>:                        |          |                     |                   |    |
|                | some gravel and cobbles<br>compact to very dense             |   |             |               |              |                   | -         |           |   |  |   |                               |          |                     |                   |    |
|                | moist  |   | SS          | 2             | 57           | 50 /<br>140       |           | 105 -     |   |  | ° <sub>5</sub>  |                               |          |                     |                   |    |
|                |  | 101 5   |             |               |              | mm                | - '       |           |   |  | 5   |                               |          |                     |                   |    |
|                | Red<br>Silt Till   | 104.5<br>1.4                                      |             |               |              |                   | F         |           |   |  |   | :<br>;                        |          |                     |                   |    |
|                | layers of weathered shale through very dense                 | nout  | SS          | 3             | 100          | 48                | -         |           |   | 0  |   |                               |          |                     |                   |    |
|                | dry to moist   |   | 00          | Ū             | 100          |                   | - 2       | 104 -     |   |  | 0<br>10   | *<br>*<br>*                   |          |                     |                   |    |
|                |  |   |             |               |              |                   | F         |           |   |  |   |                               |          |                     |                   |    |
|                |  |   | SS          | 4             | 83           | 83                | _         |           |   | o  | ° <sub>10</sub>   |                               |          |                     |                   |    |
|                |  |   |             |               |              |                   | -         | 103 -     |   |  |   | · · · · · ·                   |          |                     |                   |    |
|                | Red  | 102.8<br>103:9                                    | SS          | 5             | 86           | 50/25<br>mm       | — 3<br>—  |           |   | · · · · · · · · · · · · · · · · · · ·                                | 0,  |                               |          |                     |                   |    |
|                | Weathered Shale Borehole Terminated at Refus                 | 3.2<br>al   |             |               |              |                   |           |           |   | · · ·  |   | -                             |          |                     |                   |    |
|                |  |   |             |               |              |                   |           |           |   |  |   |                               |          |                     |                   |    |
| Woo<br>Env     | d<br>ronment & Infrastructure Solutions                      | Z No freesta                                      | anding g    | groundv       | vater ob     | ı<br>served i     | n open    | borehol   | e upon compl                                    | etion of drilling.   |   | •                             | 1        |                     |                   |    |
| 345            | ) Harvester Road<br>ngton, Ontario, L7N 3W5                  |   |             |               |              |                   |           |           |   |  |   |                               |          |                     |                   |    |
| Can<br>Tel.    | ada Bo   | rehole details<br>ualified Geote<br>nmissioned ar | chnical E   | ingineer.     | Also, bo     | rehole in         | formatio  | on should | be read in conju                                | ntial conditions pro<br>Inction with the geo                         | esent and require interpreta<br>otechnical report for which   | tive assistance fro<br>it was | om       |                     | Scale:<br>Page: 1 |    |



Photo 1: Hager Creek - BH/MW-01 (March 2020)



Photo 2: Hager Creek - east bank of Upper Hager Creek at 1767 Heather Hills Drive (June 2019)





Photo 3: Hager Creek - slope toe at 1767 Heather Hills Drive (June 2019)



Photo 4: Freeman – BH-4, looking east (March 2020)





Photo 5: Freeman – near BH4 looking west (March 2020)




Photo 6: Rambo – from BH6 looking west (March 2020)








Photo 7: Rambo – culvert north to rail (June 2019)




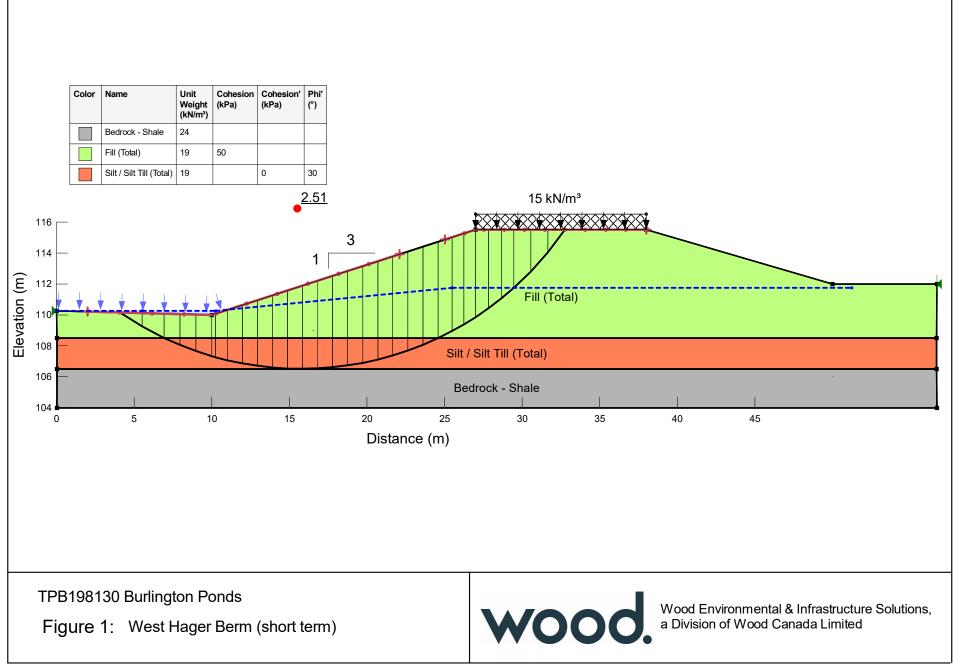


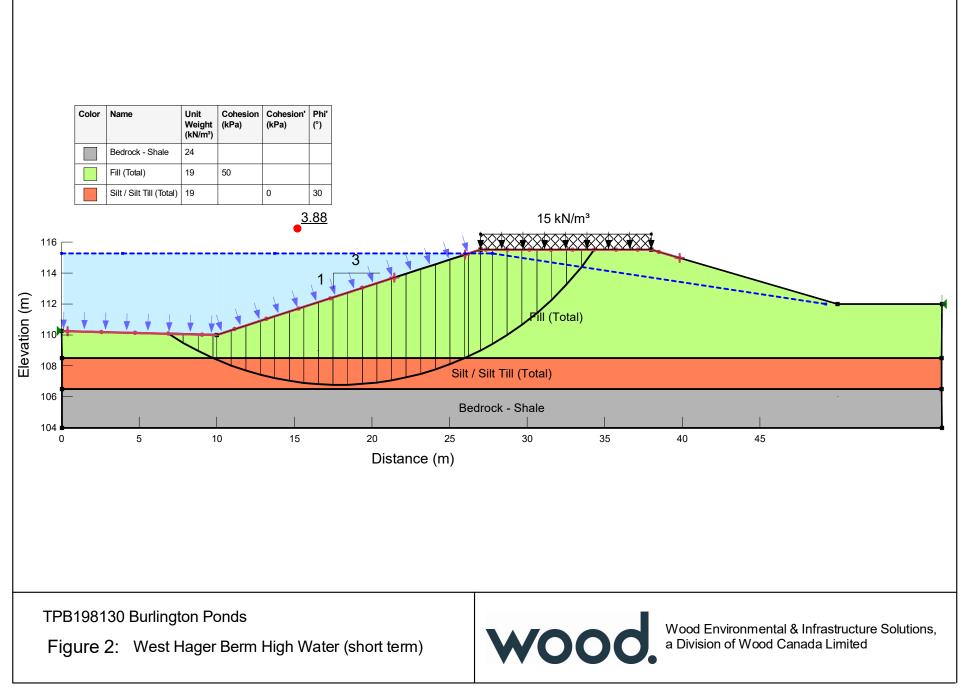


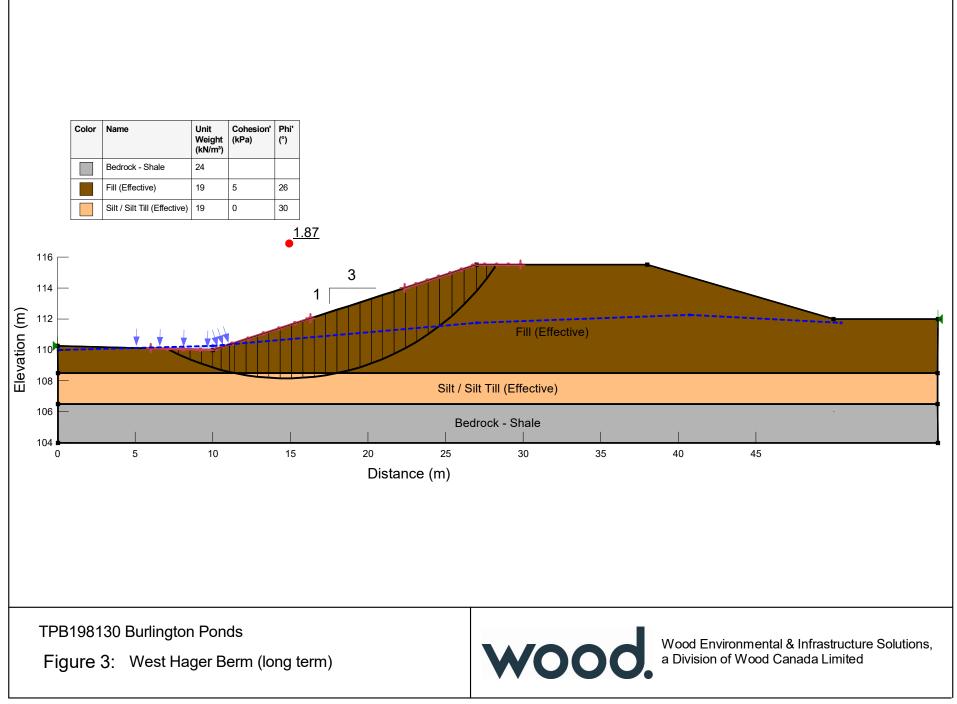


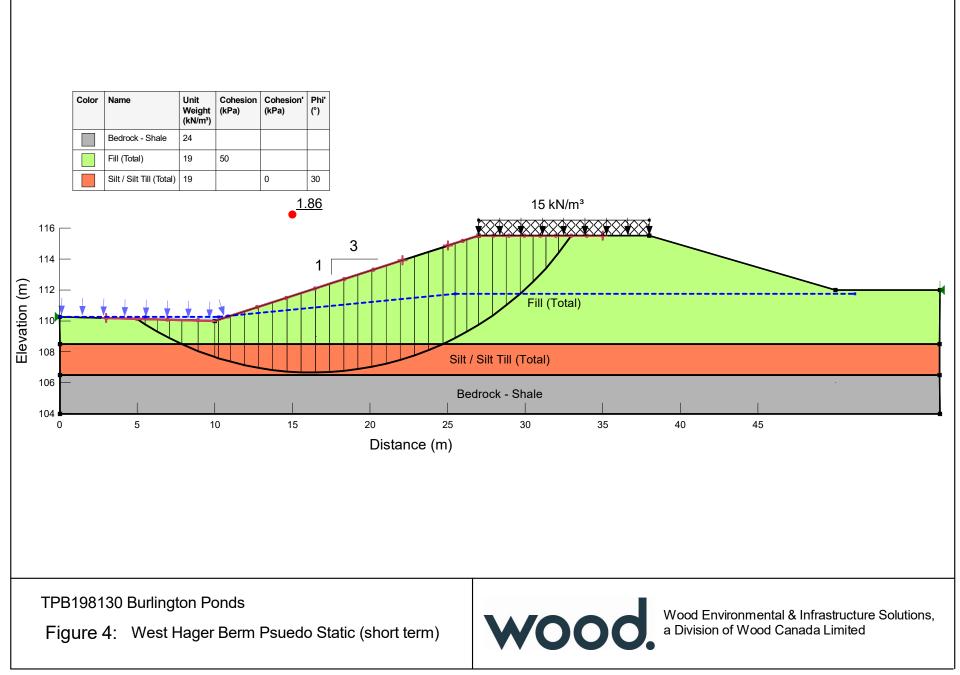


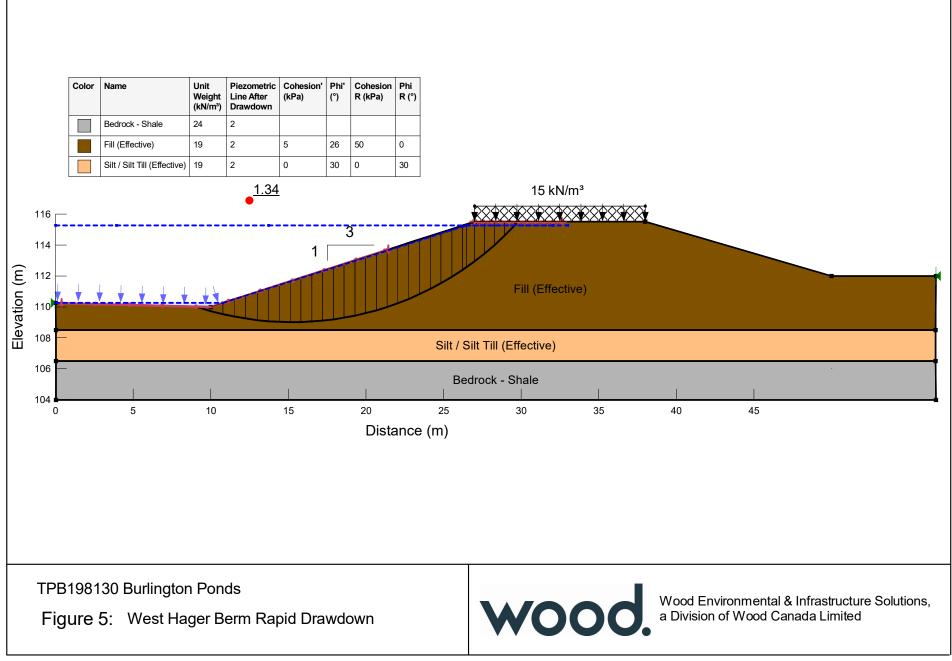


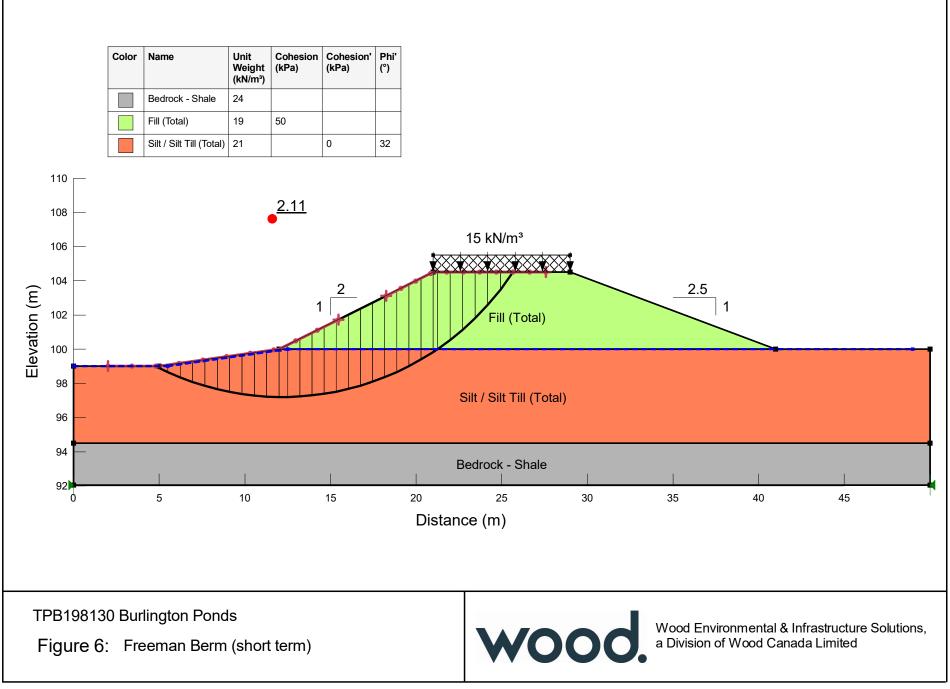


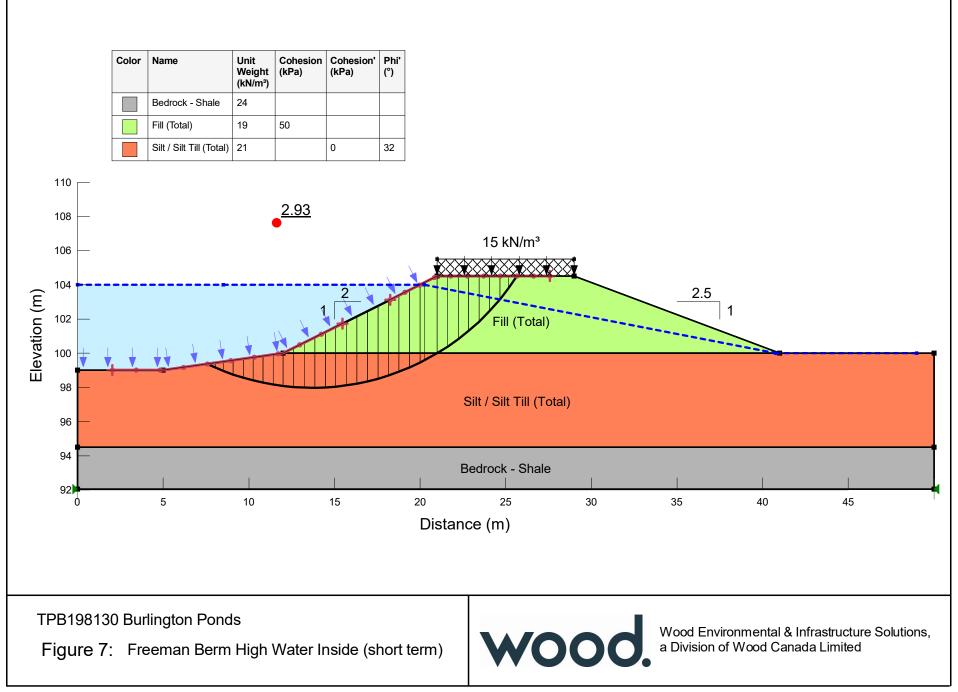


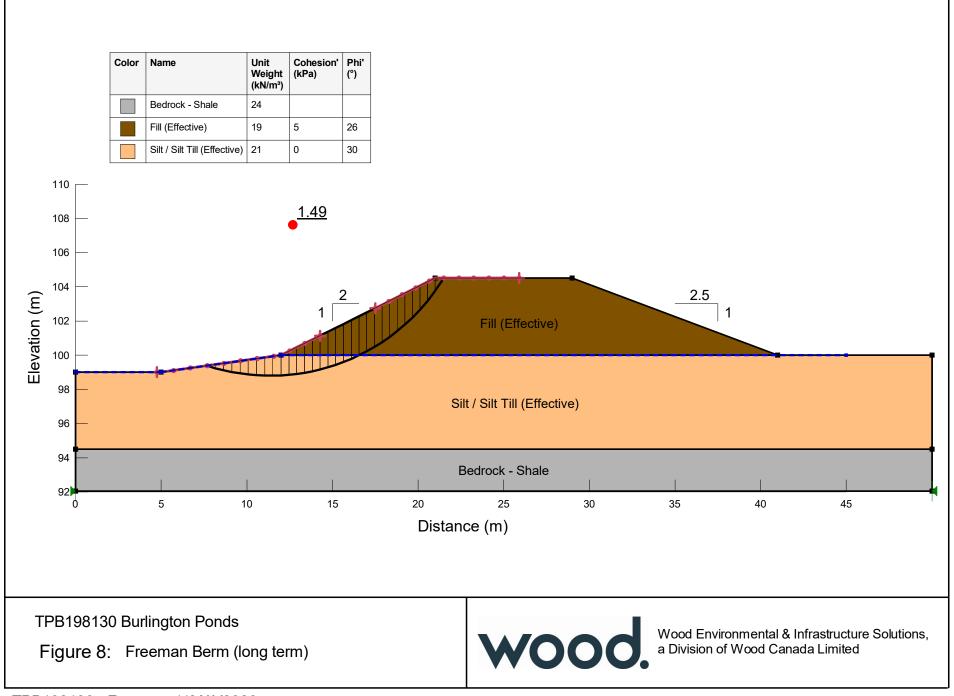


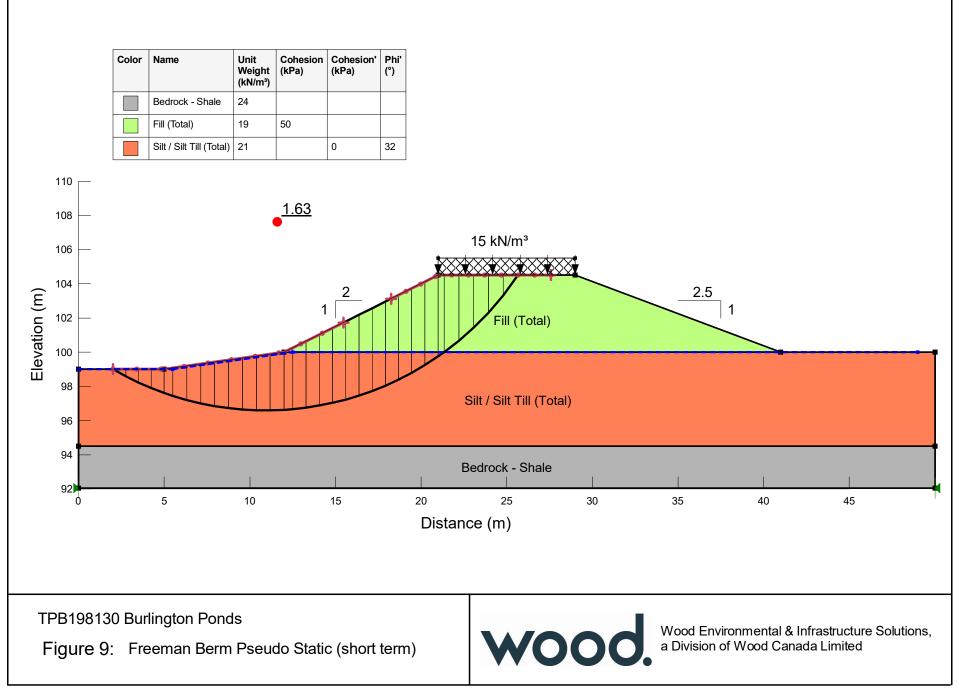


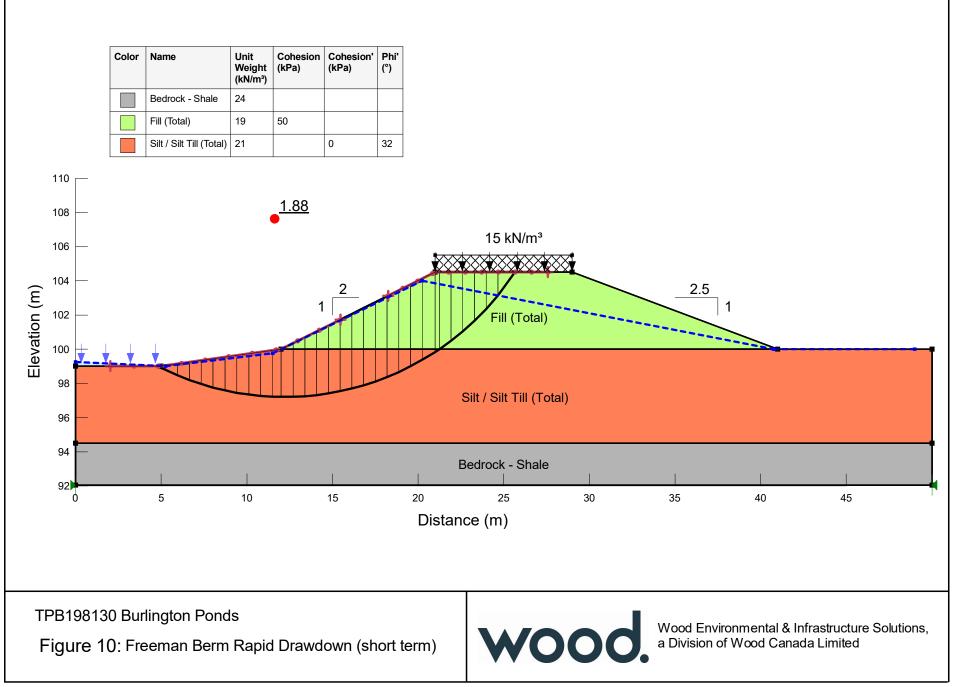


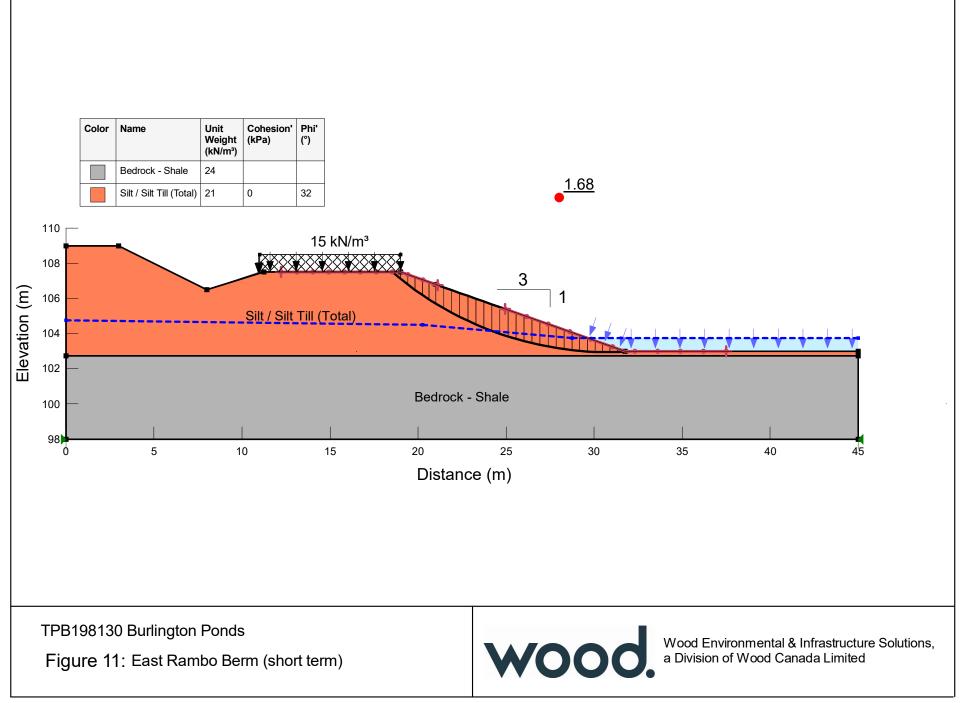

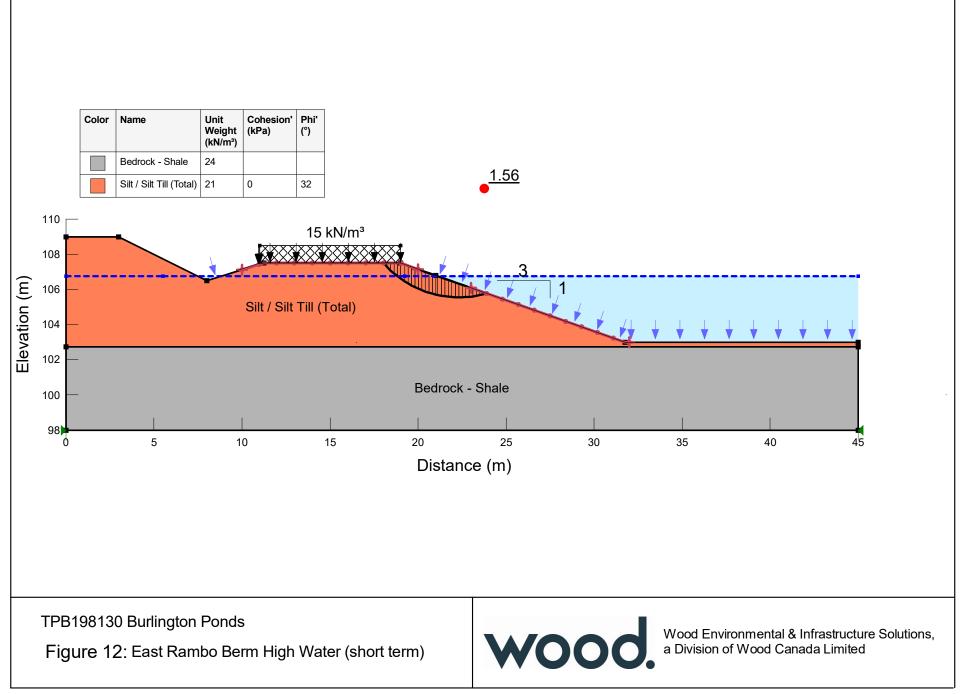

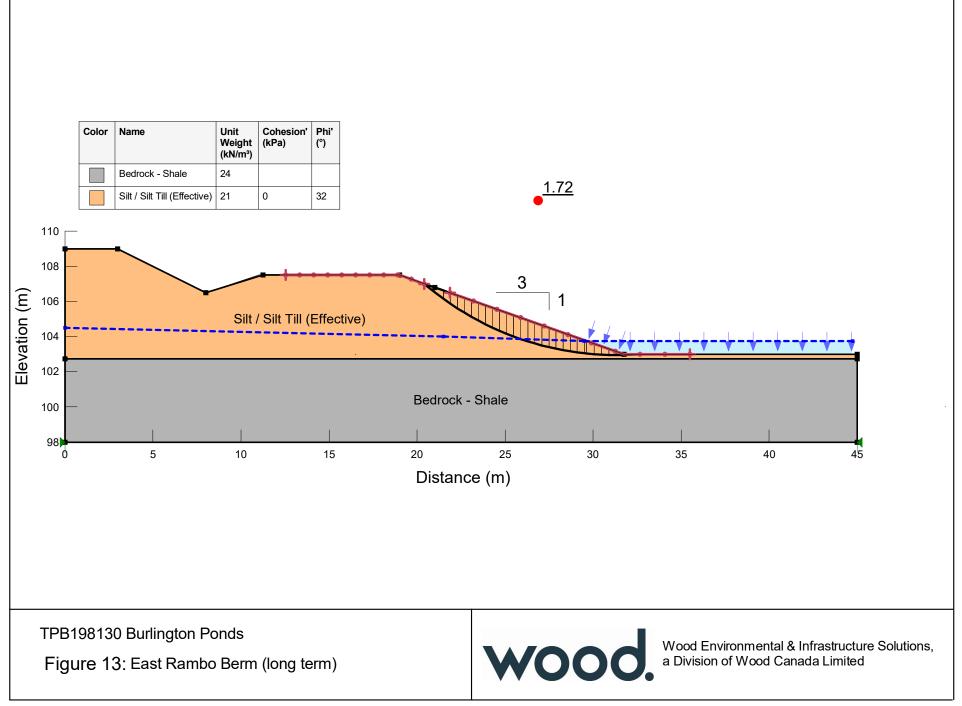

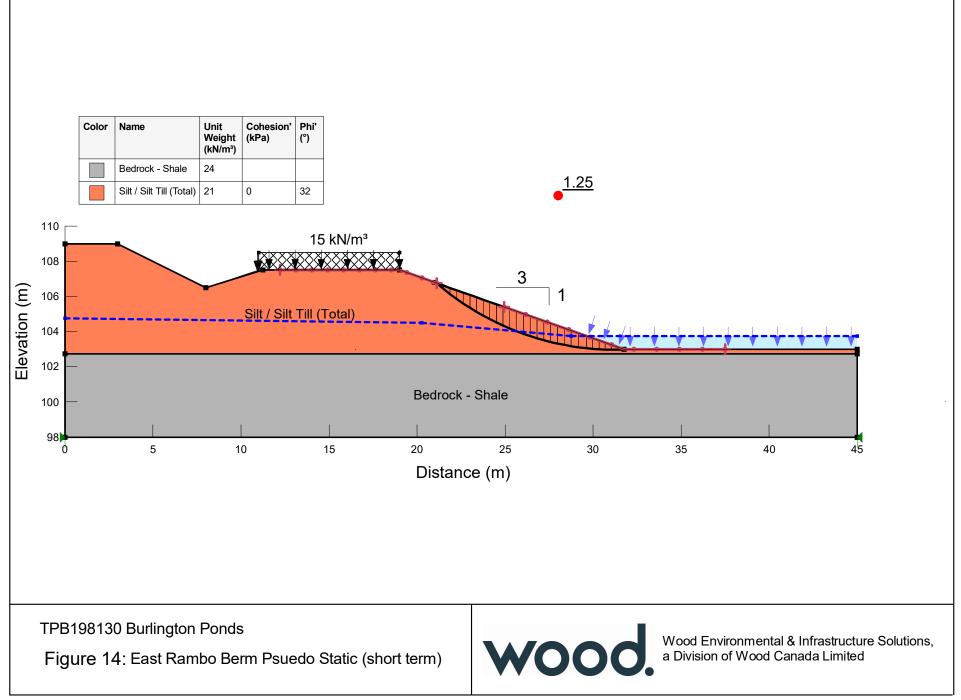

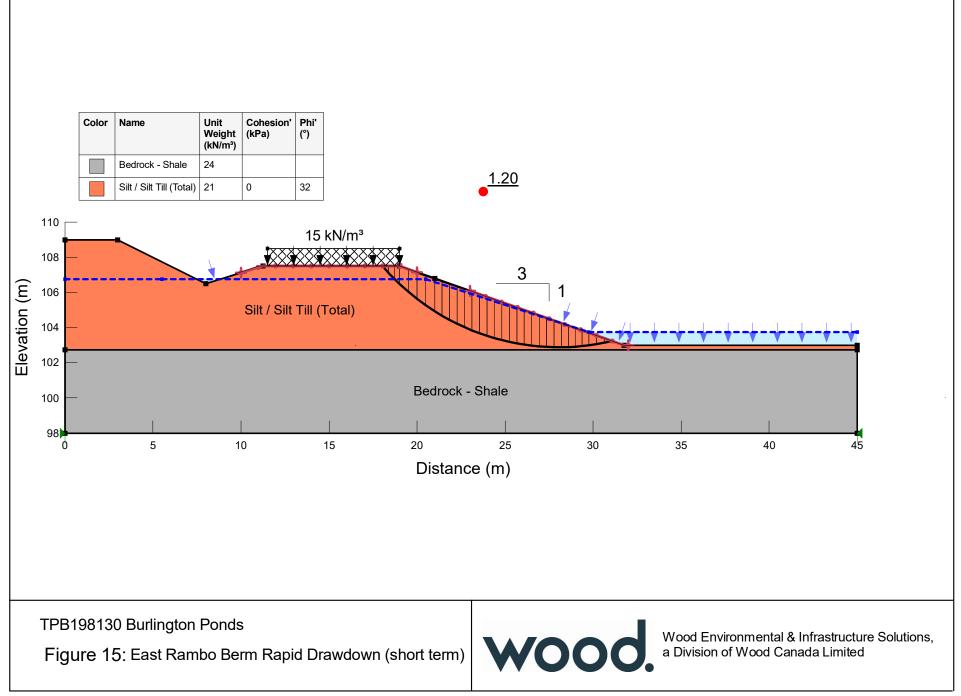



# Appendix C

# **Hydrologic** Modelling

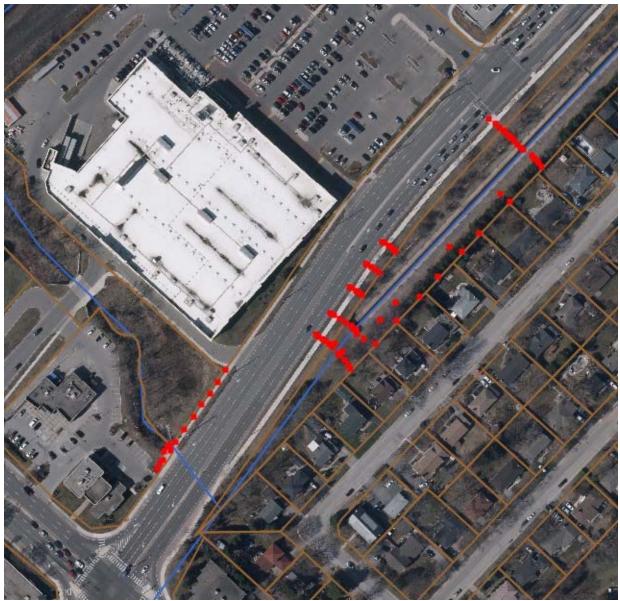


Figure C1: Topographic Survey Verification for Hager-Rambo Diversion Channel



Figure C2: Topographic Survey Verification for East Rambo Pond



Figure C3: Topographic Survey Verification for Freeman Pond



Memorandum

December 10, 2004

104138-26

TO:Philip Kelly, P. Eng.FROM:Aaron Brouwers / Ron ScheckenbergerRE:City of Burlington IDF Relationships and Design Storms

As per our December 1, 2004 work plan, we have updated the IDF curves and the associated IDF parameters as well as regenerated the associated design storms based on the most current information.

#### **SCS Design Storms**

The 1994 Storm Drainage Design Manual (PPEL) developed the IDF relationships based on 27 years of rainfall intensity data (1964–1990) from the Royal Botanical Gardens gauge provided by the Atmospheric Environment Service (AES). The current assessment updates the previous and includes 35 years of data (1962–1996); most notably it includes the large events recorded in 1995. Table 1 compares AES 6 and 12 hour duration rainfall depths used in the 1994 and 2004 assessments; the depths have been used to develop the SCS Type II 6 and 12 hour design storms for the current assessment (ref. Tables 5 & 6, attached).

|                  | TABLE 1<br>COMPARISON OF AES RAINFALL DE | PTHS (mm) |       |
|------------------|--|-----------|-------|
| Duration (hours) | Frequency (Years)                        | 1994      | 2004  |
| 6                | 100                                      | 85.9      | 92.4  |
| 6                | 5  | 48.7      | 51.3  |
| 12               | 100                                      | 92.1      | 103.6 |
| 12               | 5  | 55.2      | 58.9  |

The depths for the 100 year event show an 8 % and 12 % increase for the 6 and 12 hour durations, respectively. The 5 year event experiences lower relative increases of 5 % and 7 % for the 6 and 12 hour durations, respectively. The increases can largely be attributed to events experienced in 1995, which are the largest within the period of record. As would be expected, these large events have more influence on predicted rainfall depths for the less frequent events (i.e. 100 year).

#### IDF Parameters/Curve & Chicago Design Storms

Table 2 summarizes the AES IDF values for the subject gauge. Performing a three-parameter regression, using the SWMHYMO Chicago Storm function, provides initial A, B and C parameters, which define the IDF curve fit. These parameters have been refined through manual regression analysis and are presented in Table 3. The equation for the IDF curves is as follows:

$$i = \frac{A}{\left(t+B\right)^{C}}$$

where: *i* = rainfall intensity (mm/hr) *t* = storm duration (minutes) *A*, *B*, *C* = defined in Table 2

The regression provides only a 'best fit' for the AES data, and when applying the IDF parameters provided, rainfall depths for a given frequency storm and duration will vary from actual statistically derived depths from



#### Memo Page 2

AES (ref. IDF curves attached). This is consistent with 1994 assessment and is necessary in order provide the standard set of three parameters (i.e. A, B &C). The ratio of the time to peak to the total storm duration, r, (used for calculating the Chicago distributions) has been set at 0.48, which is the recommended value for Ontario (Marsalek, 1978). This is consistent with the 1977 and 1994 assessments, which used a value of 0.46 for r. Table 4 presents a comparison of the current and previous IDF assessments; the 3 and 4 hour Chicago design storms are attached (ref. Table 7 & 8).

|                |   | -     | TABLE 2<br>DURATION-FREQUEN | DENS          |       |       |  |  |  |  |  |  |  |  |
|----------------|---|-------|-----------------------------|---------------|-------|-------|--|--|--|--|--|--|--|--|
| Duration (min) |   |       | Rainfall Inter              | nsity (mm/hr) |       |       |  |  |  |  |  |  |  |  |
| Duration (min) | 2   | 5     | 10                          | 25            | 50    | 100   |  |  |  |  |  |  |  |  |
| 5              | 94.6  | 122.2 | 140.6                       | 163.7         | 180.9 | 198.0 |  |  |  |  |  |  |  |  |
| 10             | 68.3  |       |                             |               |       |       |  |  |  |  |  |  |  |  |
| 15             | 55.7  |       |                             |               |       |       |  |  |  |  |  |  |  |  |
| 30             | 36.2  | 47.2  | 54.5                        | 63.7          | 70.5  | 77.3  |  |  |  |  |  |  |  |  |
| 60             | 22.1  | 27.6  | 31.2                        | 35.7          | 39.1  | 42.5  |  |  |  |  |  |  |  |  |
| 120            | 14.3  | 18.6  | 21.4                        | 25.0          | 27.7  | 30.4  |  |  |  |  |  |  |  |  |
| 360            | 6.0 8.5 10.2 12.3 13.9 15.4   |       |                             |               |       |       |  |  |  |  |  |  |  |  |
| 720            | 3.5 4.9 5.8 7.0 7.8 8.6   |       |                             |               |       |       |  |  |  |  |  |  |  |  |
| 1440           | 3.5         4.9         5.8         7.0         7.6         8.0           2.1         2.8         3.3         3.8         4.3         4.7 |       |                             |               |       |       |  |  |  |  |  |  |  |  |

|           |       | IDF PARAMETE | TABLE 3<br>RS – ROYAL BOTAN | ICAL GARDENS |       |        |
|-----------|-------|--------------|-----------------------------|--------------|-------|--------|
| Parameter | 2     | 5            | 10                          | 25           | 50    | 100    |
| A         | 595.5 | 688.2        | 748.0                       | 867.0        | 947.3 | 1036.1 |
| В         | 6.0   | 5.0          | 4.5                         | 4.5          | 4.5   | 4.5    |
| С         | 0.778 | 0.753        | 0.740                       | 0.737        | 0.733 | 0.733  |

|                             | CO    | TABLE 4<br>MPARISON OF IDF ASSESSM | IENTS                   |                         |
|-----------------------------|-------|------------------------------------|-------------------------|-------------------------|
| Iten                        | n     | 1977                               | 1994                    | 2004                    |
| Source of Rainfall Data     |       | Royal Botanical Gardens            | Royal Botanical Gardens | Royal Botanical Gardens |
| Duration of Rainfall Record |       | 12 Years                           | 27 Years (1964-1990)    | 35 Years (1962-1996)    |
| IDF Parameters              |       | ·                                  | •                       | · · · · · ·             |
|                             | A     | 1111                               | 697.4                   | 688.2                   |
| 5 Year                      | В     | 7                                  | 5                       | 5.0                     |
|                             | С     | 0.857                              | 0.764                   | 0.753                   |
|                             | A     | 2377                               | 1114.1                  | 1036.1                  |
| 100 Year                    | В     | 9                                  | 5                       | 4.5                     |
|                             | С     | 0.886                              | 0.761                   | 0.733                   |
| Predicted Depth (mm)        | •     | •                                  | ·                       | •                       |
| 100 Year - 3 Hour Duration  | Depth | 68.5                               | 62.9                    | 67.9                    |
| 5 Year - 3 Hour Duration I  | Depth | 37.6                               | 38.7                    | 40.5                    |
| 100 Year - 4 Hour Duration  | Depth | 71.6                               | 67.7                    | 73.6                    |
| 5 Year - 4 Hour Duration I  | Depth | 39.6                               | 41.7                    | 43.7                    |

The results for the 100 year event show a 5 % and 6 % increase in rainfall depths for the 3 and 4 hour durations, respectively, when comparing the 2004 and 1994 assessments. The 5 year event experiences similar relative increases of 5 % for both the 3 and 4 hour durations, respectively.

We trust this satisfies your current requirements, should you require anything further please do not hesitate to contact our office. Once you have reviewed this information and are in agreement with its content, we will forward you digital copies of this memo and its attachments.

AB/RS/ab

Attach.

G:\work\104138\corr\memo\PKelly Dec 10 2004.doc



### 2.0 Overview

Most studies that incorporate climate change rely on model-generated projections. These projections are most often computed with the use of global climate models (GCMs), which are dynamic systembased models that represent complex interactions between physical processes in the atmosphere, ocean, cryosphere and land surface. These are currently the most advanced tools to estimate how the climate system may respond to the natural and human driven stresses (e.g., increasing in greenhouse gas emissions, population, and other behaviours).

There are various climate organizations that conduct climate change modelling research and share their projections to the Coupled Model Inter-comparison Project Phase 5 (CMIP5). CMIP5 is the official body of science used by the Intergovernmental Panel on Climate Change (IPCC), which is a United Nations body founded with the purpose of evaluating climate change science. There are currently twenty (20) different climate modelling organizations that lead the evolution of climate models, resulting in a large repository of models available for various applications.

It is important to note that because each GCM provides a slightly different conceptualization of the earth-atmosphere system, the IPCC recommends using an ensemble approach. An ensemble is a grouping of climate projections. Together, the models in an ensemble provide a better characterization of the future and its uncertainty than a single model used in isolation.

#### 2.1 Greenhouse Gas Emissions Scenarios

Future greenhouse gas (GHG) emissions are not known. Therefore, the IPCC developed four (4) Representative Concentration Pathways (RCPs) as part of a new initiative for the Fifth Assessment Reports (Taylor et al. 2012). These RCP scenarios move away from the Special Report on Emissions Scenarios<sup>1</sup> (SRES) (i.e. prescriptive GHG emissions scenarios) based on assumptions of socioeconomic scenarios (e.g., population growth, mitigation policy, and other prescriptive assumptions) and focus on representing the forcing which may be realized through a much broader set of socioeconomic scenarios while also incorporating carbon emission controls, which the previous iteration of scenarios (e.g., double CO<sub>2</sub>, and SRES scenarios) were criticized for not including in a more integrated manner. These RCPs were created with Integrated Assessment Models (IAM) which include climate, economic, land use, demographic, and energy-usage effects. The outputs of these IAMs, which estimate GHG concentrations, were then converted to an emission trajectory using carbon cycle models. The RCP scenarios 2.6, 4.5, 6.0 and 8.5 reflect various levels of climate change mitigation efforts (i.e. RCP 2.6, resulting in an increase of 2.6 W/m<sup>2</sup> in radiative forcing to the global climate system) and business-as-usual GHG emissions continuing (i.e. RCP 8.5, an increase of 8.5 W/m<sup>2</sup>).

For the purposes of this assessment, it is suggested that the Town of Oakville focus on projections for RCP 4.5 (a *moderate* emissions scenario that would require substantial reductions from current emission levels) and RCP 8.5 (business-as-usual). RCP 6.0 is not suggested for inclusion as it has been found to be very similar to RCP 4.5, which is deemed sufficient to represent the "medium" GHG scenario. Table 2-1 provides a description of each RCP scenario while Figure 2-1 illustrates the projected global warming associated with the four scenarios.




<sup>&</sup>lt;sup>1</sup> See Appendix G



#### Table 2-1 RCP Scenario Descriptions

| Scenario | Description   |
|----------|---|
| RCP 2.6  | Lowest projected GHG concentrations, resulting from dramatic climate change mitigation measures implemented globally. It represents an increase of 2.6 W/m <sup>2</sup> in radiative forcing to the climate system. |
| RCP 4.5  | Moderate projected GHG concentrations, resulting from substantial climate change mitigation measures. It represents an increase of 4.5 W/m <sup>2</sup> in radiative forcing to the climate system.                 |
| RCP 6.0  | Moderate projected GHG concentrations, resulting from some climate change mitigation measures. It represents an increase of 6.0 W/m <sup>2</sup> in radiative forcing to the climate system.                        |
| RCP 8.5  | Highest projected GHG concentrations, resulting from business-as-usual emissions. It represents an increase of 8.5 W/m <sup>2</sup> in radiative forcing to the climate system.                                     |

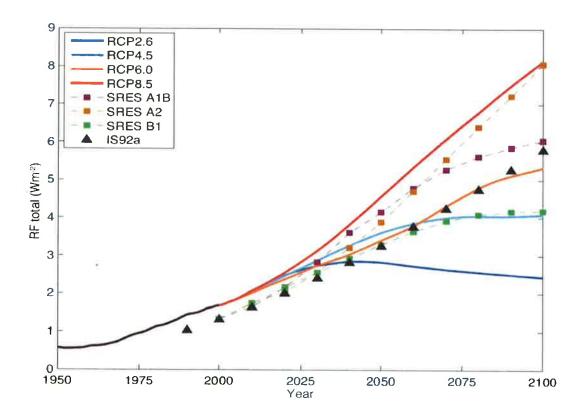

#### Figure 2-1 RCPs Used for Climate Modeling and Research

(Notes: Historical and projected total anthropogenic radiative forcing (W/m<sup>2</sup>) relative to preindustrial (about 1765) between 1950 and 2100. Previous IPCC assessments (SAR IS92a, TAR/ AR4 SRES A1B, A2 and B1) are compared with RCP scenarios.

(source: Cubasch et al (2013); Figure 1.15)





## Table 4-7 All Scenarios Summary – 5 Year and 100 Year 24 Hour Duration Events

|       | Rainfall Scenario / Representative Time Fram   | e         | Retur<br>5 year | n Period<br>100 year |       | Compa<br>kville Des<br>year | ign Eve |        |
|-------|--|-----------|-----------------|----------------------|-------|-----------------------------|---------|--------|
|       |  |           | (mm)            | (mm)                 | (mm)  | %                           | (mm)    | %      |
| Tow   | n of Oakville  | 1.00      |                 |                      |       |                             | 1       |        |
| 1     | IDF from Table 3.1 in the Design Guidelines  | 2018      | 60.0            | 98.4                 | 0.0   | 0                           | 0.0     | 0      |
| 2     | IDF as computed from Chicago Storm parameters<br>defined in Table 3.1 in the Design Guidelines | 2018      | 60.9            | 98.1                 | 0.9   | 1.5%                        | -0.3    | -0.3%  |
| 3     | #1 plus 15%  | 2050      | 69.0            | 113.2                | 9.0   | 15.0%                       | 14.8    | 15.0%  |
| 4     | #1 plus 20%  | 2050      | 72.0            | 118.1                | 12.0  | 20.0%                       | 19.7    | 20.0%  |
| 5     | #2 plus 15%  | 2080      | 70.0            | 112.8                | 10.0  | 16.7%                       | 14.4    | 14.6%  |
| 6     | #2 plus 20%  | 2080      | 73.1            | 117.7                | 13.1  | 21.8%                       | 19.3    | 19.6%  |
| Envi  | onment and Climate Change Canada   |           |                 |                      |       |                             |         |        |
| 7     | Toronto City IDF v1.0 and v2.0 (Gumbel)  | 2007/2010 | 59.5            | 95.5                 | -0.5  | -0.8%                       | -2.9    | -2.9%  |
| 8     | #7 - 95th percentile upper bound<br>(converted from intensity)                                 | 2007/2010 | 60.2            | 96.6                 | 0.2   | 0.3%                        | -1.8    | -1.8%  |
| 9     | #7 - 95th percentile lower bound<br>(converted from intensity)                                 | 2007/2010 | 59.8            | 95.4                 | -0.2  | -0.3%                       | -3.0    | -3.0%  |
| 10    | Toronto City IDF v2.3 (Gumbel)   | 2014      | 59.0            | 94.7                 | -1.0  | -1.7%                       | -3.7    | -3.8%  |
| 11    | #10 - 95th percentile upper bound<br>(converted from intensity)                                | 2014      | 60.2            | 94.2                 | 0.2   | 0.3%                        | -4.2    | -4.3%  |
| 12    | #10 - 95th percentile lower bound<br>(converted from intensity)                                | 2014      | 59.8            | 93.0                 | -0.2  | -0.3%                       | -5.4    | -5.5%  |
| Univ  | ersity of Western Ontario IDFCC Tool V2  |           |                 |                      |       |                             |         |        |
| 13    | Oakville Ensemble projection (Gumbel-RCP 2.6)  | 2050      | 64.8            | 103.2                | 4.8   | 8.0%                        | 4.8     | 4.9%   |
| 14    | Oakville Ensemble projection (Gumbel-RCP 4.5)  | 2050      | 64.8            | 103.2                | 4.8   | 8.0%                        | 4.8     | 4.9%   |
| 15    | Oakville Ensemble projection (Gumbel-RCP 8.5)  | 2050      | 62.4            | 100.8                | 2.4   | 4.0%                        | 2.4     | 2.4%   |
| 16    | Oakville Ensemble projection (Gumbel-RCP 2.6)  | 2080      | 65.8            | 104.2                | 5.8   | 9.7%                        | 5.8     | 5.9%   |
| 17    | Oakville Ensemble projection (Gumbel-RCP 4.5)  | 2080      | 67.2            | 109,9                | (7.2) | 12.0%                       | 11.5    | (11.7% |
| 18    | Oakville Ensemble projection (Gumbel-RCP 8.5)  | 2080      | 70.6            | 113.5                | 10.6  | 17.7%                       | 15.1    | 15.3%  |
| Unive | ersity of Western Ontario IDFCC Tool V3  |           | le-tr           |                      |       |                             |         |        |
| 19    | Toronto City - Base GEV  | 2010      | 58.3            | 101.8                | -1.7  | -2.8%                       | 3.4     | 3.5%   |
| 20    | Toronto City Ensemble projection (GEV-RCP 2.6)   | 2050      | 74.6            | 134.9                | 14.6  | 24.4%                       | 36.5    | 37.1%  |
| 21    | #20 - 25 <sup>th</sup> percentile upper bound (GEV-RCP 2.6)                                    | 2050      | 67.5            | 125.1                | 7.5   | 12.5%                       | 26.7    | 27.1%  |
| 22    | #20 - 75 <sup>th</sup> percentile lower bound (GEV-RCP 2.6)                                    | 2050      | 77.7            | 163.6                | 17,7  | 29.6%                       | 65.2    | 66.3%  |
| 23    | Toronto City Ensemble projection (GEV-RCP 2.6)   | 2080      | 71.2            | 134.5                | 11.2  | 18.6%                       | 36.1    | 36.7%  |
| 24    | #23 - 25 <sup>th</sup> percentile upper bound (GEV-RCP 2.6)                                    | 2080      | 69.6            | 125.6                | 9.6   | 16.0%                       | 27.2    | 27.7%  |
| 25    | #23 - 75 <sup>th</sup> percentile lower bound (GEV-RCP 2.6)                                    | 2080      | 78.6            | 149.1                | 18.6  | 31.0%                       | 50.7    | 51.6%  |
| 26    | Toronto City Ensemble projection (GEV-RCP 4.5)   | 2050      | 67.4            | 130.8                | 7.4   | 12.4%                       | 32.4    | 32.9%  |
| 27    | #26 - 25 <sup>th</sup> percentile upper bound (GEV-RCP 4.5)                                    | 2050      | 63.8            | 119.8                | 3.8   | 6.4%                        | 21.4    | 21.8%  |
| 28    | #26 - 75 <sup>th</sup> percentile lower bound (GEV-RCP 4.5)                                    | 2050      | 78.3            | 154.5                | 18.3  | 30.5%                       | 56.1    | 57.0%  |
| 29    | Toronto City Ensemble projection (GEV-RCP 4.5)   | 2080      | 78.2            | 149.0                | 18.2  | 30.3%                       | 50.6    | 51.4%  |
| 30    | #29 - 25 <sup>th</sup> percentile upper bound (GEV-RCP 4.5)                                    | 2080      | 66.0            | 118.9                | 6.0   | 10.0%                       | 20.5    | 20.9%  |
| 31    | #29 - 75 <sup>th</sup> percentile lower bound (GEV-RCP 4.5)                                    | 2080      | 82.5            | 179.3                | 22.5  | 37.5%                       | 80.9    | 82.2%  |
| 32    | Toronto City Ensemble projection (GEV-RCP 8.5)   | 2050      | 71.3            | 139.2                | 11.3  | 18.9%                       | 40.8    | 41.5%  |
| 33    | #33 - 25 <sup>th</sup> percentile upper bound (GEV-RCP 8.5)                                    | 2050      | 68.5            | 128.0                | 8.5   | 14.2%                       | 29.6    | 30.1%  |
| 34    | #33 - 75 <sup>th</sup> percentile lower bound (GEV-RCP 8.5)                                    | 2050      | 76.6            | 159,3                | 16.6  | 27.7%                       | 60.9    | 61.9%  |
| 35    | Toronto City Ensemble projection (GEV-RCP 8.5)   | 2080      | 80.0            | 145.0                | 20.0  | 33.3%                       | 46.6    | 47.4%  |



# wood.

|    | All Scenarios 5 Year and 100 Year 24 Ho  | ur Durati | on Ever | nts Comp | ariso   | n – Rain | fall De  | epth   |
|----|--|-----------|---------|----------|---|----------|----------|--------|
| 1  | Rainfall Scenario / Representative Time Fram   |           | Retur   | n Period | Comparison with<br>Oakville Design Event (#1) |          |          |        |
|    | Kannan Scenario / Kepresentative Time Fram   | e         | 5 year  | 100 year | 5 year  |          | 100 year |        |
|    | and the second |           | (mm)    | (mm)     | (mm) %  |          | (mm) %   |        |
| 36 | #35 - 25 <sup>th</sup> percentile upper bound (GEV-RCP 8.5)  | 2080      | 75.2    | 14 0.6   | 15.2  | 25.3%    | 42.2     | 42.9%  |
| 37 | #35 - 75 <sup>th</sup> percentile lower bound (GEV-RCP 8.5)  | 2080      | 85.9    | 173.9    | 25.9  | 43.1%    | 75.5     | 76.7%  |
| 38 | Oakville Ensemble projection (GEV-RCP 2.6)   | 2050      | 88.5    | 244.8    | 28.5  | 47.5%    | 146.4    | 148.8% |
| 39 | #38 - 25 <sup>th</sup> percentile upper bound (GEV-RCP 2.6)  | 2050      | 83.2    | 191.0    | 23.2  | 38.7%    | 92.6     | 94.1%  |
| 40 | #38 - 75 <sup>th</sup> percentile lower bound (GEV-RCP 2.6)  | 2050      | 95.3    | 277.5    | 35.3  | 58.9%    | 179.1    | 182.0% |
| 41 | Oakville Ensemble projection (GEV-RCP 2.6)   | 2080      | 86.6    | 221.3    | 26.6  | 44.4%    | 122.9    | 124.9% |
| 42 | #41 - 25 <sup>th</sup> percentile upper bound (GEV-RCP 2.6)  | 2080      | 81.8    | 195.7    | 21.8  | 36.4%    | 97.3     | 98.8%  |
| 43 | #41 - 75 <sup>th</sup> percentile lower bound (GEV-RCP 2.6)  | 2080      | 94.9    | 244.8    | 34.9  | 58.1%    | 146.4    | 148.8% |
| 44 | Oakville Ensemble projection (GEV-RCP 4.5)   | 2050      | 78.5    | 213.4    | 18.5  | 30.8%    | 115.0    | 116.9% |
| 45 | #44 - 25 <sup>th</sup> percentile upper bound (GEV-RCP 4.5)  | 2050      | 74.5    | 200.4    | 14.5  | 24.2%    | 102.0    | 103.7% |
| 46 | #44 - 75 <sup>th</sup> percentile lower bound (GEV-RCP 4.5)  | 2050      | 96.1    | 233.3    | 36.1  | 60.1%    | 134.9    | 137.1% |
| 47 | Oakville Ensemble projection (GEV-RCP 4.5)   | 2080      | 95.1    | 246.8    | 35.1  | 58.5%    | 148.4    | 150.8% |
| 48 | #47 - 25 <sup>th</sup> percentile upper bound (GEV-RCP 4.5)  | 2080      | 78.7    | 208.0    | 18.7  | 31.1%    | 109.6    | 111.4% |
| 49 | #47 - 75 <sup>th</sup> percentile lower bound (GEV-RCP 4.5)  | 2080      | 100.9   | 276.3    | 40.9  | 68.2%    | 177.9    | 180.8% |
| 50 | Oakville Ensemble projection (GEV-RCP 8.5)   | 2050      | 87.1    | 214.1    | 27.1  | 45.2%    | 115.7    | 117.5% |
| 51 | #50 - 25 <sup>th</sup> percentile upper bound (GEV-RCP 8.5)  | 2050      | 80.6    | 205.3    | 20.6  | 34.3%    | 106.9    | 108.6% |
| 52 | #50 - 75 <sup>th</sup> percentile lower bound (GEV-RCP 8.5)  | 2050      | 93.7    | 235.9    | 33.7  | 56.2%    | 137.5    | 139.7% |
| 53 | Oakville Ensemble projection (GEV-RCP 8.5)   | 2080      | 96.0    | 254.6    | 36.0  | 59.9%    | 156.2    | 158.8% |
| 54 | #53 - 25 <sup>th</sup> percentile upper bound (GEV-RCP 8.5)  | 2080      | 90.1    | 232.8    | 30.1  | 50.2%    | 134.4    | 136.6% |
| 55 | #53 - 75 <sup>th</sup> percentile lower bound (GEV-RCP 8.5)  | 2080      | 107.6   | 270.6    | 47.6  | 79.3%    | 172.2    | 175.0% |
|    | io Climate Change Data Portal  |           |         |          |   |          |          |        |
| 56 | Toronto City grid SRES A1B / Gumbel (Mean)   | 2050      | 100.8   | 177.6    | 40.8  | 68.0%    | 79.2     | 80.5%  |
| 57 | #56 - 30 <sup>th</sup> percentile  | 2050      | 86.4    | 136.8    | 26.4  | 44.0%    | 38.4     | 39.0%  |
| 58 | #56 - 70 <sup>th</sup> percentile  | 2050      | 100.8   | 182.4    | 40.8  | 68.0%    | 84.0     | 85.4%  |
| 59 | #56 - 90 <sup>th</sup> percentile  | 2050      | 110.4   | 204.0    | 50.4  | 84.0%    | 105.6    | 107.3% |
| 60 | Toronto City grid SRES A1B / Gumbel (Mean)   | 2080      | 110.4   | 192.0    | 50.4  | 84.0%    | 93.6     | 95.1%  |
| 61 | #60 - 30 <sup>th</sup> percentile  | 2080      | 100.8   | 175.2    | 40.8  | 68.0%    | 76.8     | 78.0%  |
| 62 | #60 - 70 <sup>th</sup> percentile  | 2080      | 117.6   | 216.0    | 57.6  | 96.0%    | 117.6    | 119.5% |
| 63 | #60 - 90 <sup>th</sup> percentile  | 2080      | 127.2   | 235.2    | 67.2  | 112.0%   | 136.8    | 139.0% |
| 64 | Oakville grid SRES A1B / Gumbel (Mean)   | 2050      | 98.4    | 170.4    | 38.4  | 64.0%    | 72.0     | 73.2%  |
| 65 | #64 - 30 <sup>th</sup> percentile  | 2050      | 91.2    | 146.4    | 31.2  | 52.0%    | 48.0     | 48.8%  |
| 66 | #64 - 70 <sup>th</sup> percentile  | 2050      | 100.8   | 175.2    | 40.8  | 68.0%    | 76.8     | 78.0%  |
| 67 | #64 - 90 <sup>th</sup> percentile  | 2050      | 100.8   | 187.2    | 40.8  | 68.0%    | 88.8     | 90.2%  |
| 68 | Oakville grid SRES A1B / Gumbel (Mean)   | 2080      | 90.0    | 160.8    | 30.0  | 50.0%    | 62.4     | 63.4%  |
| 69 | #68 - 30 <sup>th</sup> percentile  | 2080      | 89.8    | 155.5    | 29.8  | 49.6%    | 57.1     | 58.0%  |
| 70 | #68 - 70 <sup>th</sup> percentile  | 2080      | 91.0    | 173.5    | 31.0  | 51.6%    | 75.1     | 76.3%  |
| 71 | #68 - 90 <sup>th</sup> percentile  | 2080      | 108.0   | 196.8    | 48.0  | 80.0%    | 98.4     | 100.0% |
|    | rending Tool   |           |         |          | 1.1   |          |          |        |
| 72 | Toronto City: Base   | 2010      | 74.4    | 124.8    | 14.4  | 24.0%    | 26.4     | 26.8%  |
| 73 | #72 - 5th percentile   | 2010      | 57.6    | 84.0     | -2.4  | -4.0%    | -14.4    | -14.6% |
| 74 | #72 - 95th percentile  | 2010      | 91.2    | 165.6    | 31.2  | 52.0%    | 67.2     | 68.3%  |
| 75 | Toronto City +15%  | 2050      | 85.6    | 143.5    | 25.6  | 42.6%    | 45.1     | 45.9%  |
| 76 | #75 - 5th percentile   | 2050      | 66.2    | 96.6     | 6.2   | 10.4%    | -1.8     | -1.8%  |
| 77 | #75 - 95th percentile  | 2050      | 104.9   | 190.4    | 44.9  | 74.8%    | 92.0     | 93.5%  |
| 78 | Toronto City +20%  | 2080      | 89.3    | 149.8    | 29.3  | 48.8%    | 51.4     | 52.2%  |





|    | Rainfall Scenario / Representative Time Frame | Retur           | Return Period |        | Comparison with<br>Oakville Design Event (#1) |          |       |        |
|----|---|-----------------|---------------|--------|---|----------|-------|--------|
|    | Kannan Scenario / Kepresentative Time Frame   | 5 year 100 year |               | 5 year |   | 100 year |       |        |
|    |   | 100             | (mm)          | (mm)   | (mm)  | %        | (mm)  | %      |
| 79 | #78 - 5th percentile                          | 2080            | 69.1          | 100.8  | 9.1   | 15.2%    | 2.4   | 2.4%   |
| 80 | #78 - 95th percentile                         | 2080            | 109.4         | 198.7  | 49.4  | 82.4%    | 100.3 | 102.0% |
| 81 | Oakville: Base                                | 2010            | 74.4          | 122.4  | 14.4  | 24.0%    | 24.0  | 24.4%  |
| 82 | #81 - 5th percentile                          | 2010            | 57.6          | 84.0   | -2.4  | -4.0%    | -14.4 | -14.6% |
| 83 | #81 - 95th percentile                         | 2010            | 91.2          | 160.8  | 31.2  | 52.0%    | 62.4  | 63.4%  |
| 84 | Oakville + 15%                                | 2050            | 85.6          | 140.8  | 25.6  | 42.6%    | 42.4  | 43.0%  |
| 85 | #84 - 5th percentile                          | 2050            | 66.2          | 96.6   | 6.2   | 10.4%    | -1.8  | -1.8%  |
| 86 | #84 - 95th percentile                         | 2050            | 104.9         | 184.9  | 44.9  | 74.8%    | 86.5  | 87.9%  |
| 87 | Oakville + 20%                                | 2080            | 89.3          | 146.9  | 29.3  | 48.8%    | 48.5  | 49.3%  |
| 88 | #87 - 5th percentile                          | 2080            | 69.1          | 100.8  | 9.1   | 15.2%    | 2.4   | 2.4%   |
| 89 | #87 - 95th percentile                         | 2080            | 109.4         | 193.0  | 49.4  | 82,4%    | 94.6  | 96.1%  |

of statistical analysis.

## Table 4-8 All Scenarios Statistical Analysis – 5 Year and 100 Year 24 Hour Duration Events

| Return Period  | Minimum   | 25 <sup>th</sup><br>percentile | Median       | Average     | 75 <sup>th</sup><br>percentile | 90 <sup>th</sup><br>percentile | Maximun |
|--|-----------|--------------------------------|--------------|-------------|--------------------------------|--------------------------------|---------|
|  |           |                                |              | Present Day |                                |                                |         |
| 5 Year<br>(Oakville Design Event 60.0 mm)  | 57.6      | 59.3                           | 60.0         | 65.6        | 67.7                           | 84.5                           | 91.2    |
| 100 Year<br>(Oakville Design Event 98.4 mm)  | 84.0      | 94.5                           | 96.6         | 107.3       | 112.1                          | 146.4                          | 165.6   |
|  |           |                                |              | 2050s       |                                |                                |         |
| 5 Year   | 62.4      | 69.0                           | 80.6         | 82.6        | 95.3                           | 100.8                          | 110.4   |
| 100 Year   | 96.6      | 128.0                          | 159.3        | 163.2       | 191.0                          | 221.8                          | 277.5   |
|  |           |                                |              | 2080s       |                                |                                |         |
| 5 Year   | 65.8      | 73.1                           | 86.6         | 87.5        | 96.0                           | 109.4                          | 127.2   |
| 100 Year   | 100.8     | 145.5                          | 174.5        | 179.0       | 214.0                          | 246.2                          | 276.3   |
|  | Deviation | from the Ave                   | erage (as no | ted above)  |                                |                                |         |
| 5 Year   | -12%      | -10%                           | -9%          | 0%          | 3%                             | 29%                            | 39%     |
| 100 Year   | -22%      | -12%                           | -10%         | 0%          | 4%                             | 36%                            | 54%     |
| and the second |           |                                |              | 2050s       |                                |                                |         |
| 5 Year   | -24%      | -16%                           | -2%          | 0%          | 15%                            | 22%                            | 34%     |
| 100 Year   | -41%      | -22%                           | -2%          | 0%          | 17%                            | 36%                            | 70%     |
|  |           |                                |              | 2080s       |                                |                                |         |
| 5 Year   | -25%      | -16%                           | -1%          | 0%          | 10%                            | 25%                            | 45%     |
| 100 Year   | -44%      | -19%                           | -2%          | 0%          | 20%                            | 38%                            | 54%     |





As well, Table 4-14 provides a summary of possible rainfall options, based on the GEV RCP 8.5 based approach, which should be given consideration as the basis for stress testing infrastructure design, where the GEV based estimates are conservative by comparison to the estimates provided in Table 4-13.

| Return Period                               | Minimum       | 25 <sup>th</sup><br>Percentile | Median | Average | 75 <sup>th</sup><br>Percentile | 90 <sup>th</sup><br>Percentile | Maximum |  |  |  |
|---|---------------|--------------------------------|--------|---------|--------------------------------|--------------------------------|---------|--|--|--|
|   | Present Day   |                                |        |         |                                |                                |         |  |  |  |
| 5 Year<br>(Oakville Design Event 60.0 mm)   | 58.3          | 59.5                           | 59.8   | 59.7    | 60.2                           | 60.3                           | 60.9    |  |  |  |
| 100 Year<br>(Oakville Design Event 98.4 mm) | 93.0          | 94.7                           | 95.5   | 96.4    | 98.1                           | 99.1                           | 101.8   |  |  |  |
|   | 2050s RCP 4.5 |                                |        |         |                                |                                |         |  |  |  |
| 5 Year                                      | 64.8          | 66.9                           | 69.5   | 76.8    | 81.7                           | 95.3                           | 104.9   |  |  |  |
| 100 Year                                    | 96.6          | 105.6                          | 113.0  | 126.6   | 135.9                          | 167.0                          | 190.4   |  |  |  |
| a change of the second second               |               | 2080s RCP 4.5                  |        |         |                                |                                |         |  |  |  |
| 5 Year                                      | 67.2          | 69.8                           | 72.6   | 80.0    | 85.3                           | 99.4                           | 109.4   |  |  |  |
| 100 Year                                    | 100.6         | 111.9                          | 117.9  | 132.5   | 141.9                          | 174.3                          | 198.7   |  |  |  |
|   | 2050s RCP 8.5 |                                |        |         |                                |                                | 1 47    |  |  |  |
| 5 Year                                      | 62.4          | 66.9                           | 69.5   | 76.4    | 81.7                           | 95.2                           | 104.9   |  |  |  |
| 100 Year                                    | 96.6          | 103.8                          | 113.0  | 126.2   | 135.9                          | 167.0                          | 190.4   |  |  |  |
|   | 2080s RCP 8.5 |                                |        |         |                                |                                | 223.3   |  |  |  |
| 5 Year                                      | 69.1          | 71.0                           | 72.5   | 80.6    | 85.2                           | 99.4                           | 109.4   |  |  |  |
| 100 Year                                    | 100.8         | 125.3                          | 149.8  | 149.8   | 174.2                          | 188.9                          | 198.7   |  |  |  |

#### Table 4-13 Screened Scenarios Statistical Analysis – Summary

#### Table 4-14 2050 and 2080 GEV Scenarios Summary

|              | Rainfall Depth Estimates based on the University of Western Ontario IDFCC Tool V3 |       |                                |                                |       |                                |  |  |  |  |  |
|--------------|---|-------|--------------------------------|--------------------------------|-------|--------------------------------|--|--|--|--|--|
| Toronto City |   | 2050  |                                | 2080                           |       |                                |  |  |  |  |  |
| Station      | 25 <sup>th</sup><br>Percentile  | Mean  | 75 <sup>th</sup><br>Percentile | 25 <sup>th</sup><br>Percentile | Mean  | 75 <sup>th</sup><br>Percentile |  |  |  |  |  |
|              |   |       | RCP 4.5                        |                                |       |                                |  |  |  |  |  |
| 5 year       | 63.8  | 67.4  | 78.3                           | 66.0                           | 78.2  | 82.5                           |  |  |  |  |  |
| 100 year     | 119.8   | 130.8 | 154.5                          | 118.9                          | 149.0 | 179,3                          |  |  |  |  |  |
|              |   |       | RCP 8.5                        |                                |       |                                |  |  |  |  |  |
| 5 year       | 68.5  | 71.3  | 76.6                           | 75.2                           | 80.0  | 85.9                           |  |  |  |  |  |
| 100 year     | 128.0   | 139.2 | 159.3                          | 140.6                          | 145.0 | 173.9                          |  |  |  |  |  |

